

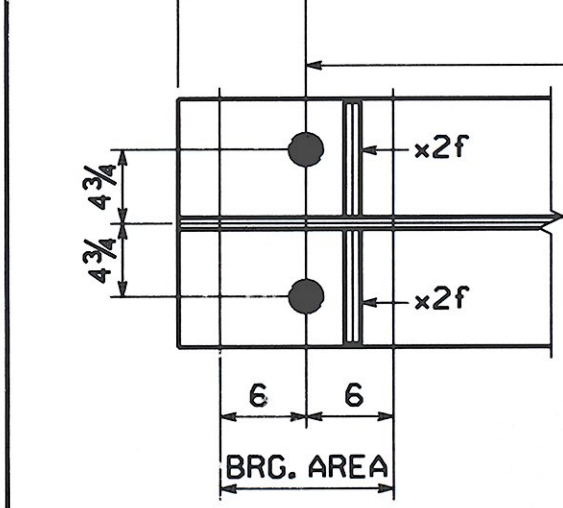
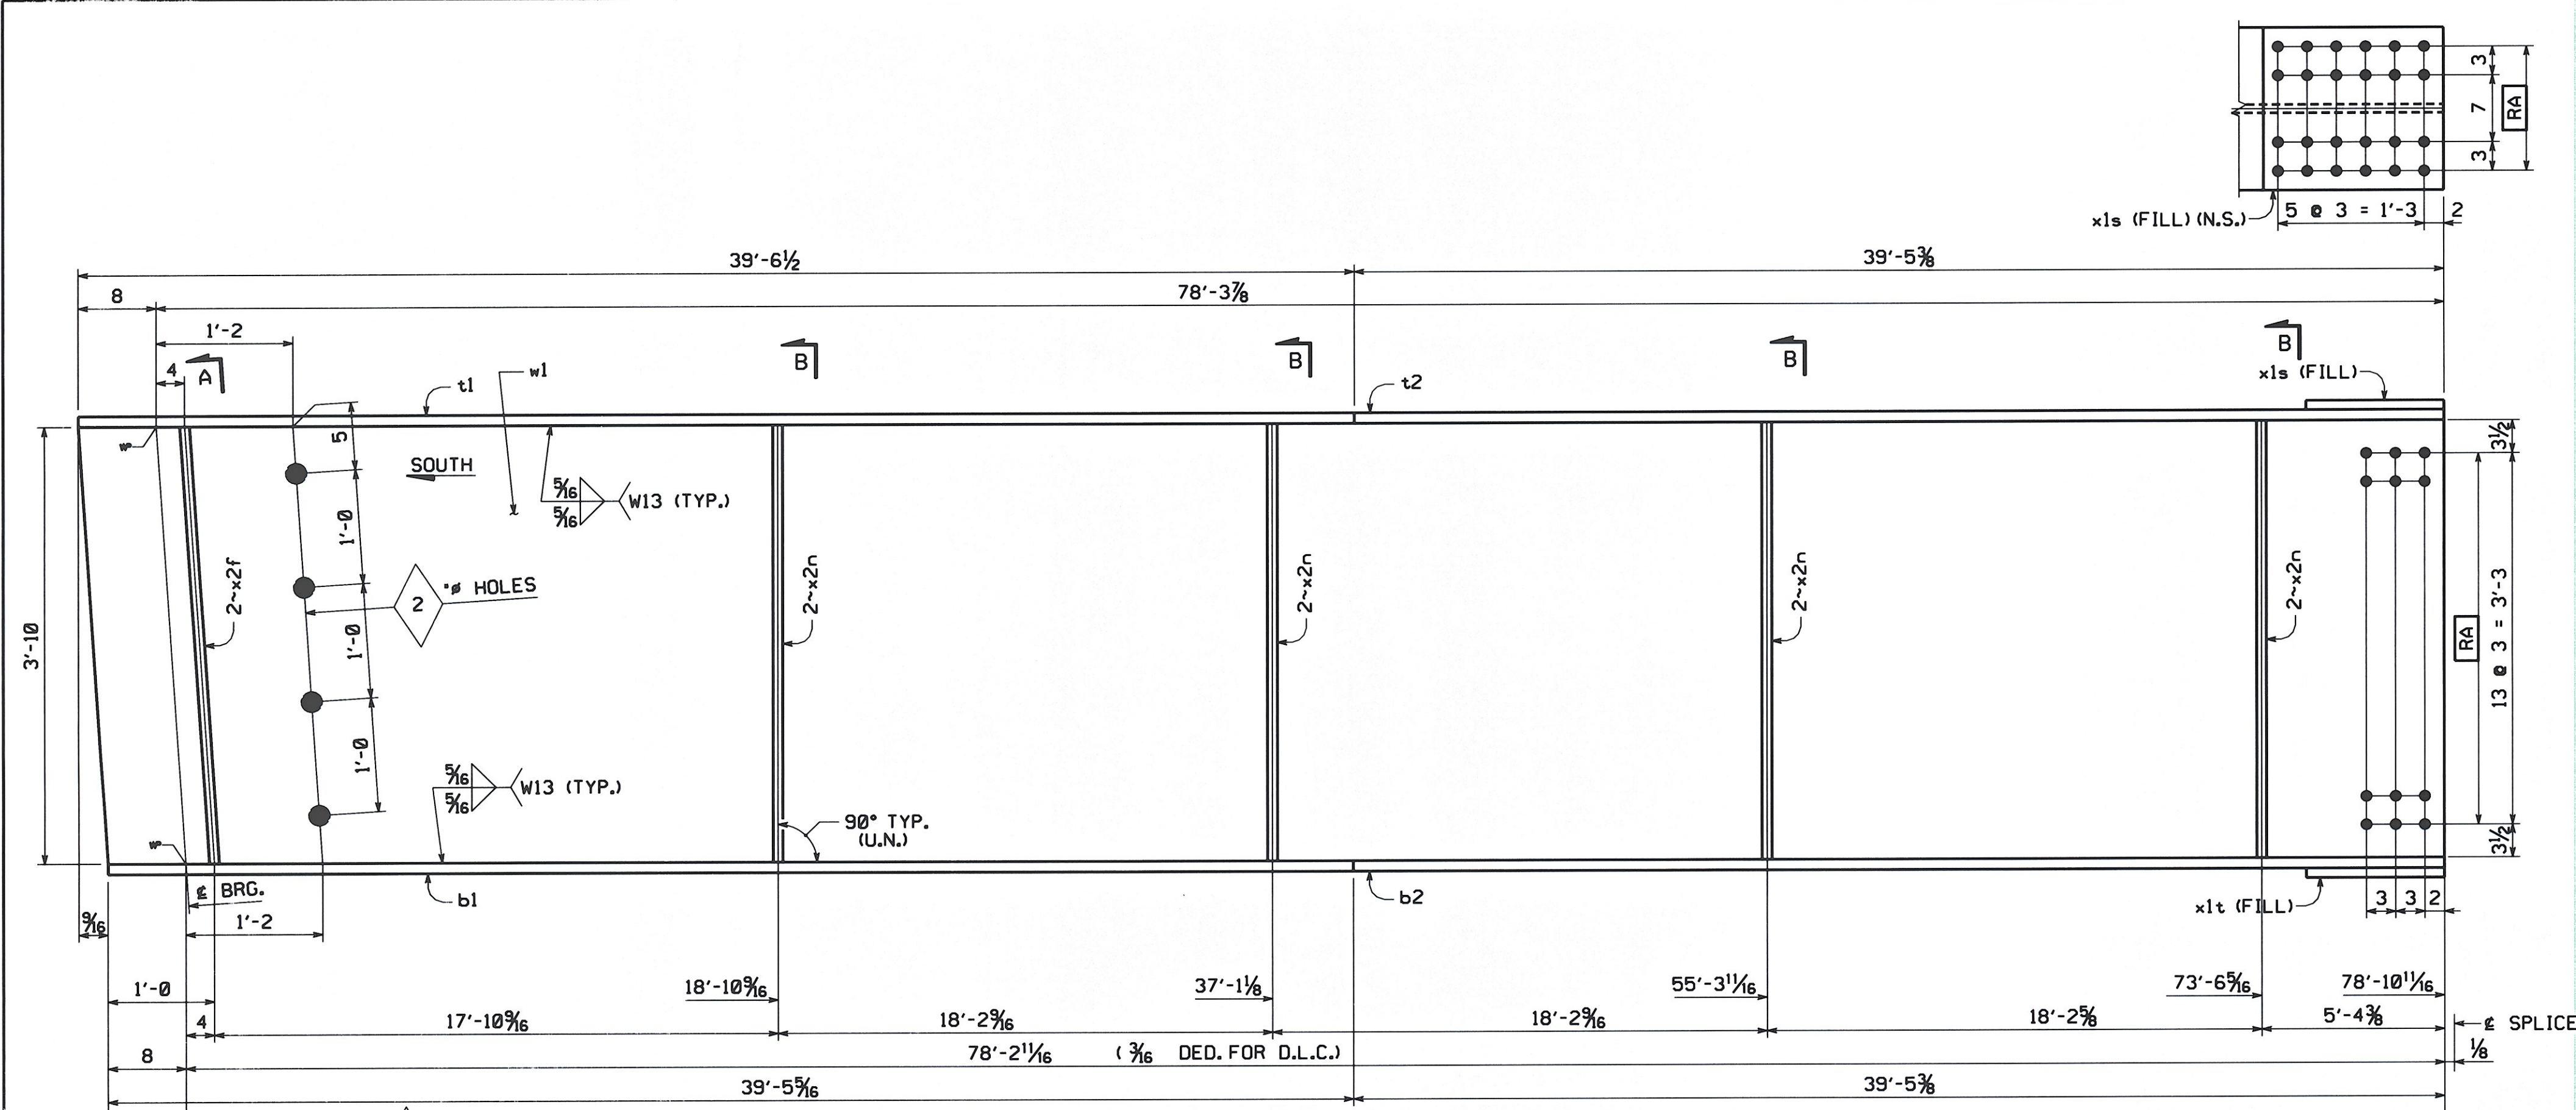
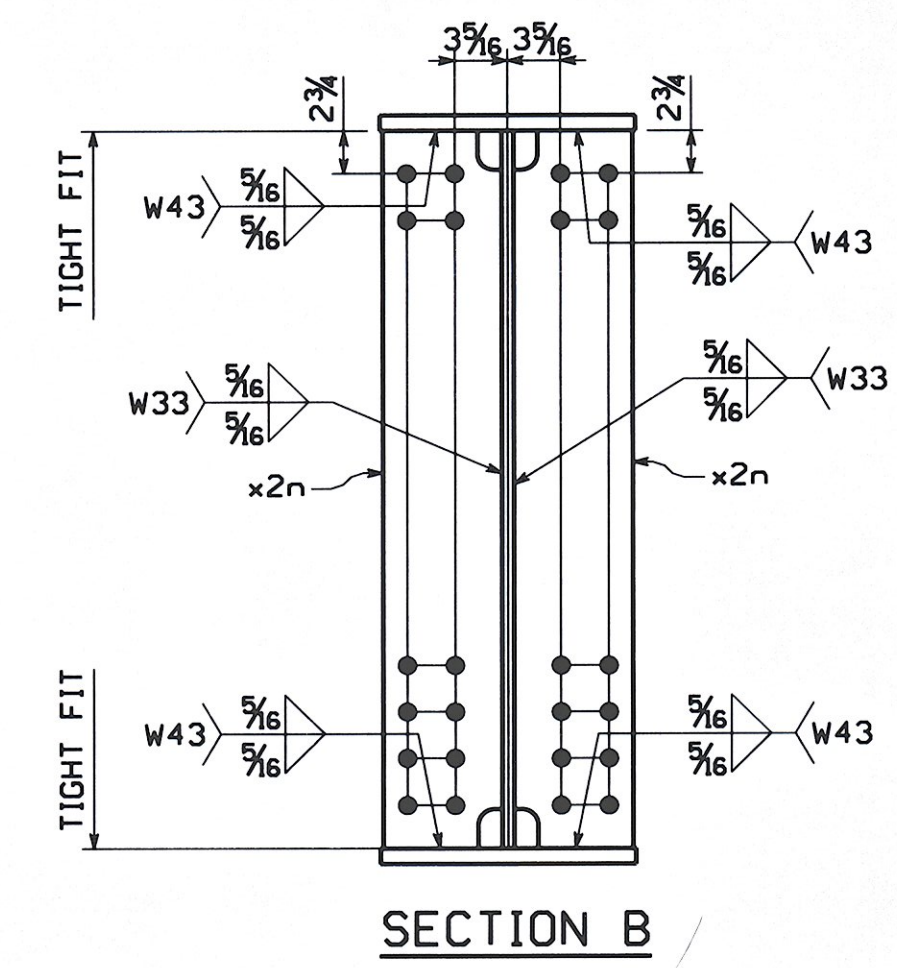



ENGLISH

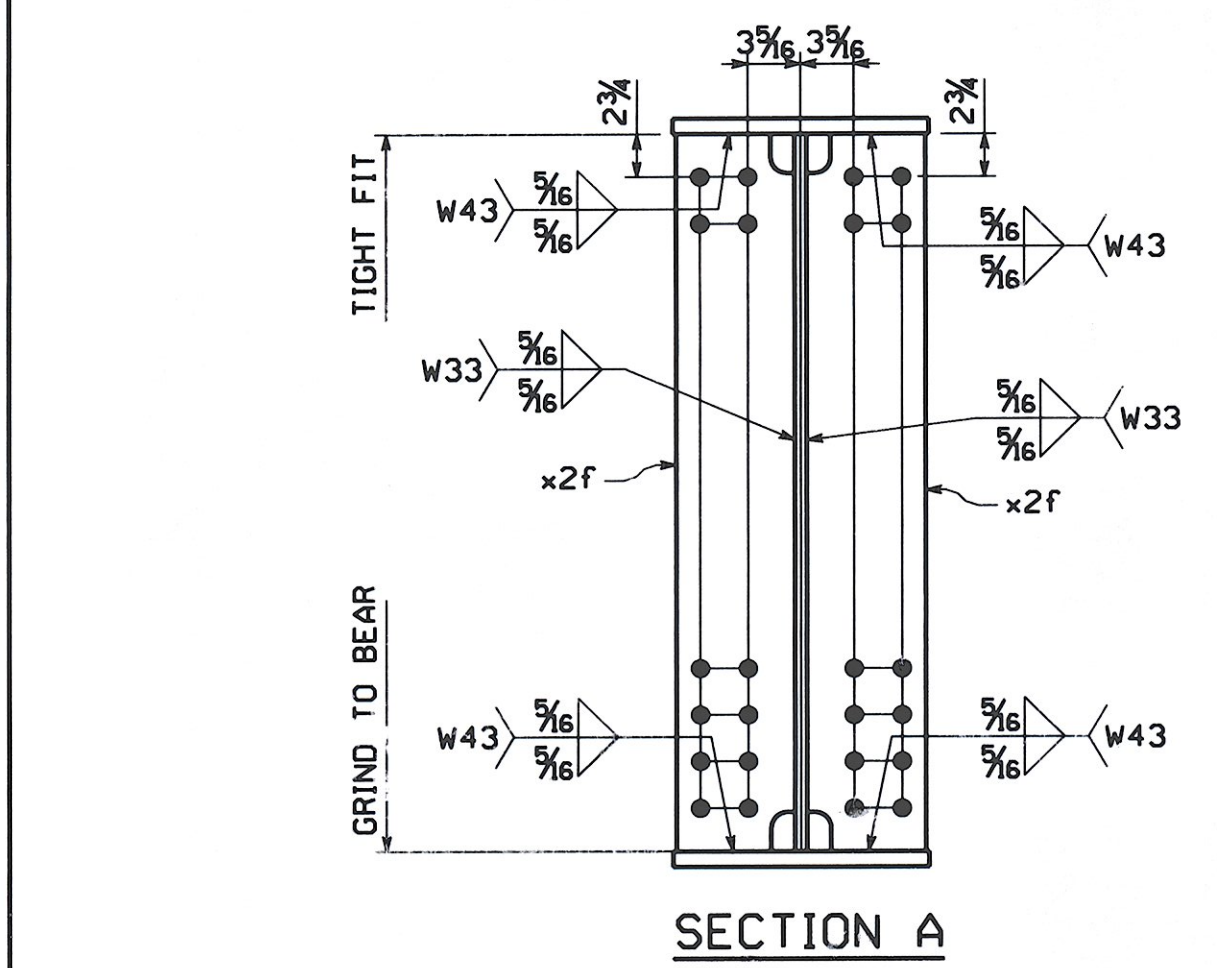

GIRDER ~ MK. G4A
 FOR GENERAL SHOP NOTES, SEE DWG. GNI.
 FOR WEB CAMBER DIAGRAM, SEE DWG. WCI.
 FOR HORIZ. CURVE DIAGRAM, SEE DWG. HCI.

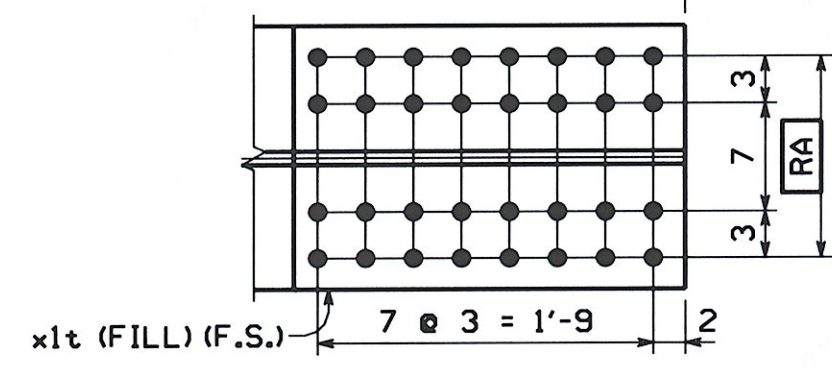

BILL OF MATERIAL													
QTY EA	MARK	COMM	DESCRIPTION	LENGTH	SPEC	GRADE	TEST	REMARKS	ITEM	GROSS WEIGHT EA	DEDUCTED WEIGHT EA	SHIP WT EA (LBS)	
1	G4A		GIRDER							19,148.40	5.03	19,148.40	
1	w1	PL	5/8 x 46	78 11 7/8	M270	50W	T		03004	7,727.54	5.03	7,722.51	
1	t1	PL	1 x 16	39 6 1/2	M270	50W	T		04009	2,152.82	0.00	2,152.82	
1	t2	PL	1 x 16	39 5 3/8	M270	50W	T		04009	2,147.72	0.00	2,147.72	
1	b1	PL	1 1/2 x 16	39 5 5/16	M270	50W	T		04005	3,221.15	0.00	3,221.15	
1	b2	PL	1 1/2 x 16	39 5 3/8	M270	50W	T		04005	3,221.58	0.00	3,221.58	
1	x1s	PL	1 x 16	1 6 1/2	M270	50W	T	FILL PL	06009	83.94	0.00	83.94	
1	x1t	PL	1/2 x 16	2 0 1/2	M270	50W	T	FILL PL	06010	55.58	0.00	55.58	
2	x2f	PL	3/4 x 7 1/2	3 10	M270	50W	T		07002	73.37	0.00	73.37	
8	x2n	PL	1/2 x 7 1/2	3 10	M270	50W	T		07004	48.91	0.00	48.91	
TOTAL WEIGHT THIS SHEET:										19148.40 lbs.			

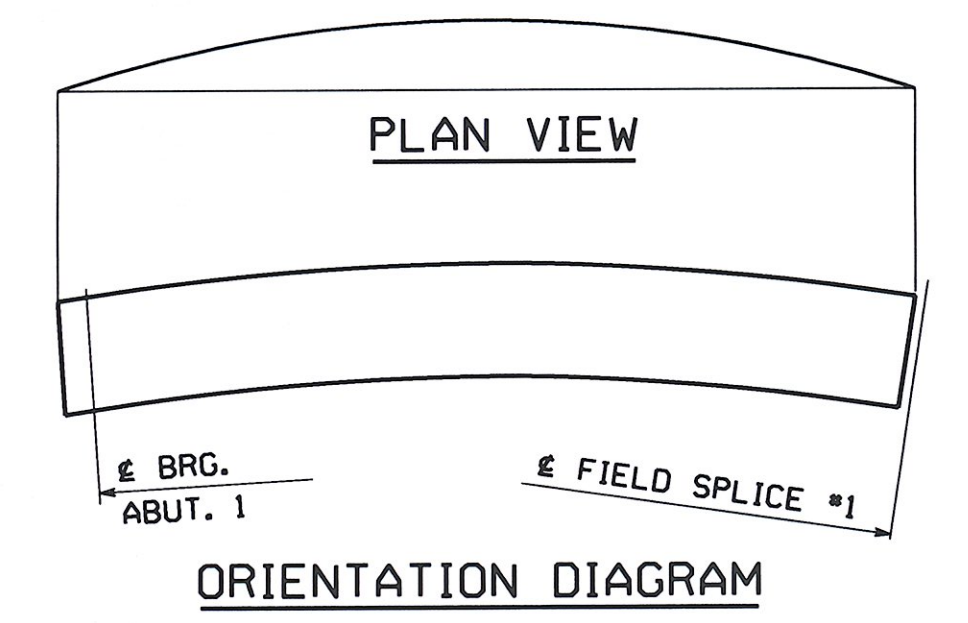

NO.	REVISION	BY	CHK'D	DATE

Holes 1 5/16" (U.N.)	Bolts NONE	Coating NONE	Code(s) 30	Scale N.T.S.	State Cont. or Ref. No. VT ROUTE 100 STA. 141+39.00 TO STA. 143+61.00	Fed. Aid Proj. No. 013-4(21)	Project No. (STP) BRF WINTerset, INC.	HSS Proj. Mgr DEB KUPRES	Project Number S-1080077	HSS Struct. ID A	Drawing Number 4 OF 22
-------------------------	---------------	-----------------	---------------	-----------------	--	---------------------------------	--	-----------------------------	-----------------------------	---------------------	---------------------------

RECEIVED
 CK'D BY [Signature] OK'D BY [Signature]
 AUG 18 2008
 RESUBMIT APPROVED [Signature]
 BY KmH DATE 8/19/08

SHIPMENT 01
 PM:ENG, 5004327 PRD: 5004328 SHIPRECT: 5004329
 BY: McCreidel
 PLOTTED: 6/25/2008 3:38:49 PM