

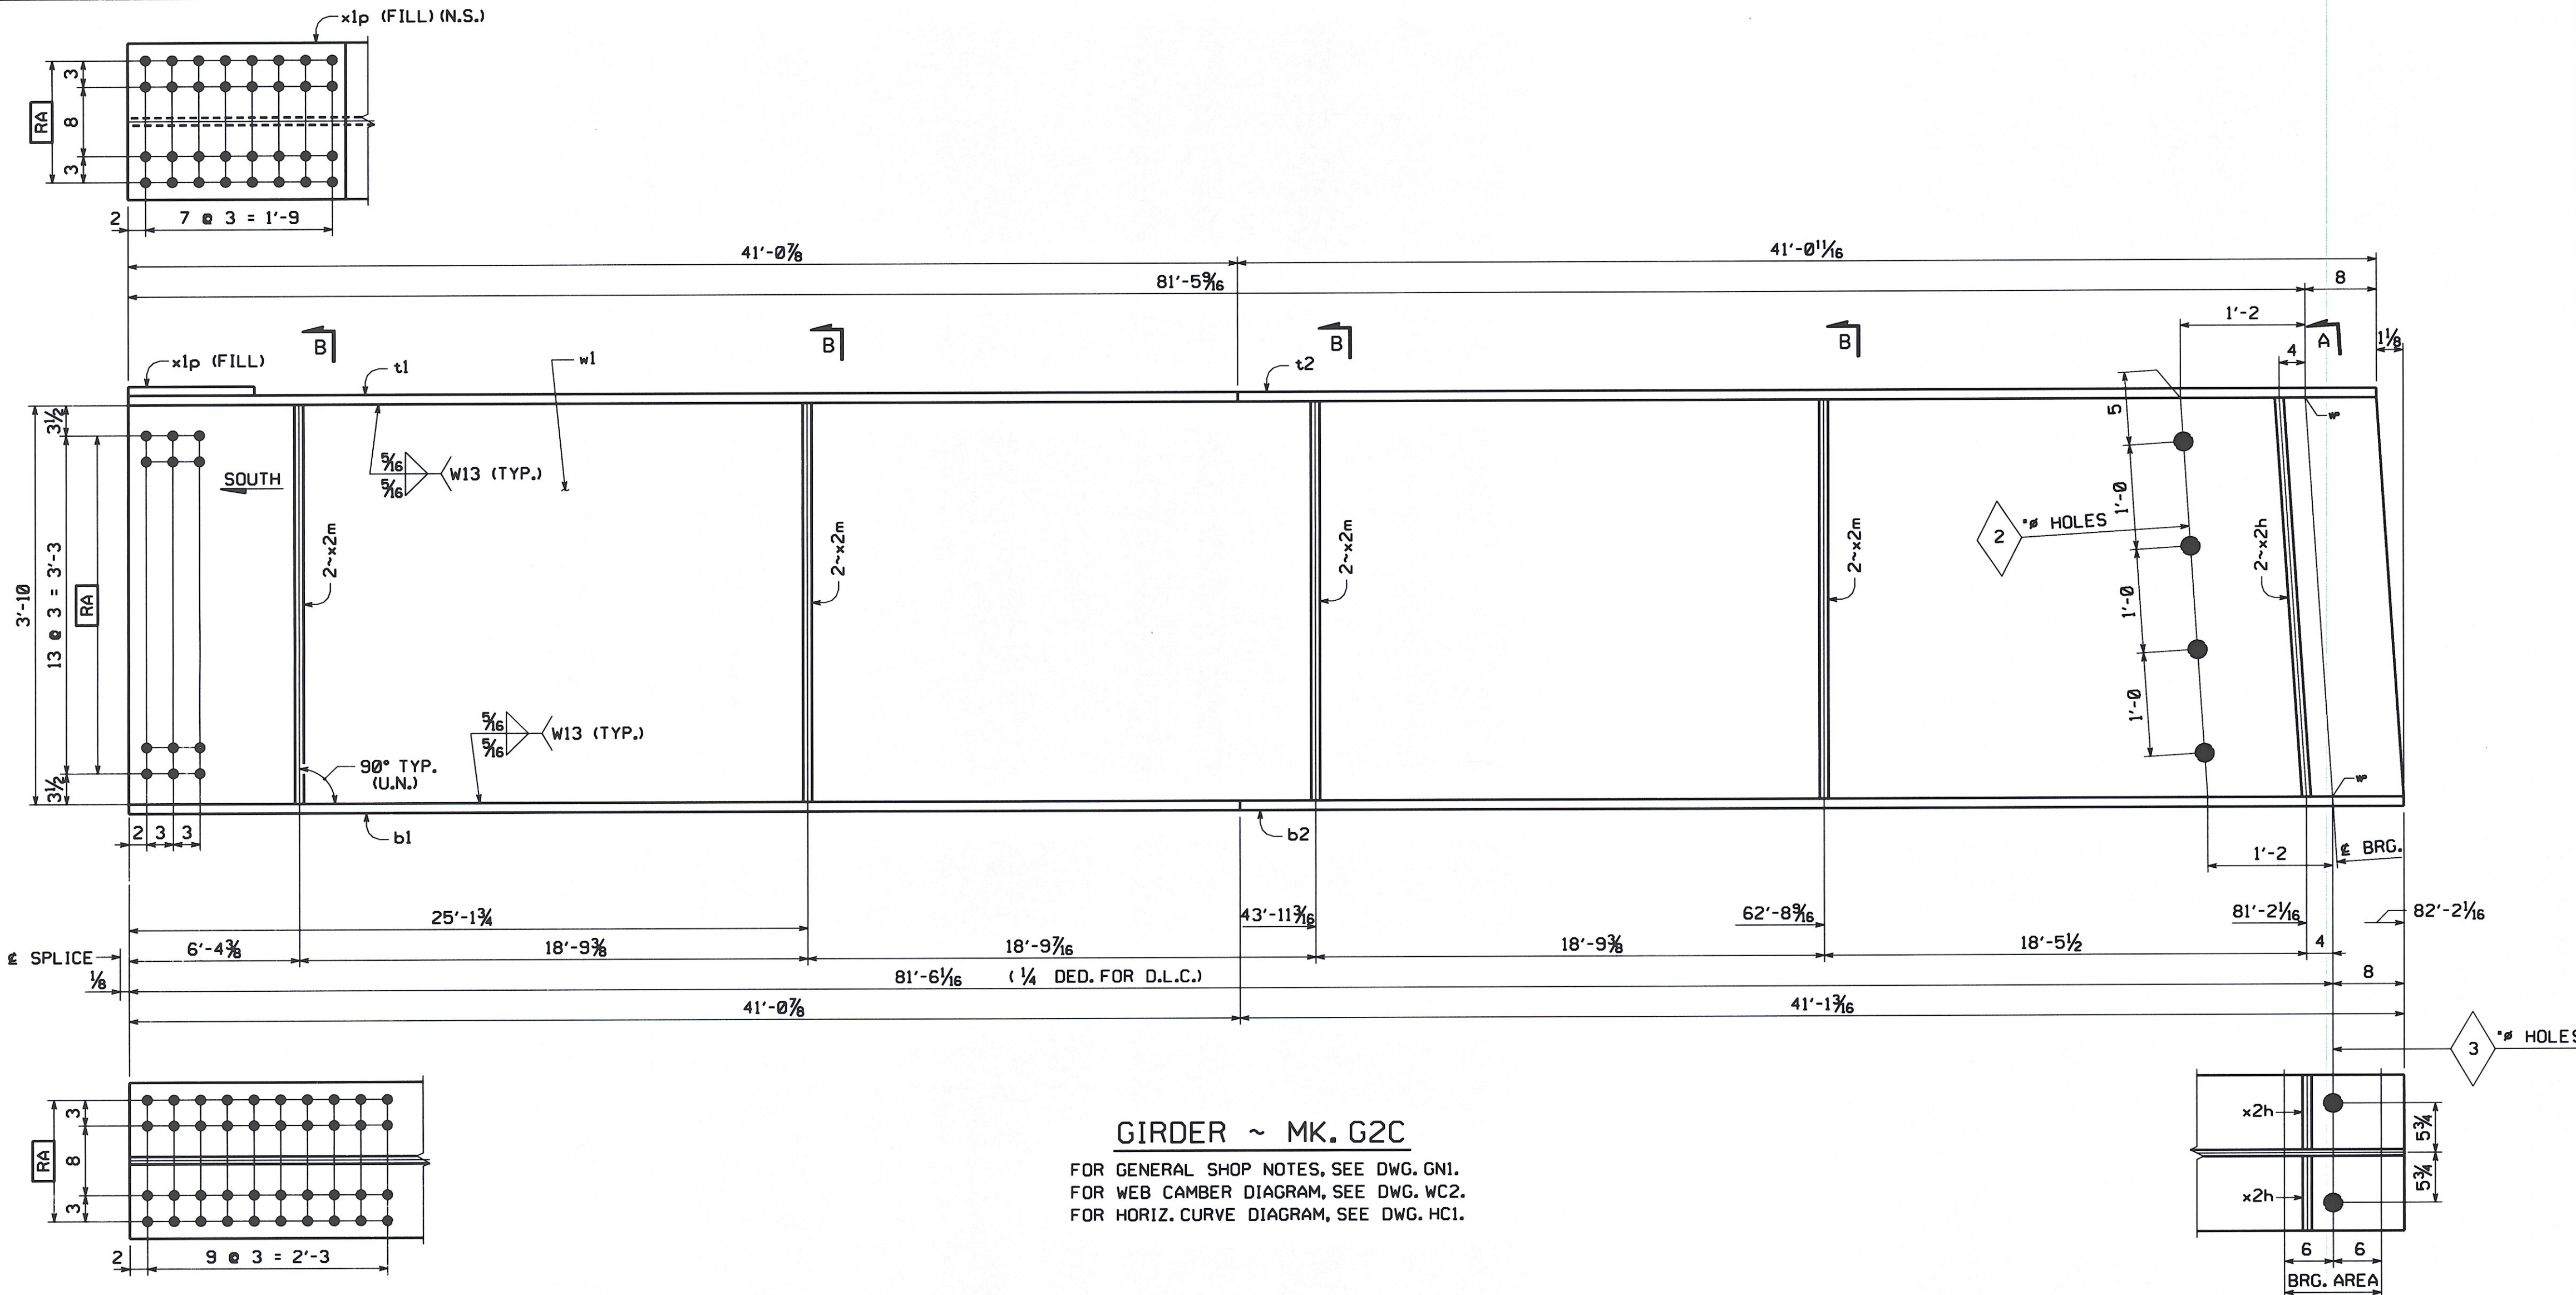
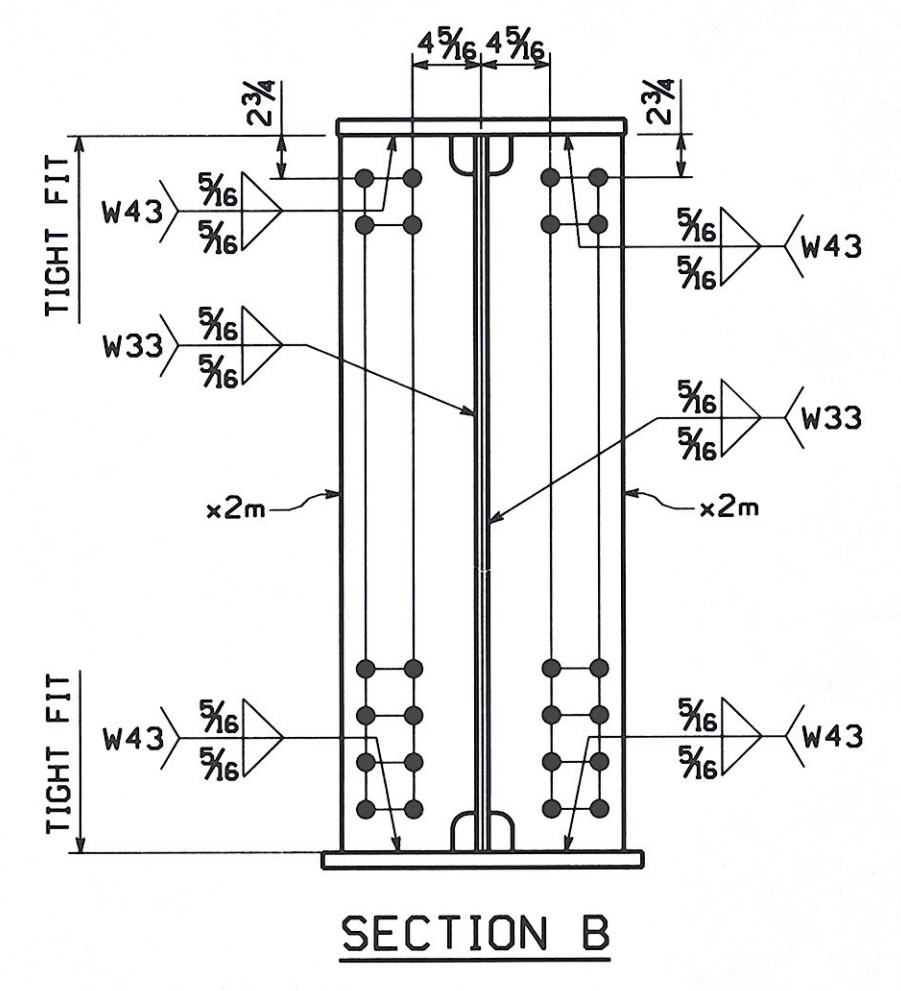



ENGLISH

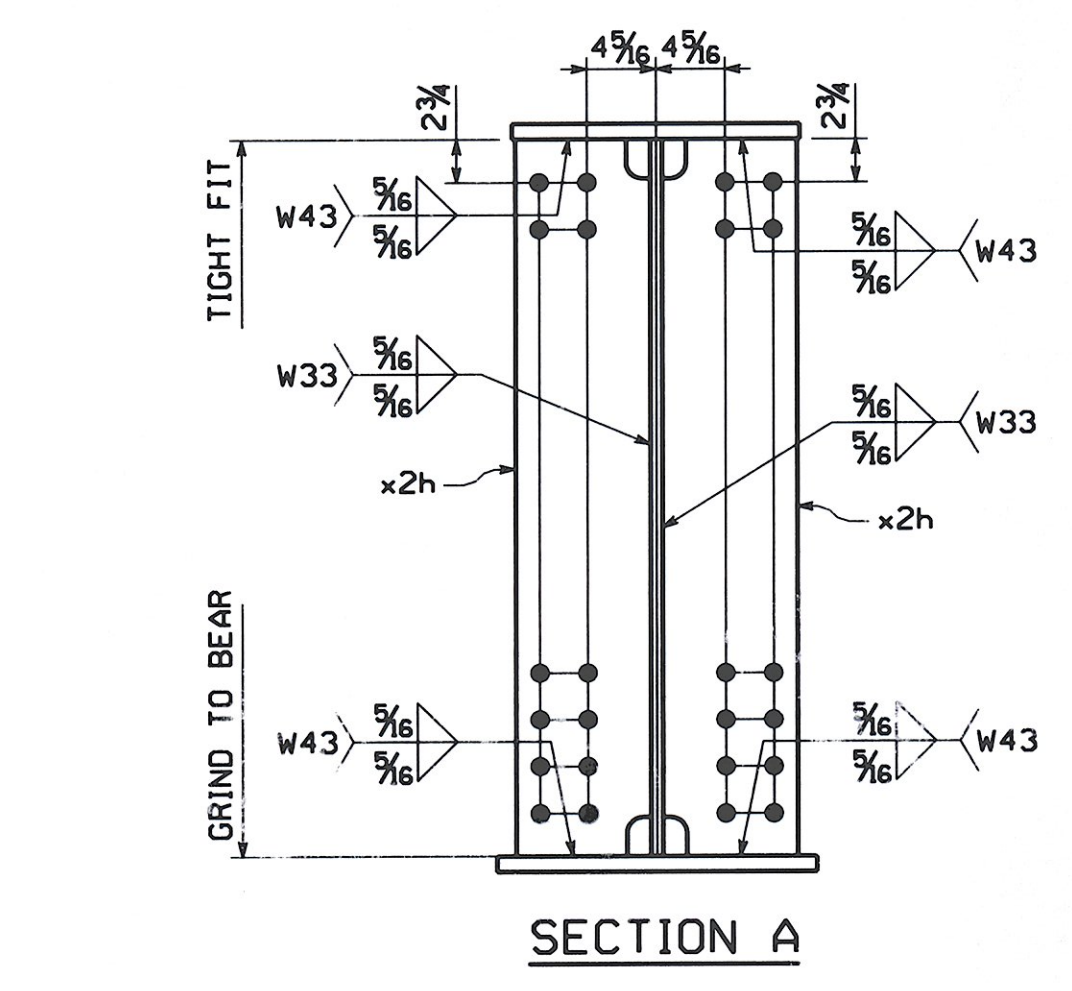

**GIRDER ~ MK. G2C**  
 FOR GENERAL SHOP NOTES, SEE DWG. GN1.  
 FOR WEB CAMBER DIAGRAM, SEE DWG. WC2.  
 FOR HORIZ. CURVE DIAGRAM, SEE DWG. HC1.

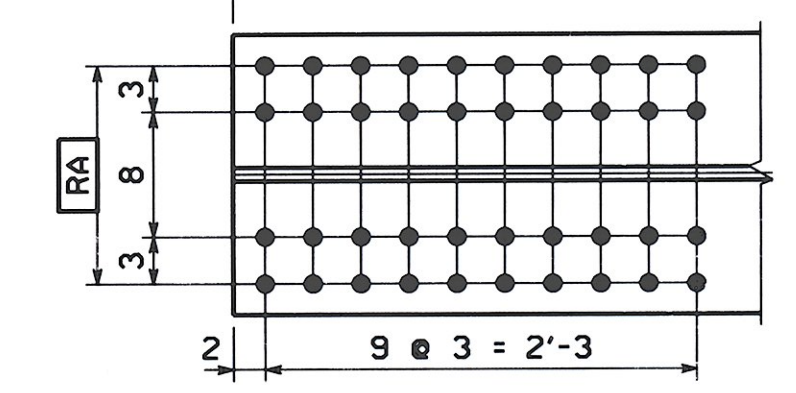

BILL OF MATERIAL														
QTY	EA	MARK	COMM	DESCRIPTION	LENGTH	SPEC	GRADE	TEST	REMARKS	ITEM	GROSS WEIGHT EA	DEDUCTED WEIGHT EA	SHIP WT. EA (LBS)	
1	G2C			GIRDER							26,420.19	7.83	26,420.19	
1	w1	PL	5/8	x 46	82	2 11/16	M270	50W	T	03002	8,043.96	7.83	8,036.13	
1	t1	PL	1 1/4	x 18	41	0 7/8	M270	50W	T	04007	3,144.65	0.00	3,144.65	
1	t2	PL	1 1/4	x 18	41	0 3/4	M270	50W	T	04007	3,143.85	0.00	3,143.85	
1	b1	PL	2 1/4	x 18	41	0 7/8	M270	50W	T	04002	5,660.36	0.00	5,660.36	
1	b2	PL	2 1/4	x 18	41	1 1/4	M270	50W	T	04002	5,664.67	0.00	5,664.67	
1	x1p	PL	1	x 18	2	0 1/2	M270	50W	T	FILL PL	06008	125.05	0.00	125.05
2	x2h	PL	7/8	x 8 1/2	3	10 1/32	M270	50W	T		07001	97.08	0.00	97.08
8	x2m	PL	1/2	x 8 1/2	3	10	M270	50W	T		07003	55.44	0.00	55.44
<b>TOTAL WEIGHT THIS SHEET:</b>											<b>26420.19 lbs.</b>			

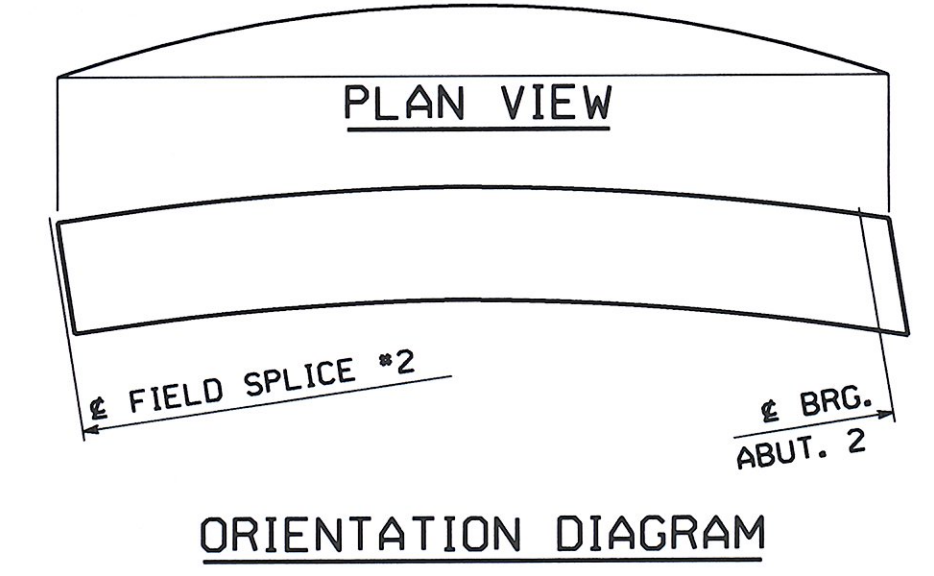

NO.	REVISION	BY	CHK'D	DATE

HOLES	1 1/16" (U.N.)	3							
BOLTS	NONE								
COATING	NONE								
CODES	30								
SCALE	N.T.S.								
SHPMT	1	DRAWING MANAGER	KREIDER (IH)	MADE BY	MAF	CHK'D BY	C5	DATE	6-23-08
STATE	VT	HSSI PROJECT NUMBER	S-1080077	HSSI STRUCT. ID	A	DRAWING NUMBER	12 OF 22		

RECEIVED  
 CK'D BY: *JK* OK'D BY: *JCL*  
 AUG 18 2008  
 RESUBMIT APPROVED  
 BY: *KMH* DATE: *8/19/08*

SHIPMENT 01  
 BY: Mkr-widel  
 PLOTTED: 8/17/2008 11:46:39 PM