

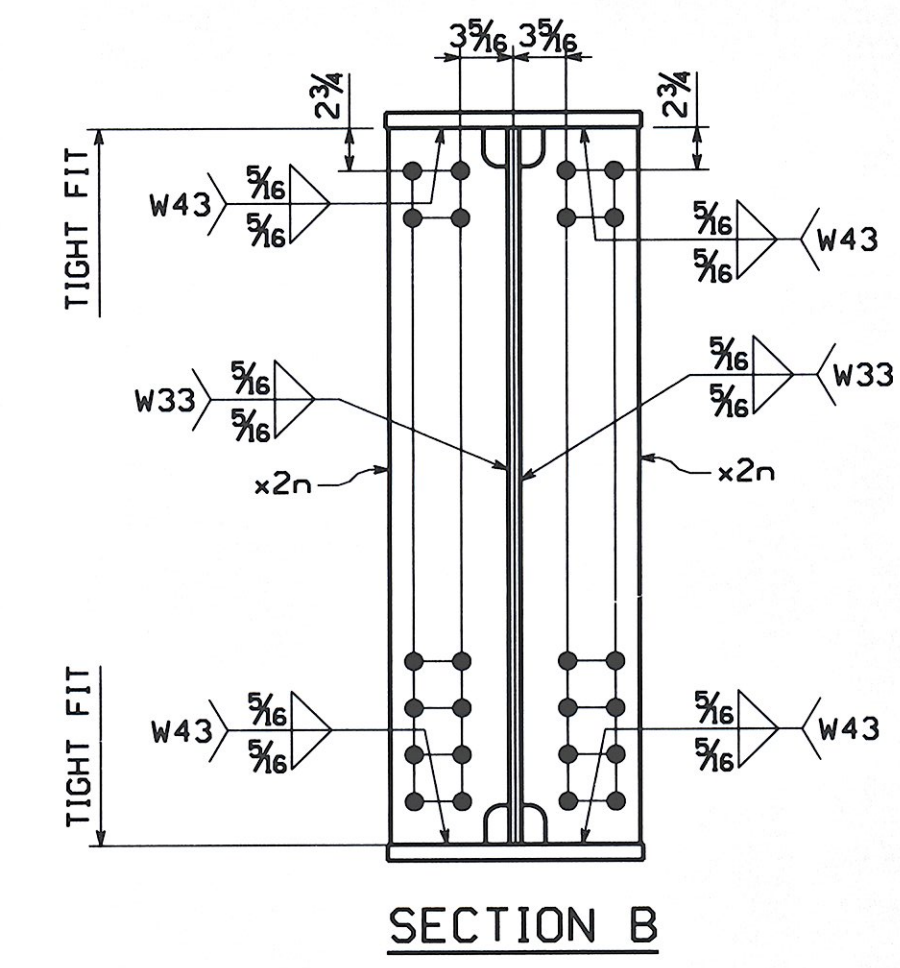
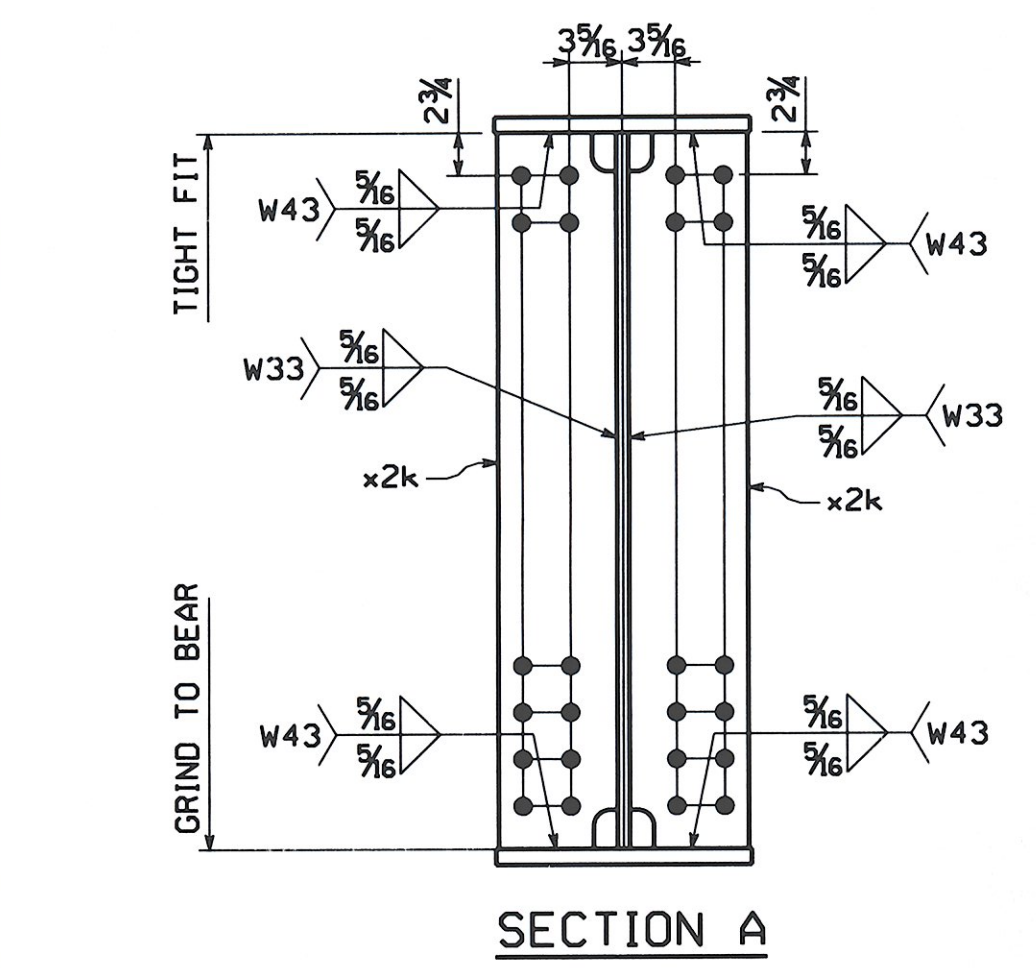
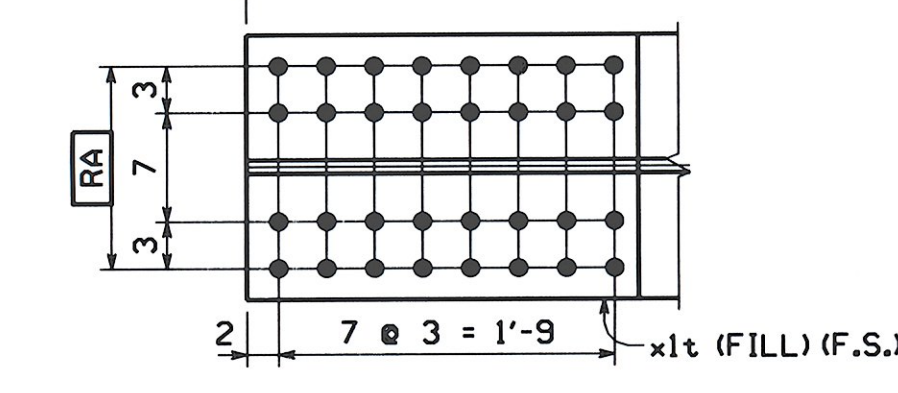
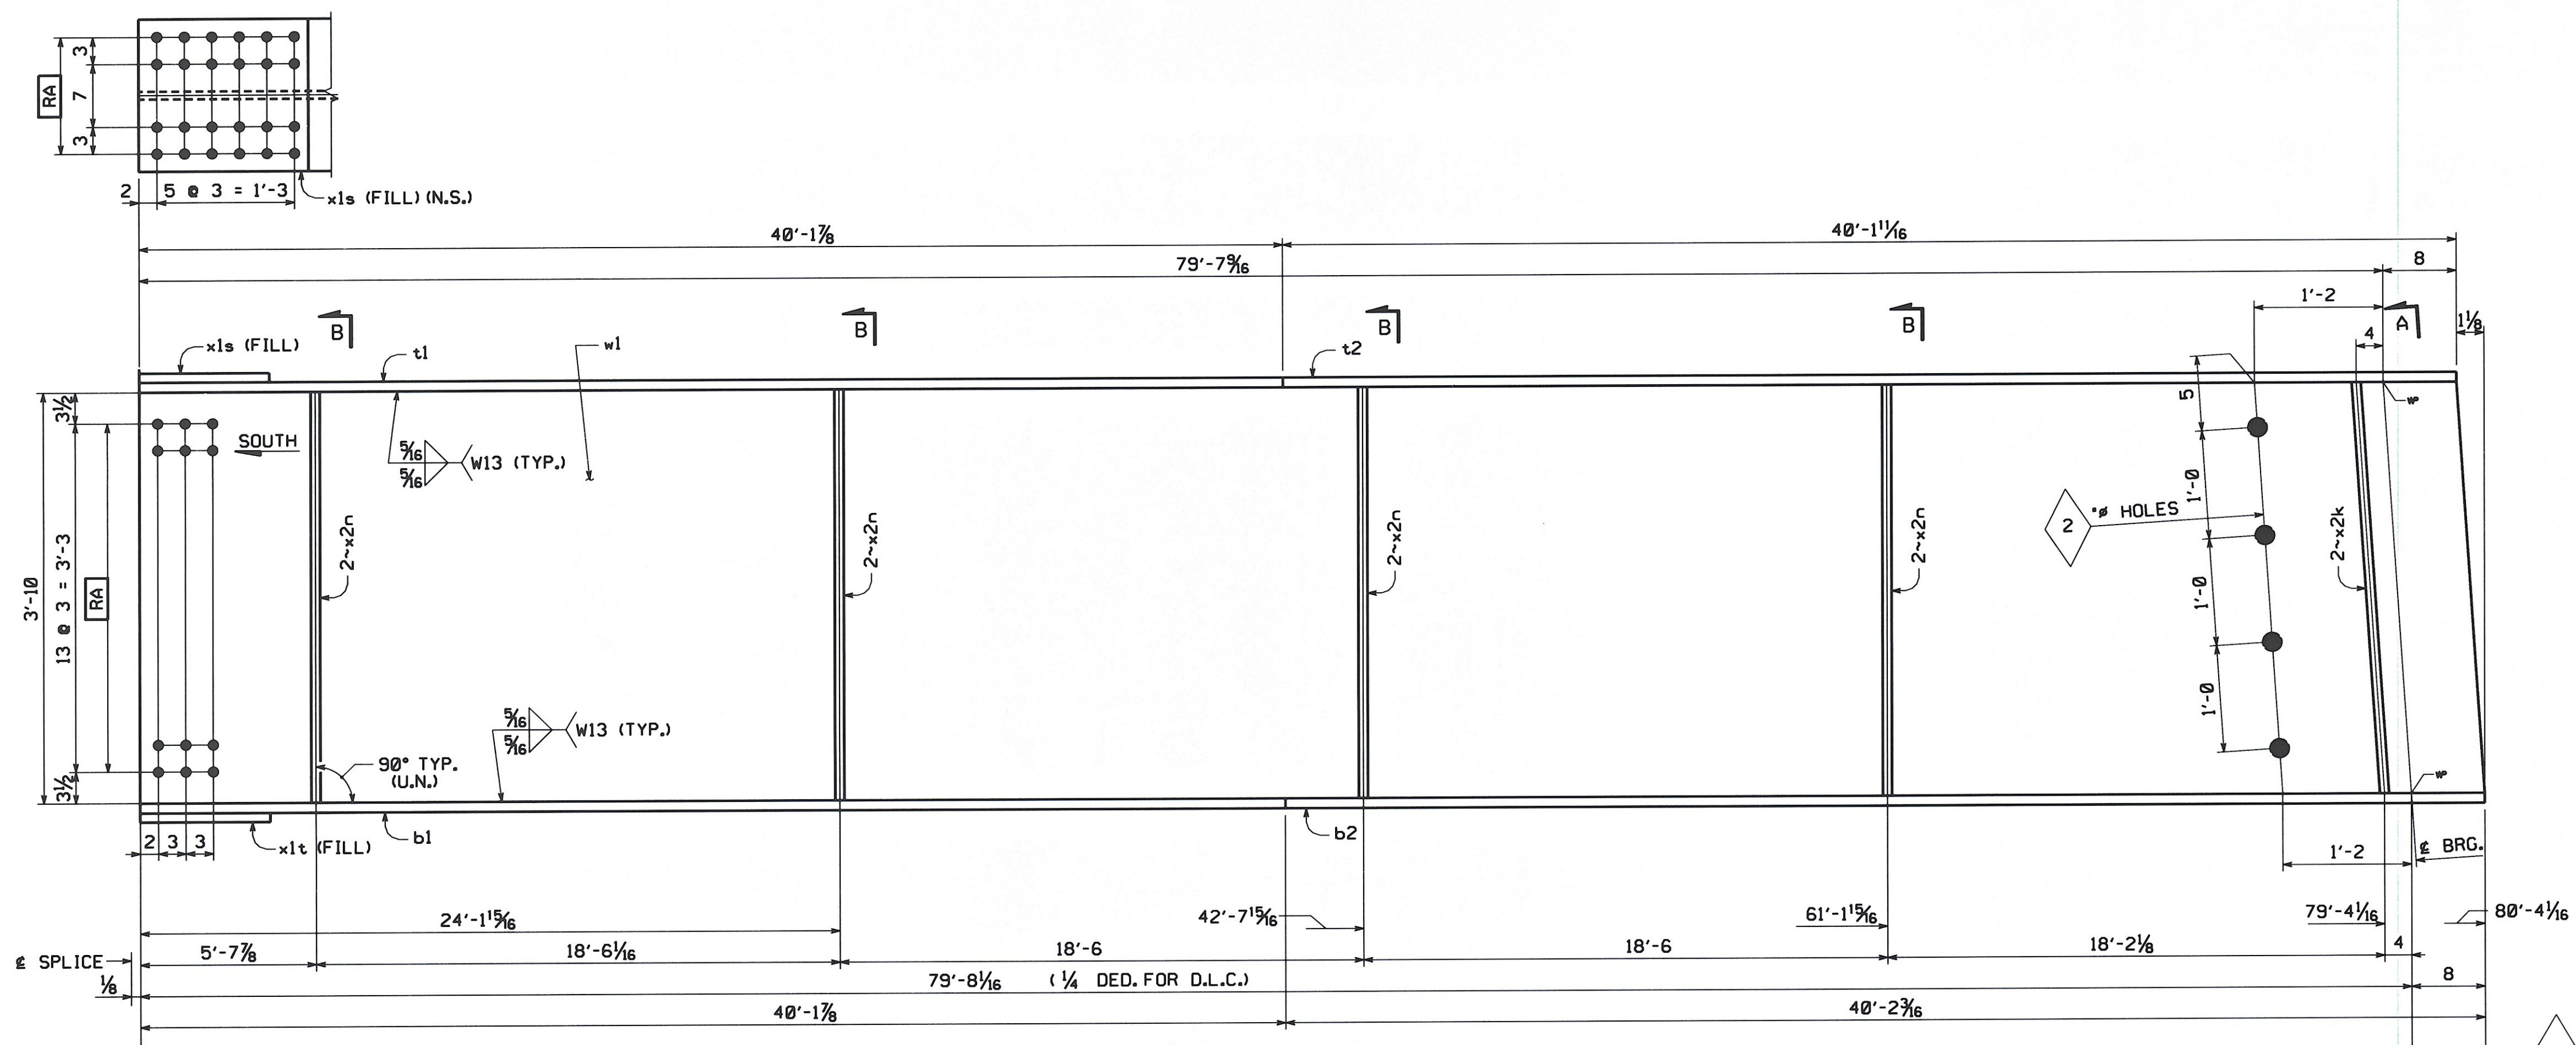


ENGLISH

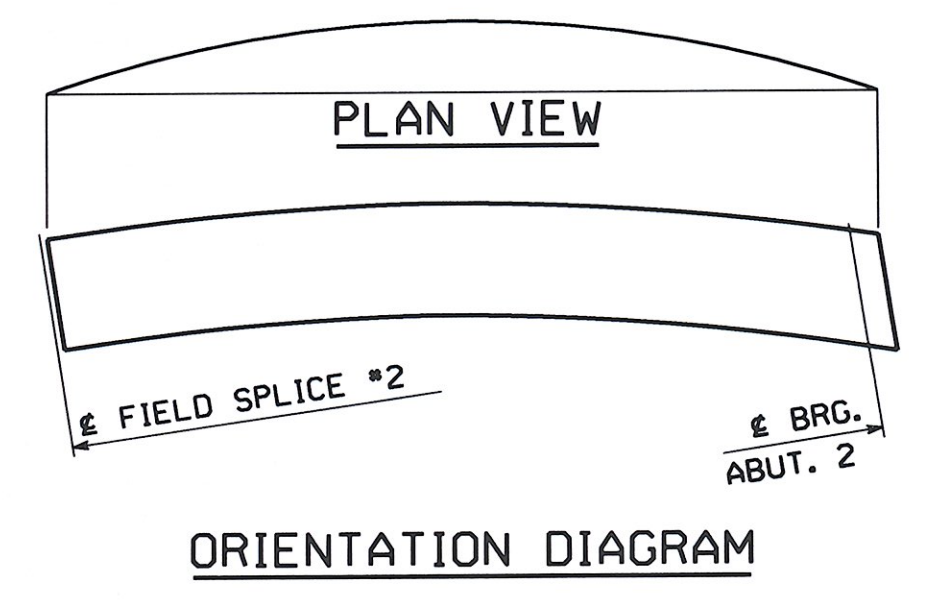

GIRDER ~ MK. G3C
 FOR GENERAL SHOP NOTES, SEE DWG. GNI.
 FOR WEB CAMBER DIAGRAM, SEE DWG. WC2.
 FOR HORIZ. CURVE DIAGRAM, SEE DWG. HC1.

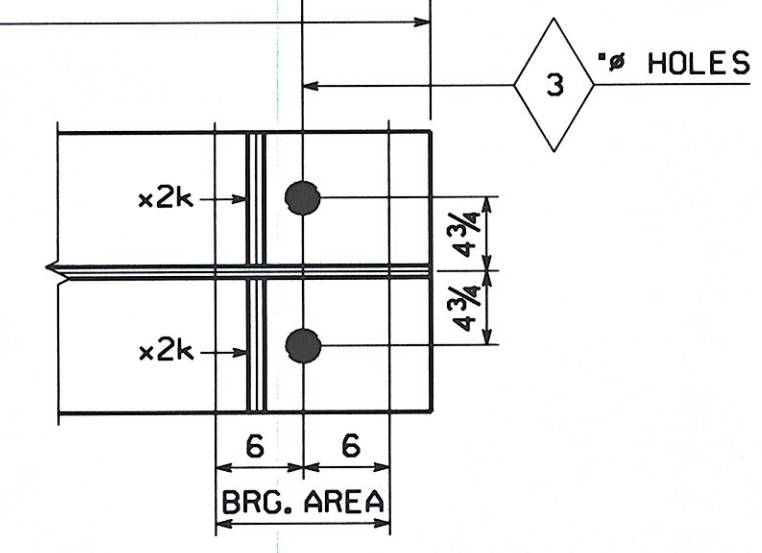

BILL OF MATERIAL												
QTY EA	MARK	COMM	DESCRIPTION	LENGTH	SPEC	GRADE	TEST	REMARKS	ITEM	GROSS WEIGHT EA	DEDUCTED WEIGHT EA	SHIP WT. EA (LBS)
1	G3C		GIRDER							19,474.98	7.83	19,474.98
1	w1	PL	5/8 x 46	80	4 11/16	M270	50W	T	03003	7,864.60	7.83	7,856.77
1	t1	PL	1 x 16	40	1 7/8	M270	50W	T	04008	2,186.28	0.00	2,186.28
1	t2	PL	1 x 16	40	1 11/16	M270	50W	T	04008	2,185.43	0.00	2,185.43
1	b1	PL	1 1/2 x 16	40	1 7/8	M270	50W	T	04004	3,279.43	0.00	3,279.43
1	b2	PL	1 1/2 x 16	40	2 3/16	M270	50W	T	04004	3,281.55	0.00	3,281.55
1	x1s	PL	1 x 16	1	6 1/2	M270	50W	T	FILL PL 06009	83.94	0.00	83.94
1	x1t	PL	1/2 x 16	2	0 1/2	M270	50W	T	FILL PL 06010	55.58	0.00	55.58
2	x2k	PL	3/4 x 7 1/2	3	10 1/32	M270	50W	T	07002	73.42	0.00	73.42
8	x2n	PL	1/2 x 7 1/2	3	10	M270	50W	T	07004	48.91	0.00	48.91
TOTAL WEIGHT THIS SHEET:										19474.98 lbs.		

RECEIVED
 AUG 18 2008
 RESUBMIT APPROVED
 BY RMH DATE 8/19/08

NO.	REVISION	BY	CHK'D	DATE

HOLES	15/16"			
BOLTS	NONE			
COATING	NONE			
CODE(S)	30			
SCALE	N.T.S.			
STATE	VT			

PROJECT NO. (STP) BR	FED. AID PROJ. NO.
VT ROUTE 100 (MINOR ARTERIAL) OVER WHITE RIVER	
TOWN OF STOCKBRIDGE, COUNTY OF WINDSOR, VERMONT	
STATE OF VERMONT	
AGENCY OF TRANSPORTATION	
GENERAL CONTRACTOR	WINTERSET, INC.
PROJECT MGR	DEB KUPRES
DRAWING MANAGER	KREIDER (IH)
MADE BY	MAF
CHK'D. BY	CS
DATE	6-23-08
PROJECT NUMBER	S-1080077
HSSI STRUCT. ID	A
DRAWING NUMBER	13 OF 22

SHIPMENT 01
 BY: MK-madel
 PLOTTED: 8/1/2008 14:46:47 PM