

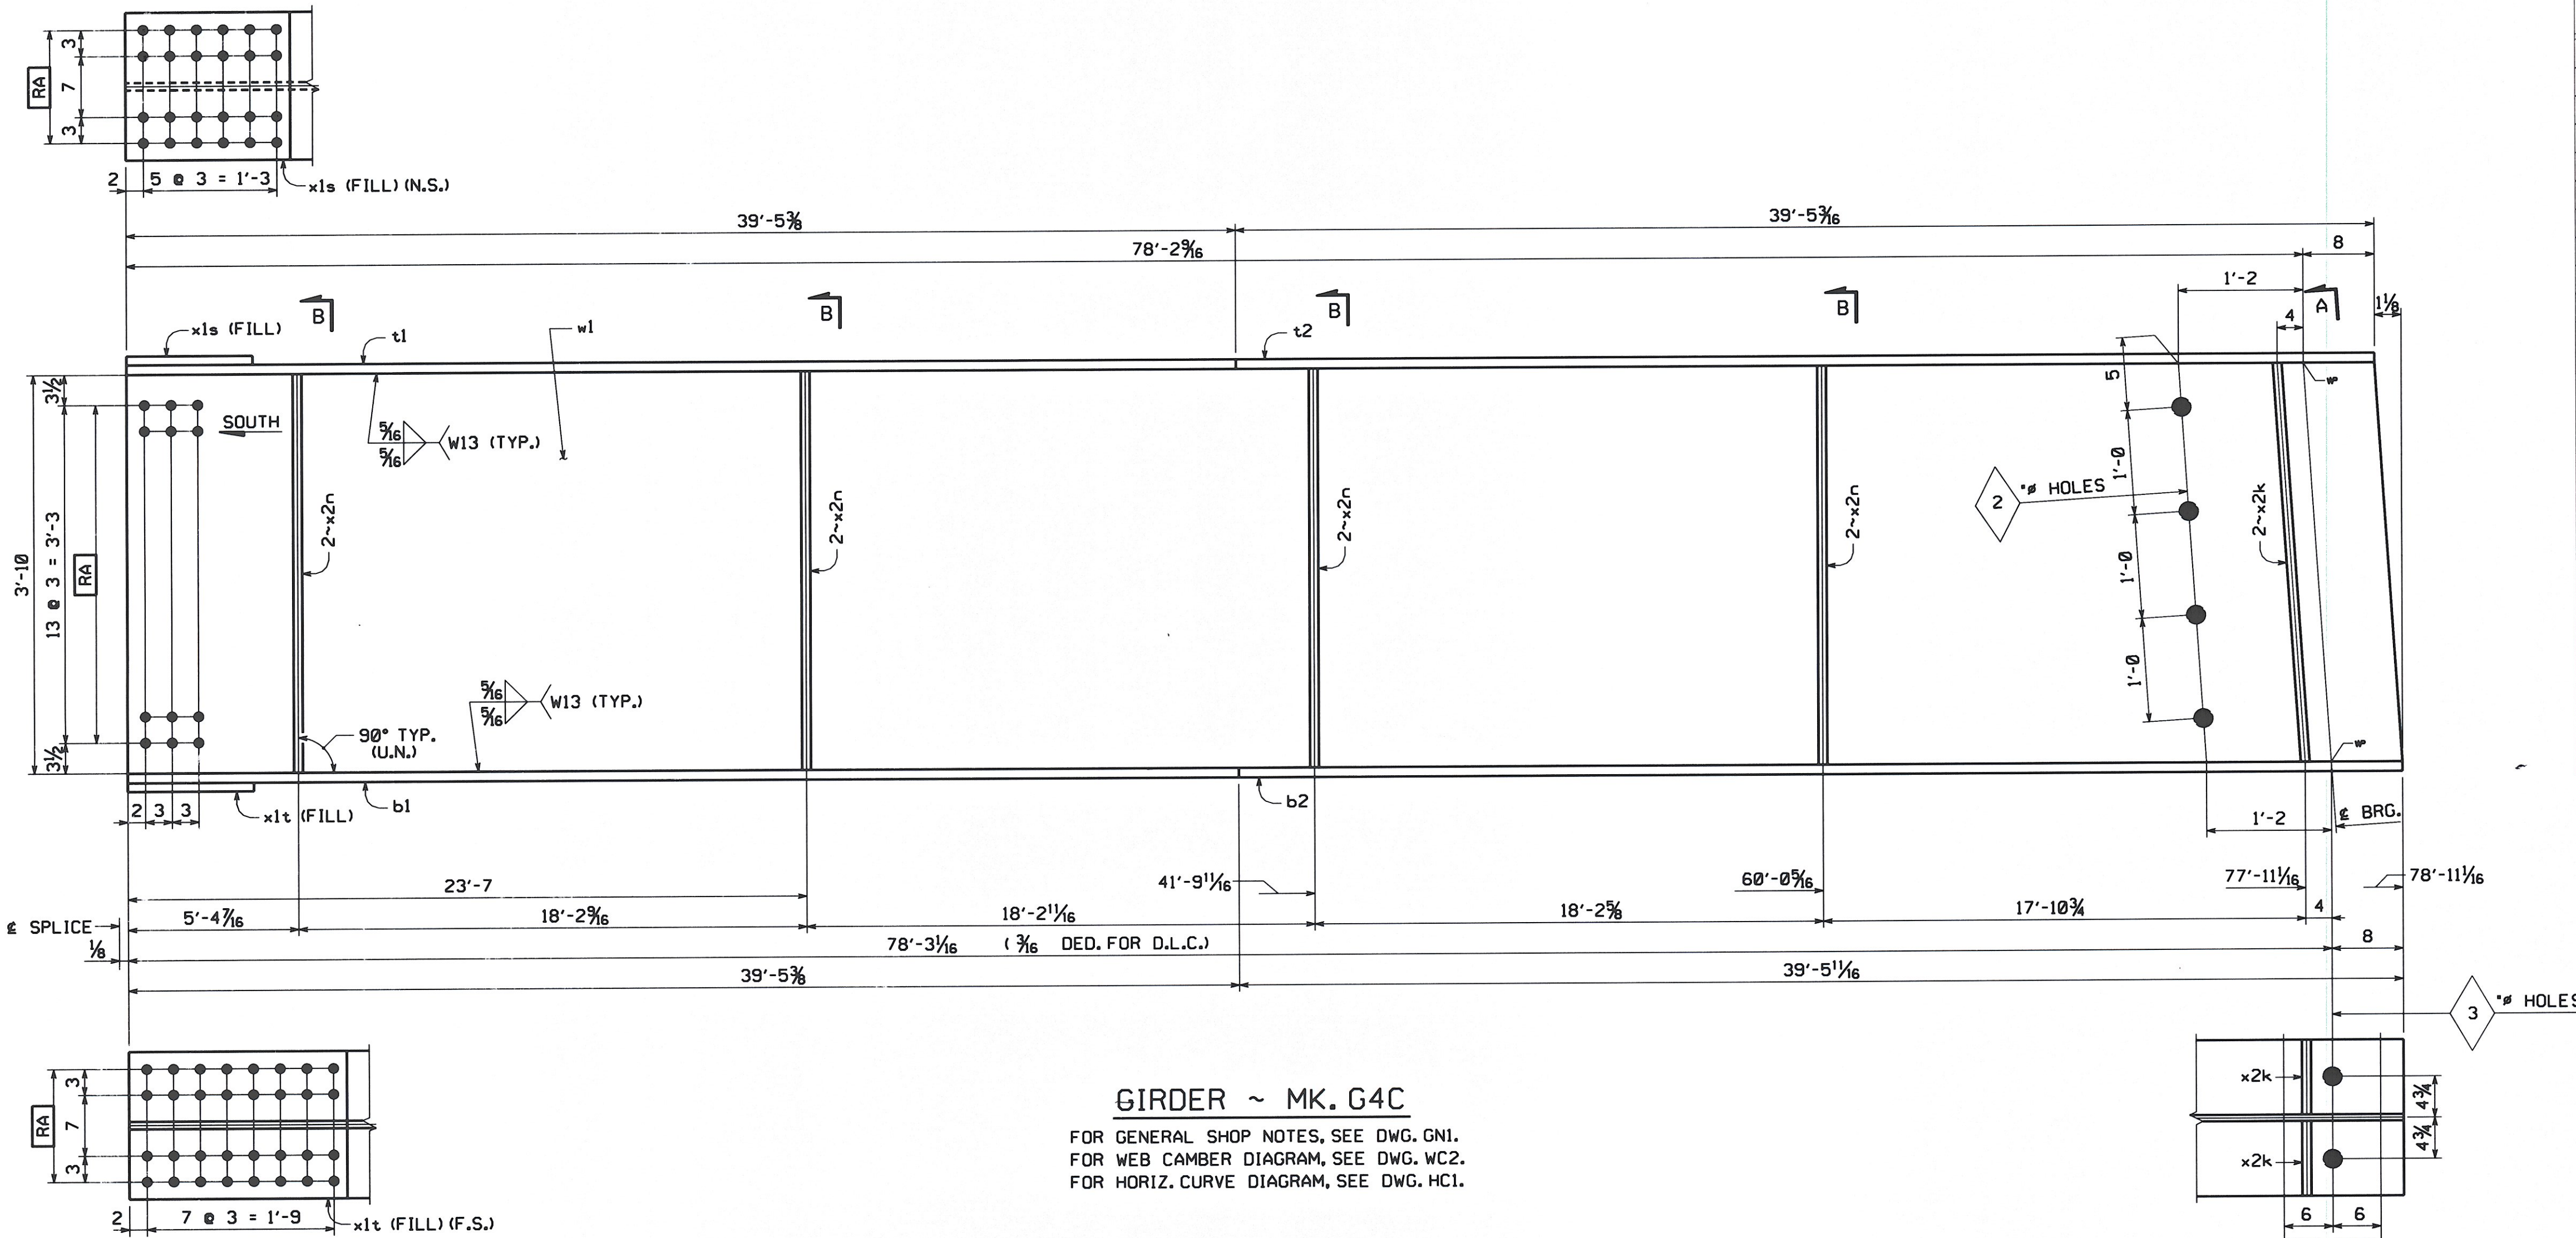


ENGLISH

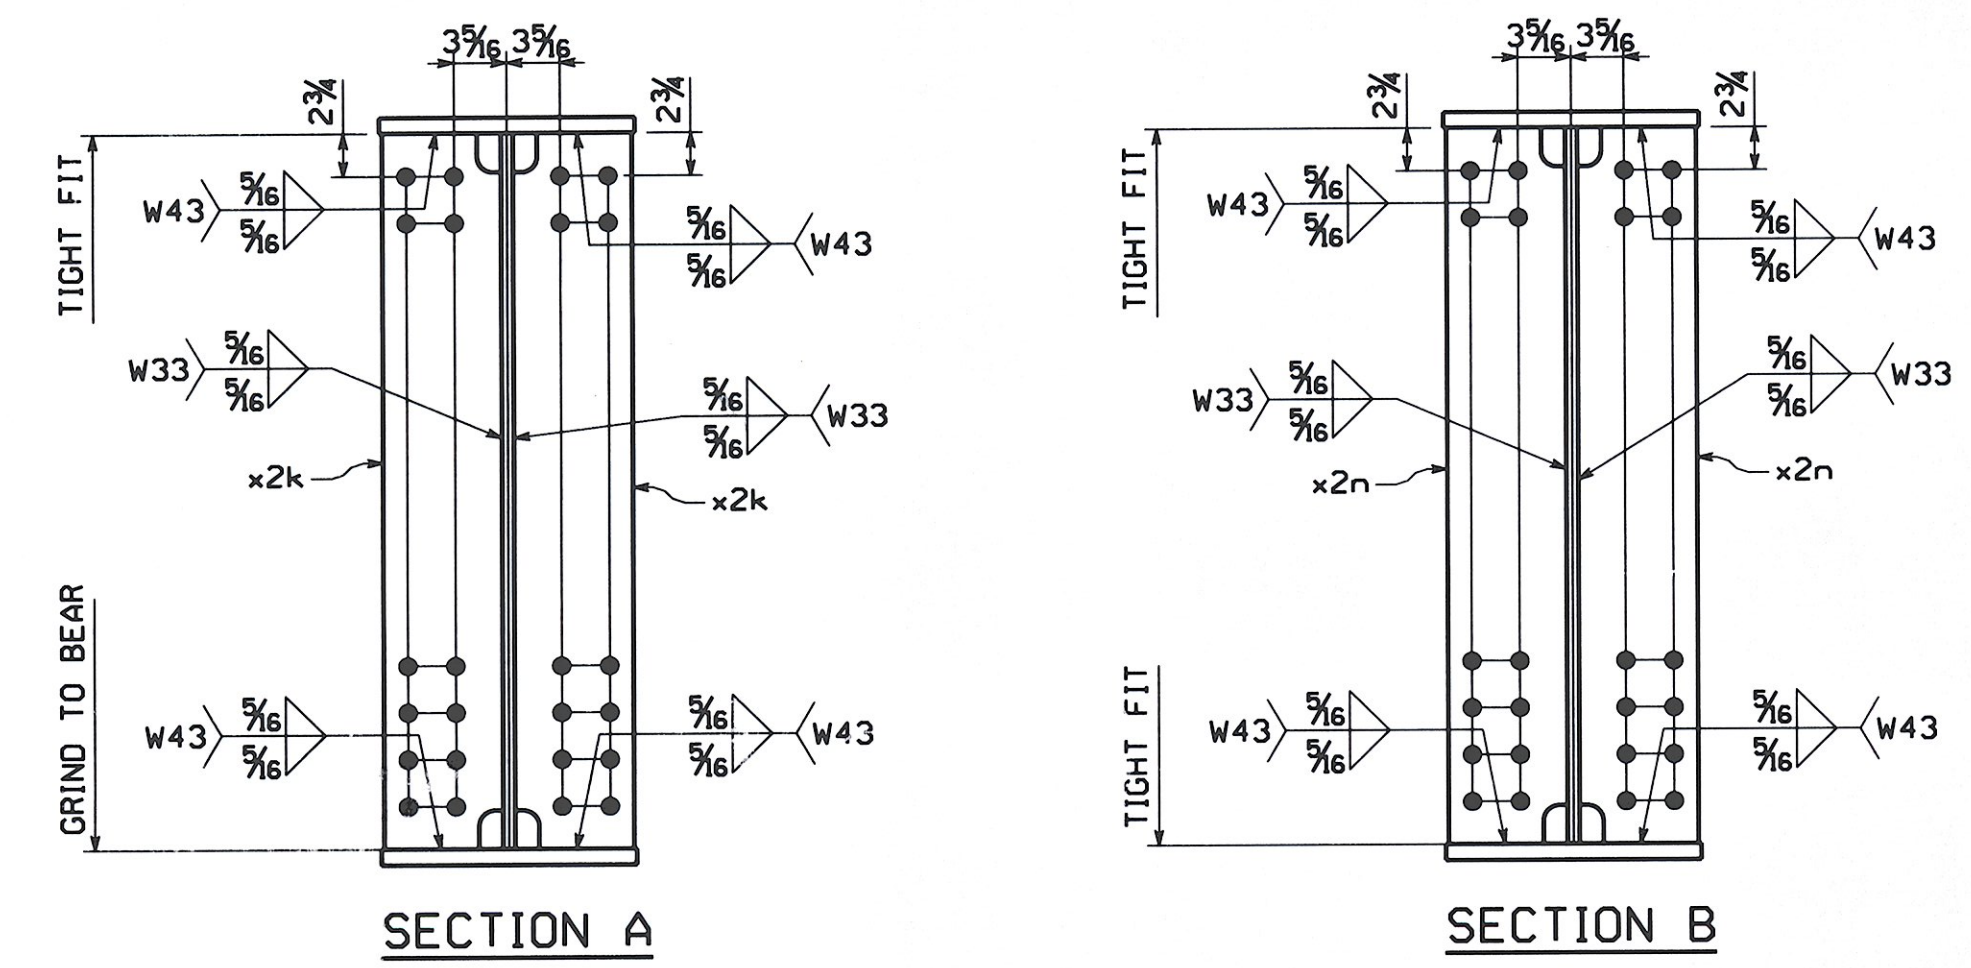

**GIRDER ~ MK. G4C**  
 FOR GENERAL SHOP NOTES, SEE DWG. GNI.  
 FOR WEB CAMBER DIAGRAM, SEE DWG. WC2.  
 FOR HORIZ. CURVE DIAGRAM, SEE DWG. HC1.

BILL OF MATERIAL													
QTY EA	MARK	COMM	DESCRIPTION	LENGTH	SPEC	GRADE	TEST	REMARKS	ITEM	GROSS WEIGHT EA	DEDUCTED WEIGHT EA	NET WT EA (LBS)	
1	G4C		GIRDER							19,143.56	7.83	19,143.56	
1	w1	PL	5/8 x 46	78	11 11/16	M270	50W	T	03004	7,726.01	7.83	7,718.18	
1	t1	PL	1 x 16	39	5 3/8	M270	50W	T	04009	2,147.72	0.00	2,147.72	
1	t2	PL	1 x 16	39	5 3/16	M270	50W	T	04009	2,146.87	0.00	2,146.87	
1	b1	PL	1 1/2 x 16	39	5 3/8	M270	50W	T	04005	3,221.58	0.00	3,221.58	
1	b2	PL	1 1/2 x 16	39	5 11/16	M270	50W	T	04005	3,223.71	0.00	3,223.71	
1	x1s	PL	1 x 16	1	6 1/2	M270	50W	T	FILL PL 06009	83.94	0.00	83.94	
1	x1t	PL	1/2 x 16	2	0 1/2	M270	50W	T	FILL PL 06010	55.58	0.00	55.58	
2	x2k	PL	3/4 x 7 1/2	3	10 1/32	M270	50W	T	07002	73.42	0.00	73.42	
8	x2n	PL	1/2 x 7 1/2	3	10	M270	50W	T	07004	48.91	0.00	48.91	
<b>TOTAL WEIGHT THIS SHEET:</b>										<b>19143.56 lbs.</b>			

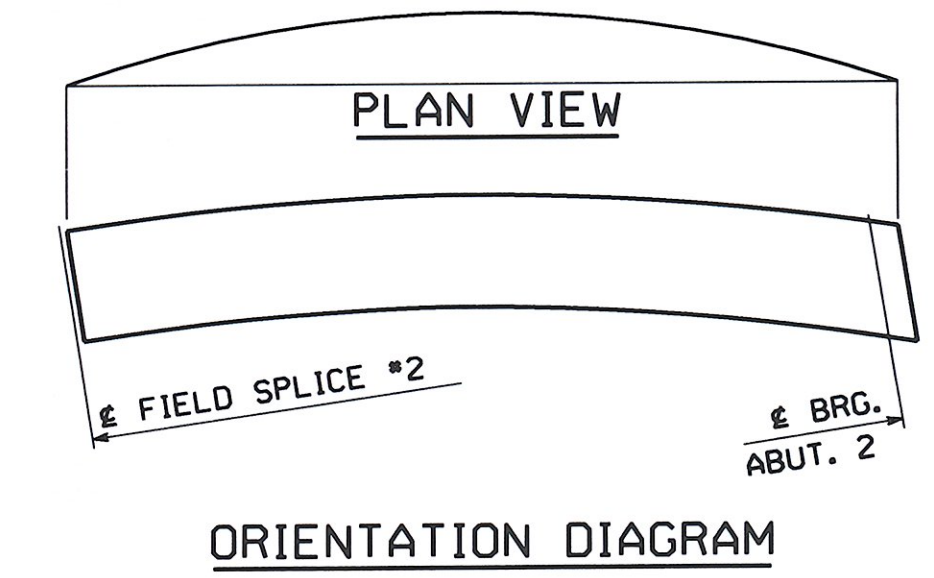

RECEIVED  
 CK'D BY *JFC* OK'D BY *JFC*  
 AUG 18 2008  
 RESUBMIT APPROVED *[check]*  
 BY *KMH* DATE 8/19/08

NO.	REVISION	BY	CHK'D	DATE

HOLES 1 1/2" (U.N.)	BRIDGE	<b>HIGH STEEL STRUCTURES</b>	LANCASTER FACILITY 815 Old Philadelphia Pike Lancaster, PA 17605-0008 Phone (717) 299-5211
BOLTS NONE	AGC	AN AFFILIATE OF HIGH INDUSTRIES INC.	WILMINGTON FACILITY 350 N. 4th Street Wilmington, PA 17701 Phone (570) 326-9051 www.highsteel.com
COATING NONE	GIRDER G4C		
CODE(S) 30	VT ROUTE 100 (MINOR ARTERIAL) OVER WHITE RIVER VT ROUTE 100 STA. 141+39.00 TO STA. 143+61.00 TOWN OF STOCKBRIDGE, COUNTY OF WINDSOR, VERMONT		
SCALE N.T.S.	STATE OF VERMONT AGENCY OF TRANSPORTATION		
STATE VT	STATE CONT. OR REF. NO. 013-4(21)	PROJECT NO. (STP) BR WINTERSET, INC.	FED. AID PROJ. NO. HSSI PROJ. MGR DEB KUPRES
SHPMT 1	DRAWING MANAGER KREIDER (IH)	MADE BY MAF	CHK'D BY CS DATE 6-23-08
	HSSI PROJECT NUMBER S-1080077	HSSI STRUCT. ID A	DRAWING NUMBER 14 OF 22