

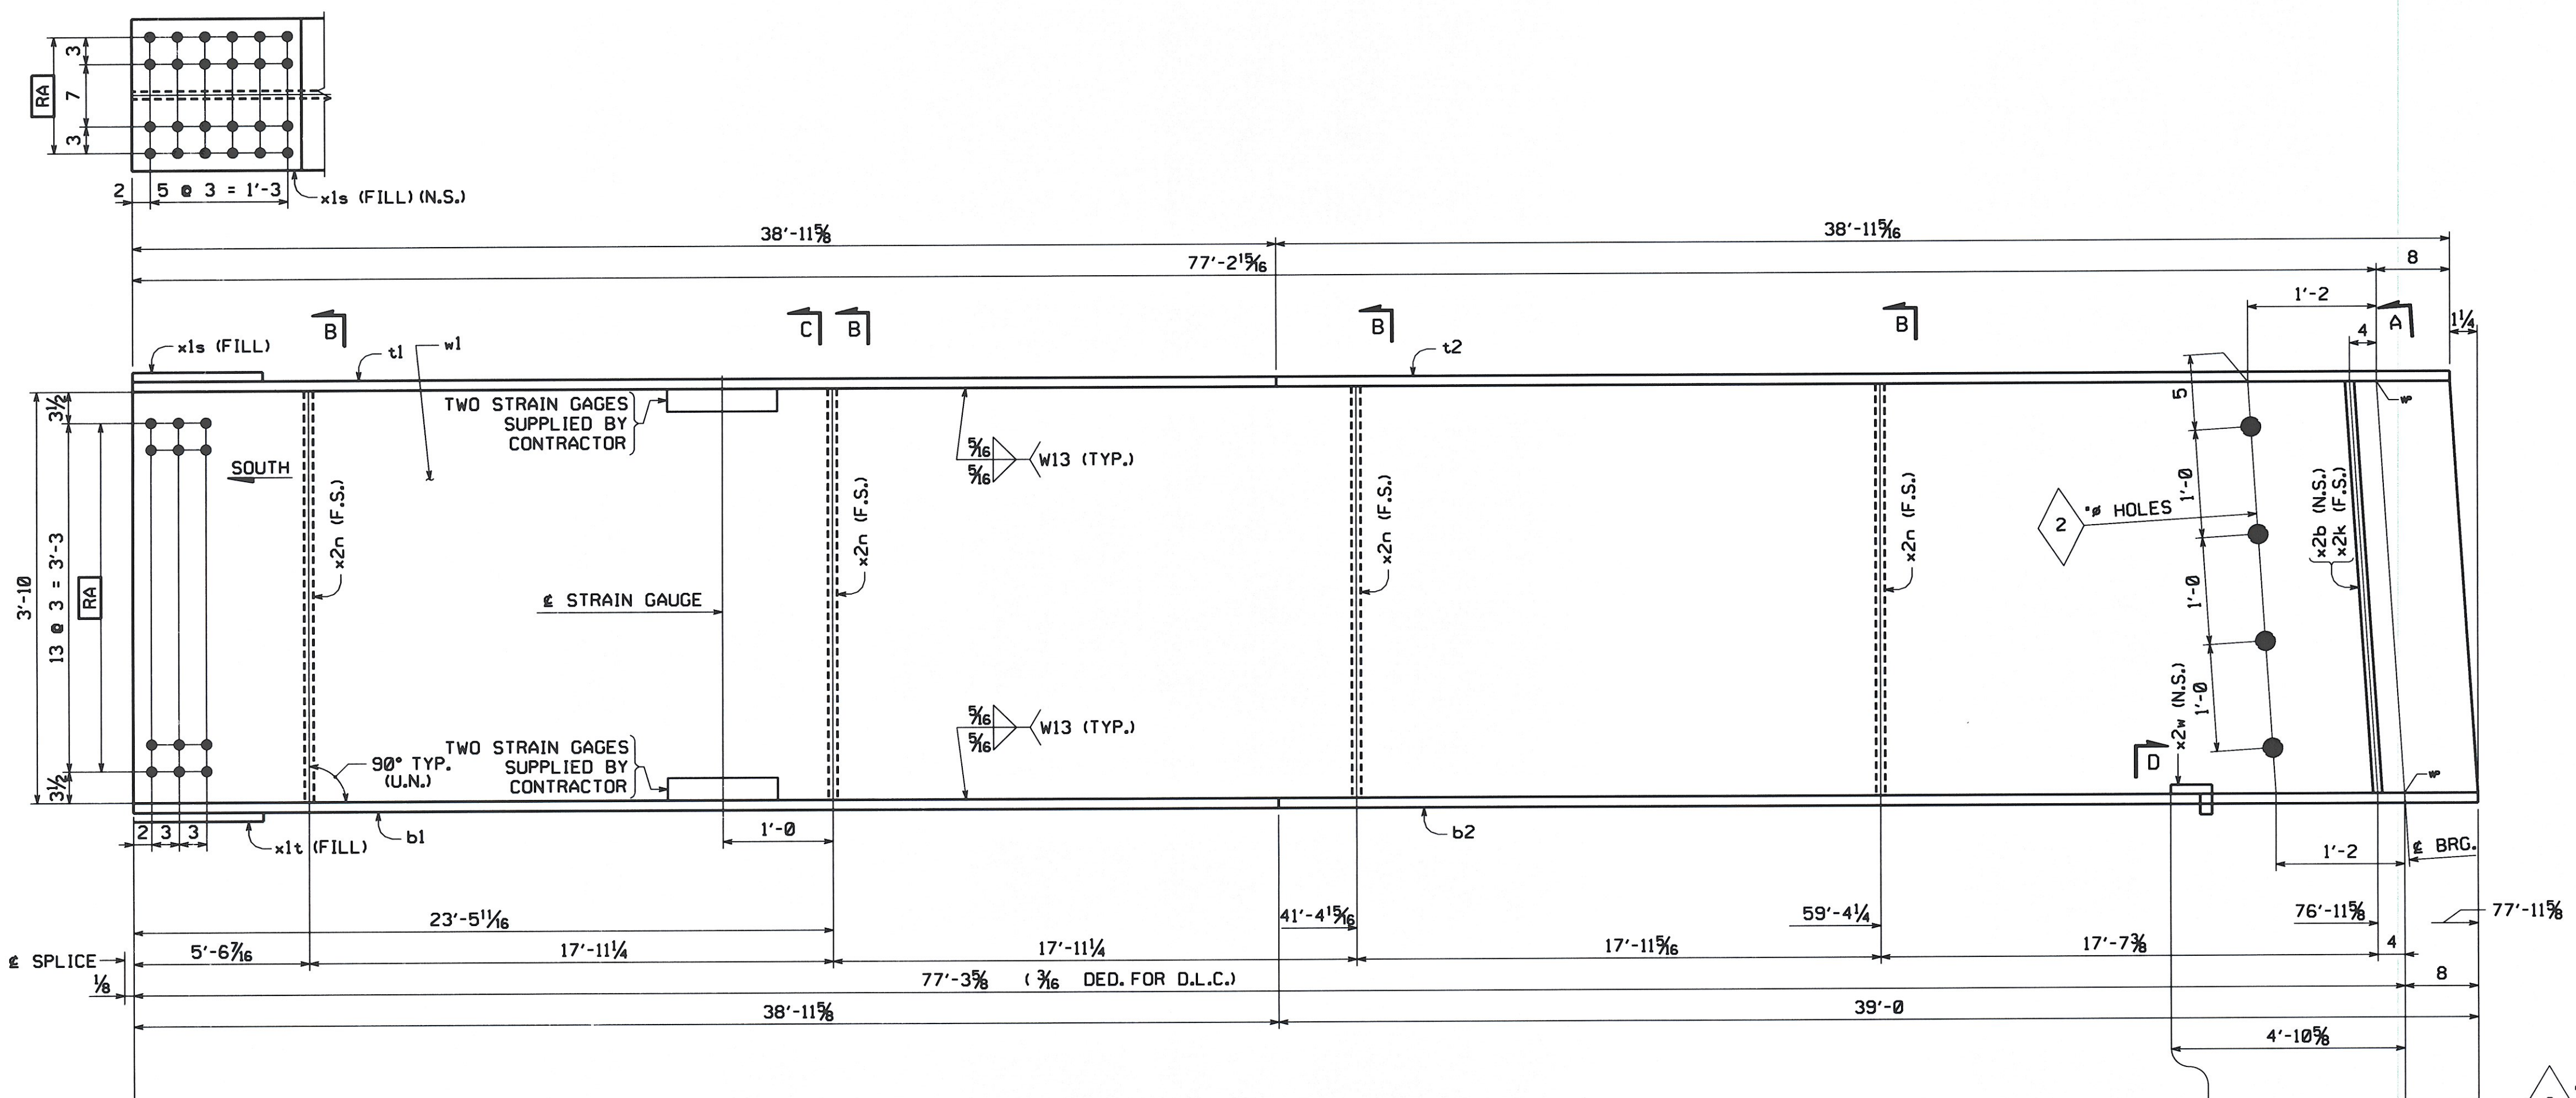
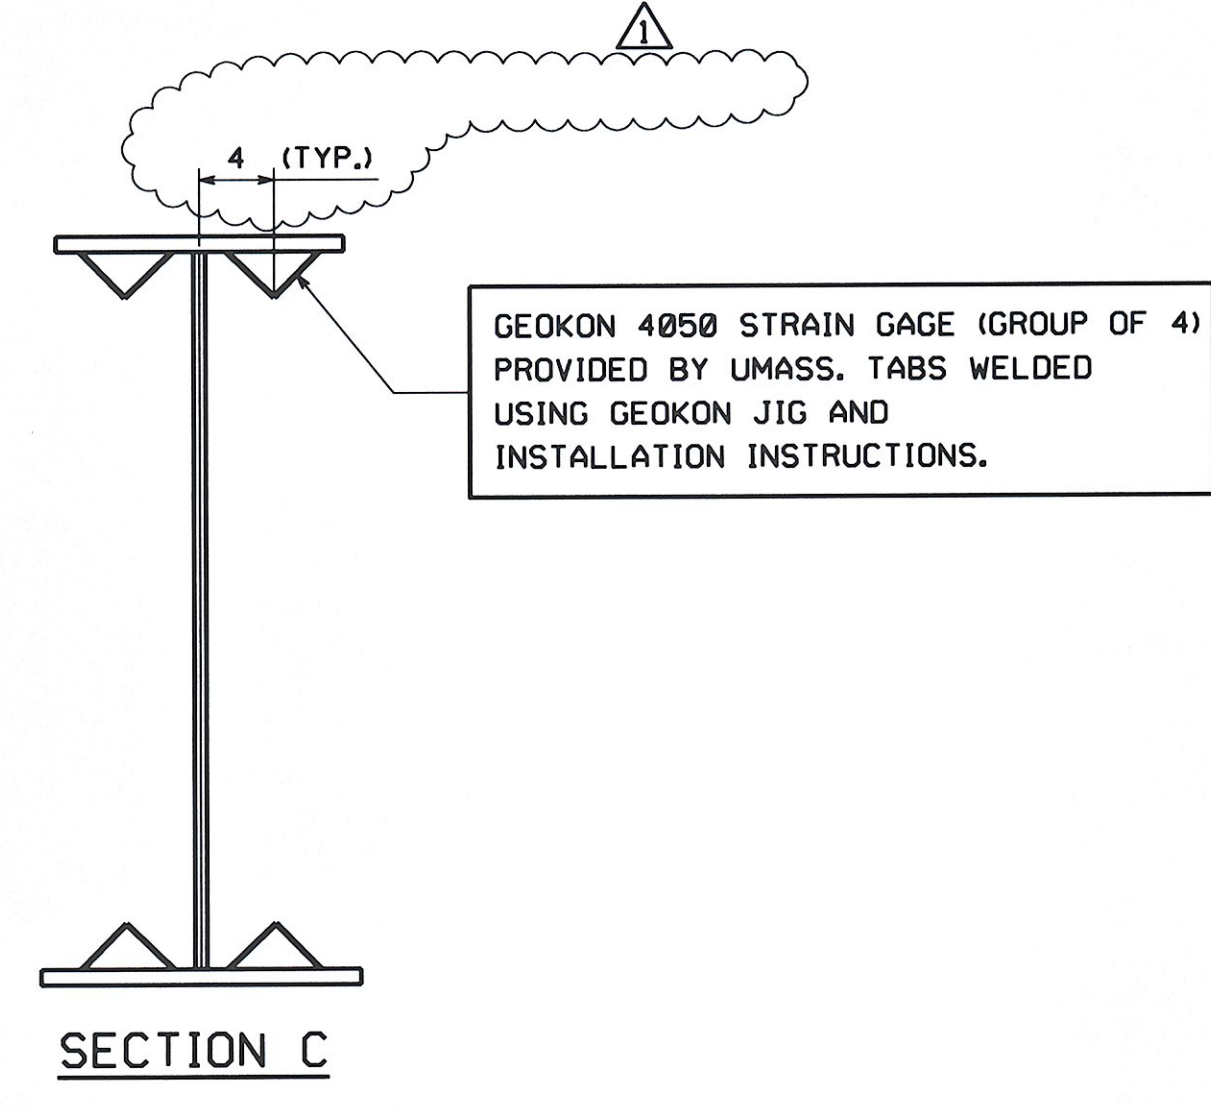
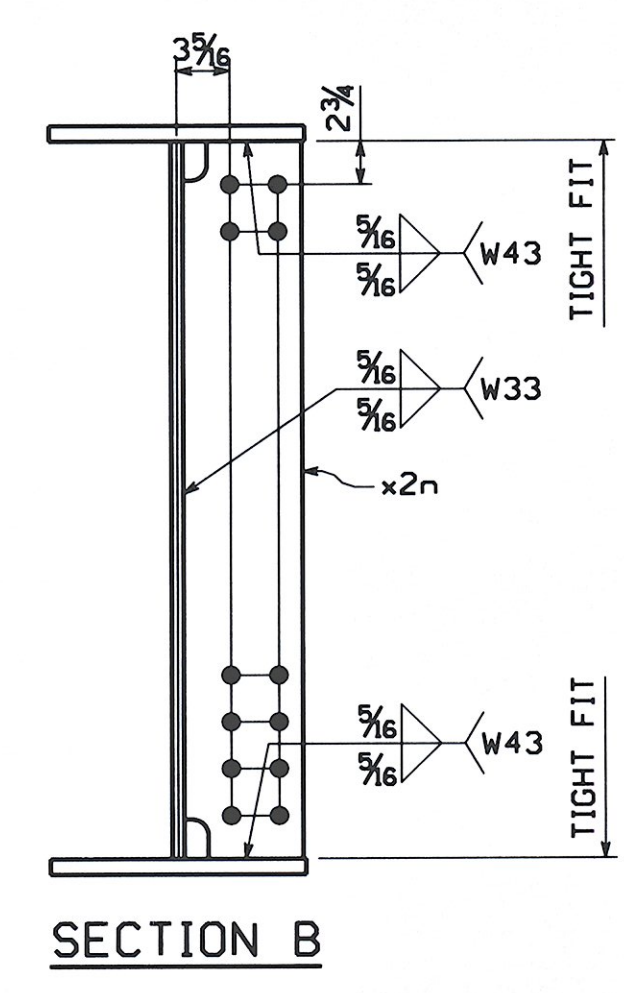
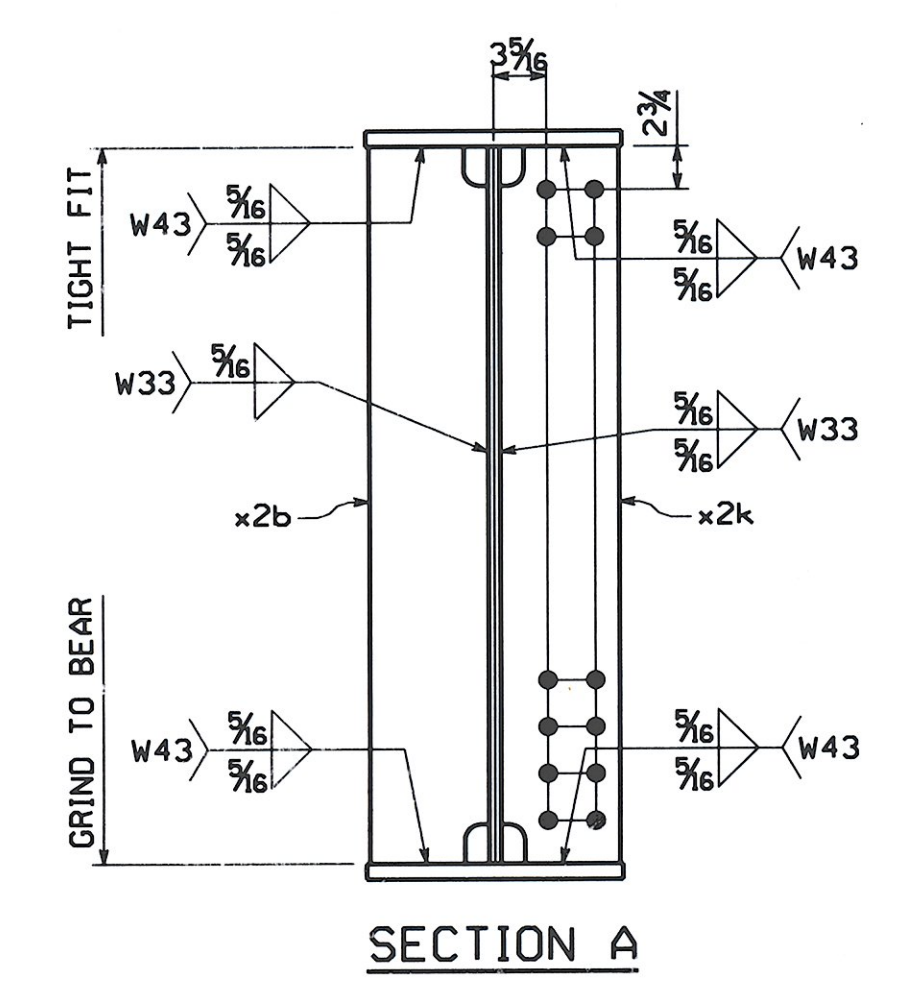
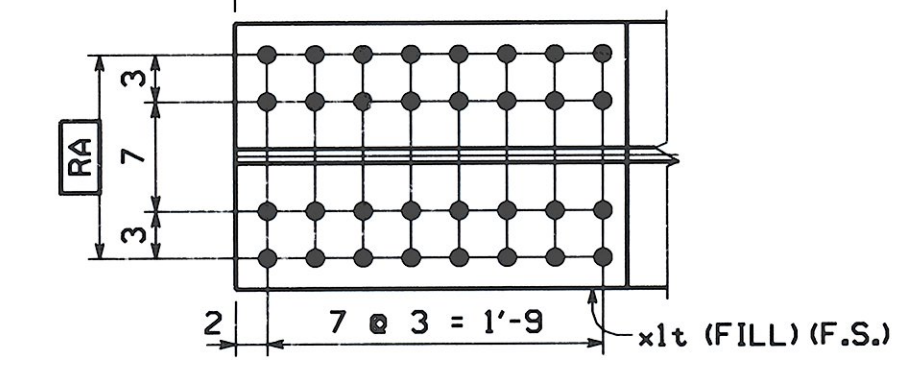
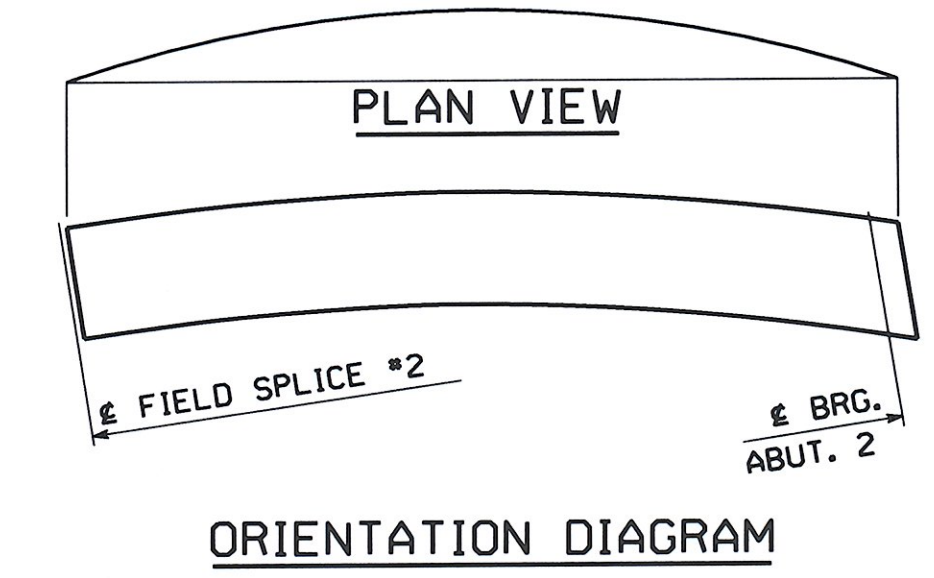


ENGLISH

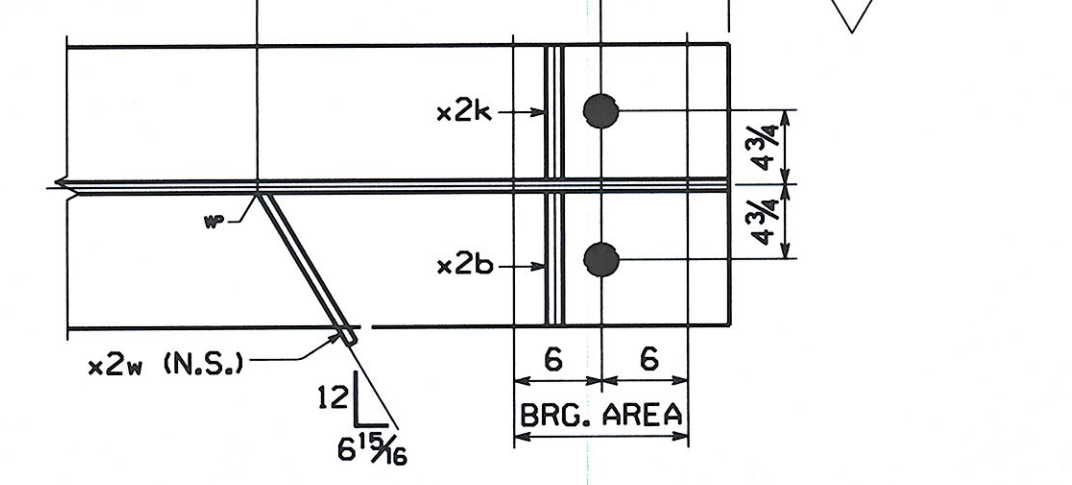

GIRDER ~ MK. G5C
 FOR GENERAL SHOP NOTES, SEE DWG. GNI.
 FOR WEB CAMBER DIAGRAM, SEE DWG. WC2.
 FOR HORIZ. CURVE DIAGRAM, SEE DWG. HCl.

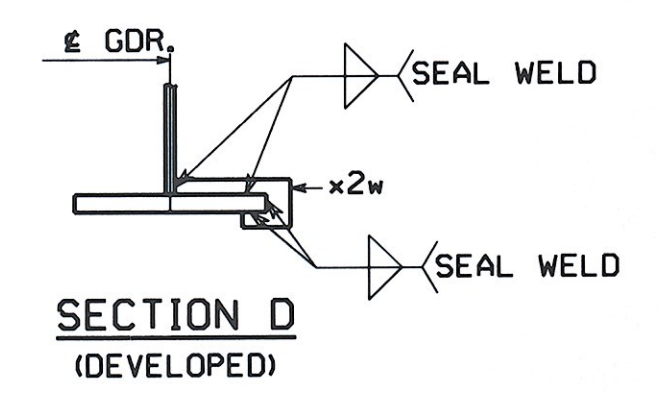

BILL OF MATERIAL												
QTY	MARK	COMB	DESCRIPTION	LENGTH	SPEC	GRADE	TEST	REMARKS	ITEM	GROSS WEIGHT EA.	DEDUCTED WEIGHT EA.	SHIP WT. EA. (LBS)
1	G5C		GIRDER							18,726.22	8.11	18,726.22
1	w1	PL	5/8 x 46	78 0 3/16	M270	50W	T		03005	7,632.26	8.11	7,624.15
1	t1	PL	1 x 16	38 11 5/8	M270	50W	T		04010	2,121.63	0.00	2,121.63
1	t2	PL	1 x 16	38 11 5/16	M270	50W	T		04010	2,120.21	0.00	2,120.21
1	b1	PL	1 1/2 x 16	38 11 5/8	M270	50W	T		04006	3,182.45	0.00	3,182.45
1	b2	PL	1 1/2 x 16	39 0	M270	50W	T		04006	3,185.00	0.00	3,185.00
1	x1s	PL	1 x 16	1 6 1/2	M270	50W	T	FILL PL	06009	83.94	0.00	83.94
1	x1t	PL	1/2 x 16	2 0 1/2	M270	50W	T	FILL PL	06010	55.58	0.00	55.58
1	x2b	PL	3/4 x 7 1/2	3 10	M270	50W	T		07002	73.37	0.00	73.37
1	x2k	PL	3/4 x 7 1/2	3 10 1/32	M270	50W	T		07002	73.42	0.00	73.42
4	x2n	PL	1/2 x 7 1/2	3 10	M270	50W	T		07004	48.91	0.00	48.91
1	x2w	PL	1/4 x 3 1/2	0 10 7/8	M270	50W	T		07006	2.70	0.00	2.70
4			STRAIN GAGE					SUPPLIED BY CONTRACTOR				
TOTAL WEIGHT THIS SHEET:										18726.22 lbs.		

RECEIVED
 CK'D BY: [Signature] OK'D BY: [Signature]
 AUG 13 2008
 RESUBMIT APPROVED BY: [Signature] DATE: 8/19/08

NO.	REVISION	BY	CHK'D	DATE	
	ADDED DIMENSION TO LOCATE STRAIN GAGE & REMOVED CONTRACTOR PLEASE SUPPLY	MGK	WW	8/2/08	
GIRDER G5C VT ROUTE 100 (MINOR ARTERIAL) OVER WHITE RIVER TOWN OF STOCKBRIDGE, COUNTY OF WINDSOR, VERMONT STATE OF VERMONT AGENCY OF TRANSPORTATION PROJECT NO. (STP) BR/013-4(21) GENERAL CONTRACTOR: WINTERSET, INC. HSSI PROJECT MGR: DEB KUPRES STATE: VT HSSI PROJECT NUMBER: S-1080077 HSSI STRUCT. ID: A DRAWING NUMBER: 15 OF 22					
SHPMNT	1	DRAWING MANAGER: KREIDER (IH)	MADE BY: MAF	CHK'D BY: CS	DATE: 6-23-08

SHIPMENT 01
 PM:ENG: 50021327 PRJ: 5004328 SHIPRECT: 5004329
 BY: beaver
 PLOTTED: 6/4/2008 8:23:51 AM