

PROJECT LOCATION:  
 BEGINNING AT A POINT IN THE TOWN OF WARREN, ON VT ROUTE  
 100 APPROXIMATELY 5.82 MILES NORTHERLY OF THE GRANVILLE-  
 WARREN TOWN LINE AND EXTENDING NORTHERLY 0.162 MILES.

**PROJECT DATA**

LENGTH OF ROADWAY = 708.25 FEET  
 LENGTH OF BRIDGE = 146.75 FEET  
 LENGTH OF PROJECT = 855.00 FEET



**PROJECT DESCRIPTION:**

WORK TO BE PERFORMED UNDER THIS PROJECT INCLUDES REPLACEMENT  
 OF EXISTING BRIDGE #173 ON VT ROUTE 100, A TEMPORARY DETOUR AND  
 ALL NECESSARY ROADWAY, CHANNEL, AND APPROACH WORK.


# STATE OF VERMONT AGENCY OF TRANSPORTATION



## PROPOSED IMPROVEMENT BRIDGE PROJECT TOWN OF WARREN COUNTY OF WASHINGTON VT ROUTE 100 (MINOR ARTERIAL) - BR NO. 173

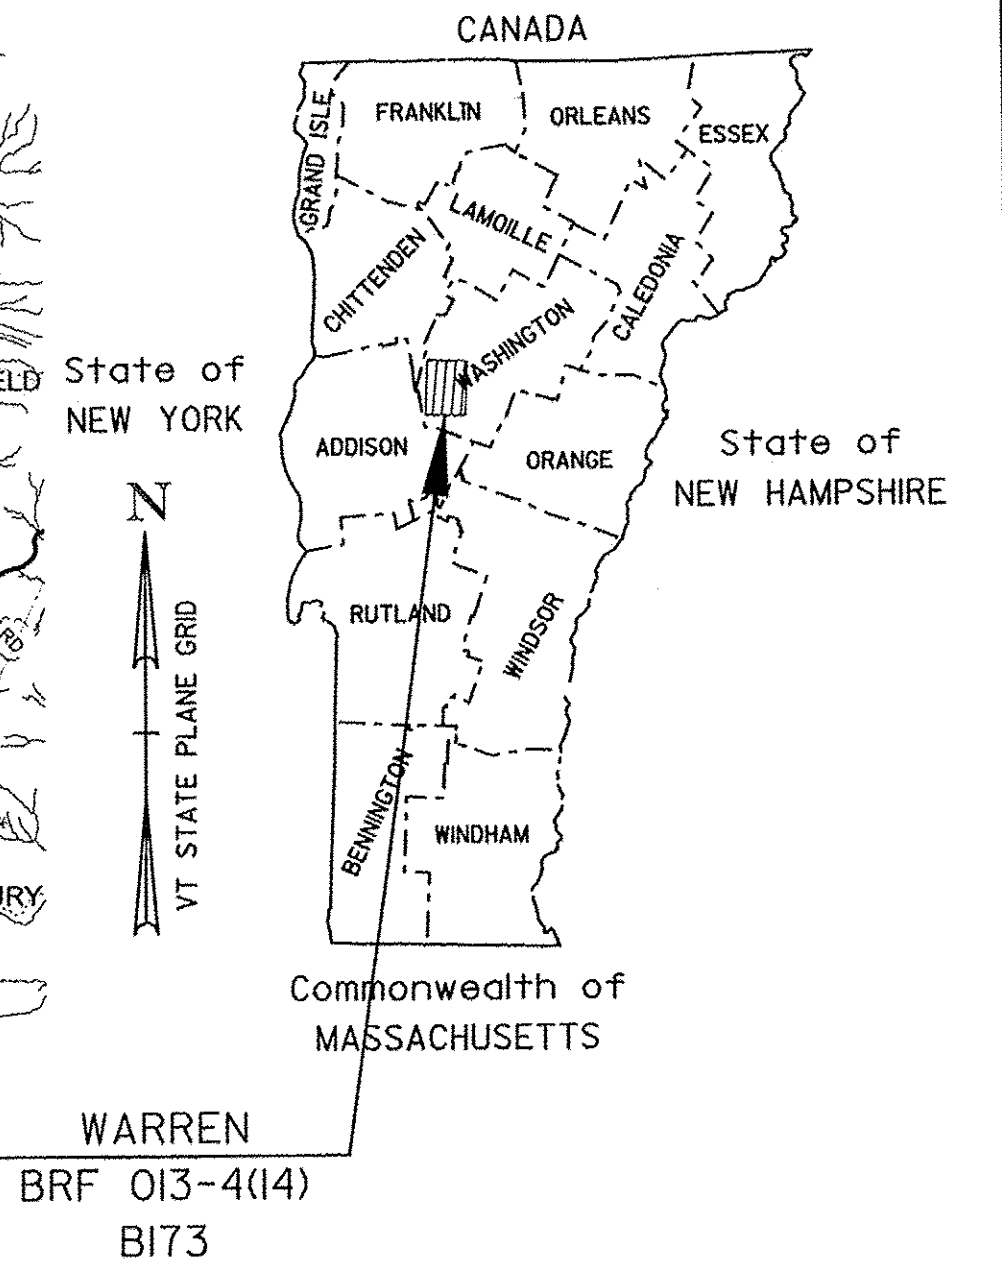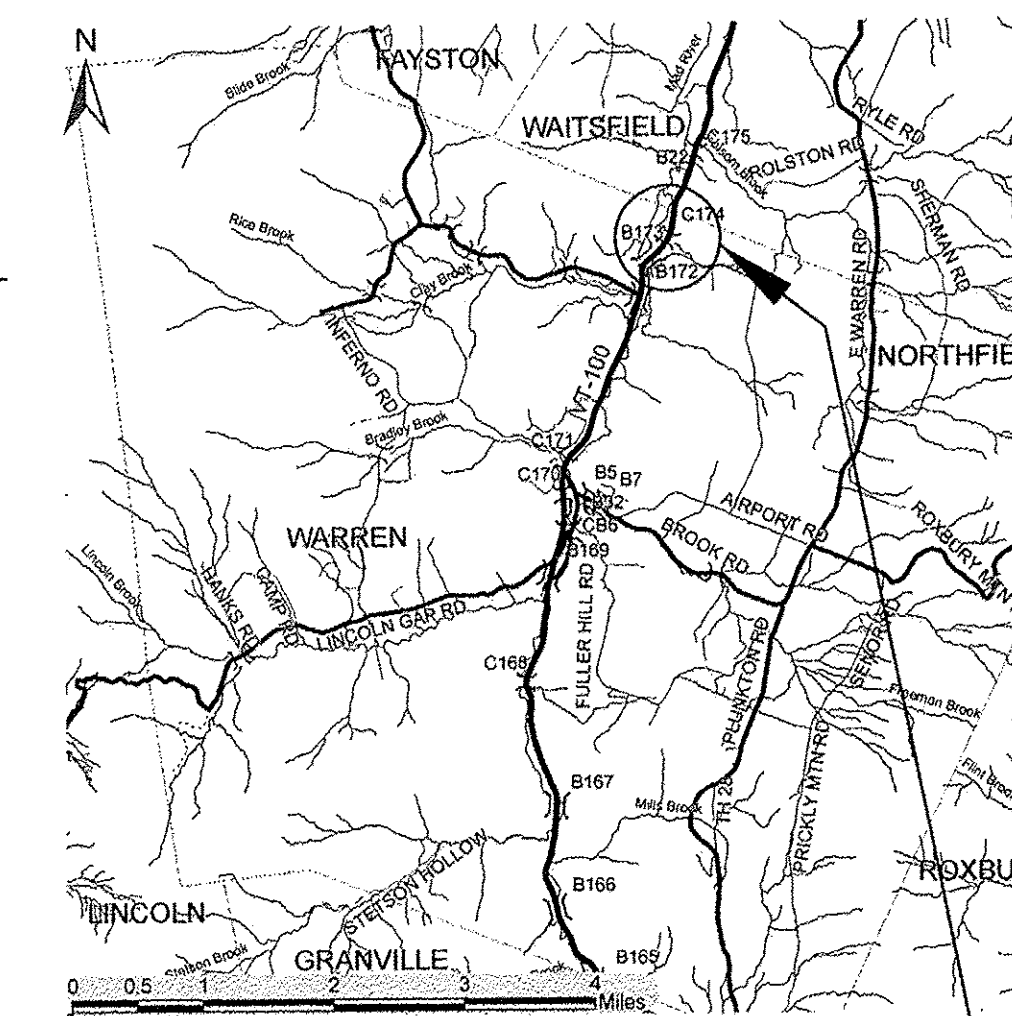

RECORD PLANS	
CONTRACTOR:	S. D. IRELAND CONC. CONST. CORP - BURLINGTON, VT
RESIDENT ENGINEER:	VICK DWIRE
CONSTRUCTION BEGAN:	NOVEMBER 2, 2012
CONSTRUCTION COMPLETE:	JUNE 14, 2014
RECORD PLANS BY:	VICK DWIRE & JENNA HYDE
I HEREBY CERTIFY THAT ALL THE CONSTRUCTION REQUIRED BY THIS SET OF DRAWINGS HAS BEEN ACCOMPLISHED AS INDICATED HEREIN.	
BY:	<i>[Signature]</i> RESIDENT ENGINEER
DATE:	4/8/16
NOTE: Any further information concerning final quantities, amounts or other details relative to this project may be found at Central Files in the electronic archives.	

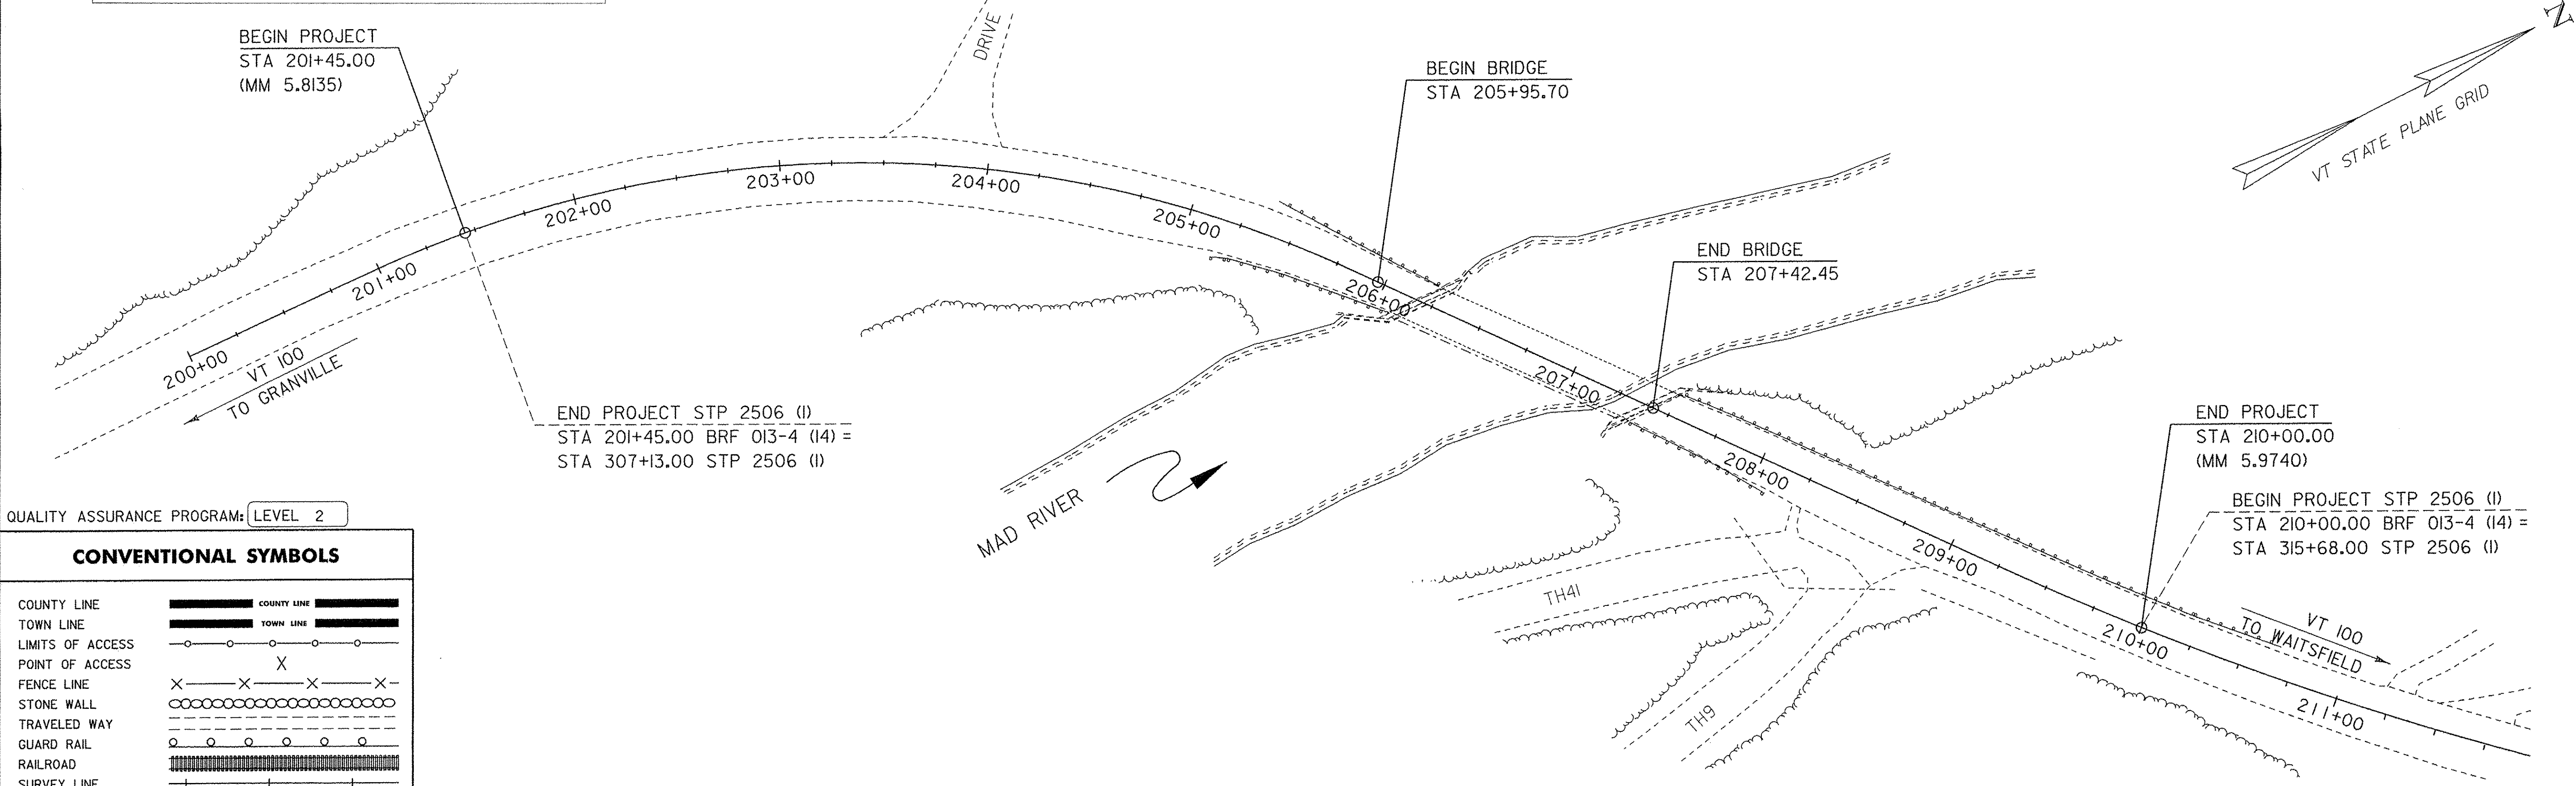


QUALITY ASSURANCE PROGRAM: LEVEL 2

CONVENTIONAL SYMBOLS	
COUNTY LINE	
TOWN LINE	
LIMITS OF ACCESS	
POINT OF ACCESS	
FENCE LINE	
STONE WALL	
TRAVELED WAY	
GUARD RAIL	
RAILROAD	
SURVEY LINE	
CULVERT	
POWER POLE	
TELEPHONE POLE	
TREES	
CONTROL OF ACCESS	
PROPERTY LINE	
R.O.W. TAKING LINE	
SLOPE RIGHTS	
TOP OF CUT	
TOE OF SLOPE	

SURVEYED BY : R. D. GILMAN  
 SURVEYED DATE : NOV. 1995

DATUM  
 VERTICAL NAVD 88  
 HORIZONTAL NAD 83 (07)

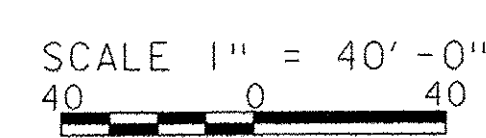

THESE PLANS ARE SUBJECT TO SUCH ENGINEERING CHANGES AS MAY BE REQUIRED BY THE FEDERAL HIGHWAY ADMINISTRATION OR THE DIRECTOR OF PROGRAM DEVELOPMENT.

CONSTRUCTION IS TO BE CARRIED ON IN ACCORDANCE WITH THESE PLANS AND THE STANDARD SPECIFICATIONS FOR CONSTRUCTION DATED 2011, AS APPROVED BY THE FEDERAL HIGHWAY ADMINISTRATION ON JULY 20, 2011 FOR USE ON THIS PROJECT, INCLUDING ALL SUBSEQUENT REVISIONS AND SUCH REVISED SPECIFICATIONS AND SPECIAL PROVISIONS AS ARE INCORPORATED IN THESE PLANS.

DIRECTOR OF PROGRAM DEVELOPMENT	
APPROVED:	<i>[Signature]</i> DATE 7.30-12
PROJECT MANAGER : J. LACROIX	
PROJECT NAME : WARREN	
PROJECT NUMBER : BR F 013-4 (14)	
SHEET 1 OF 83 SHEETS	