


SAFETY EDGE DETAIL

NOT TO SCALE


NOTE: LEVELING COURSE MAY INCLUDE THE "SAFETY EDGE" AT THE CONTRACTOR'S CHOICE.

TOWN HIGHWAY AND DRIVES
 1 1/2" BITUMINOUS CONCRETE PAVEMENT TYPE IVS
 3" BITUMINOUS CONCRETE PAVEMENT TYPE IIIS
 18" SUBBASE OF DENSE GRADED CRUSHED STONE
 EMULSIFIED ASPHALT TO BE APPLIED AT A RATE OF 0.025 GAL/SY BETWEEN SUCCESSIVE COURSES OF PAVEMENT AS DIRECTED BY THE ENGINEER.

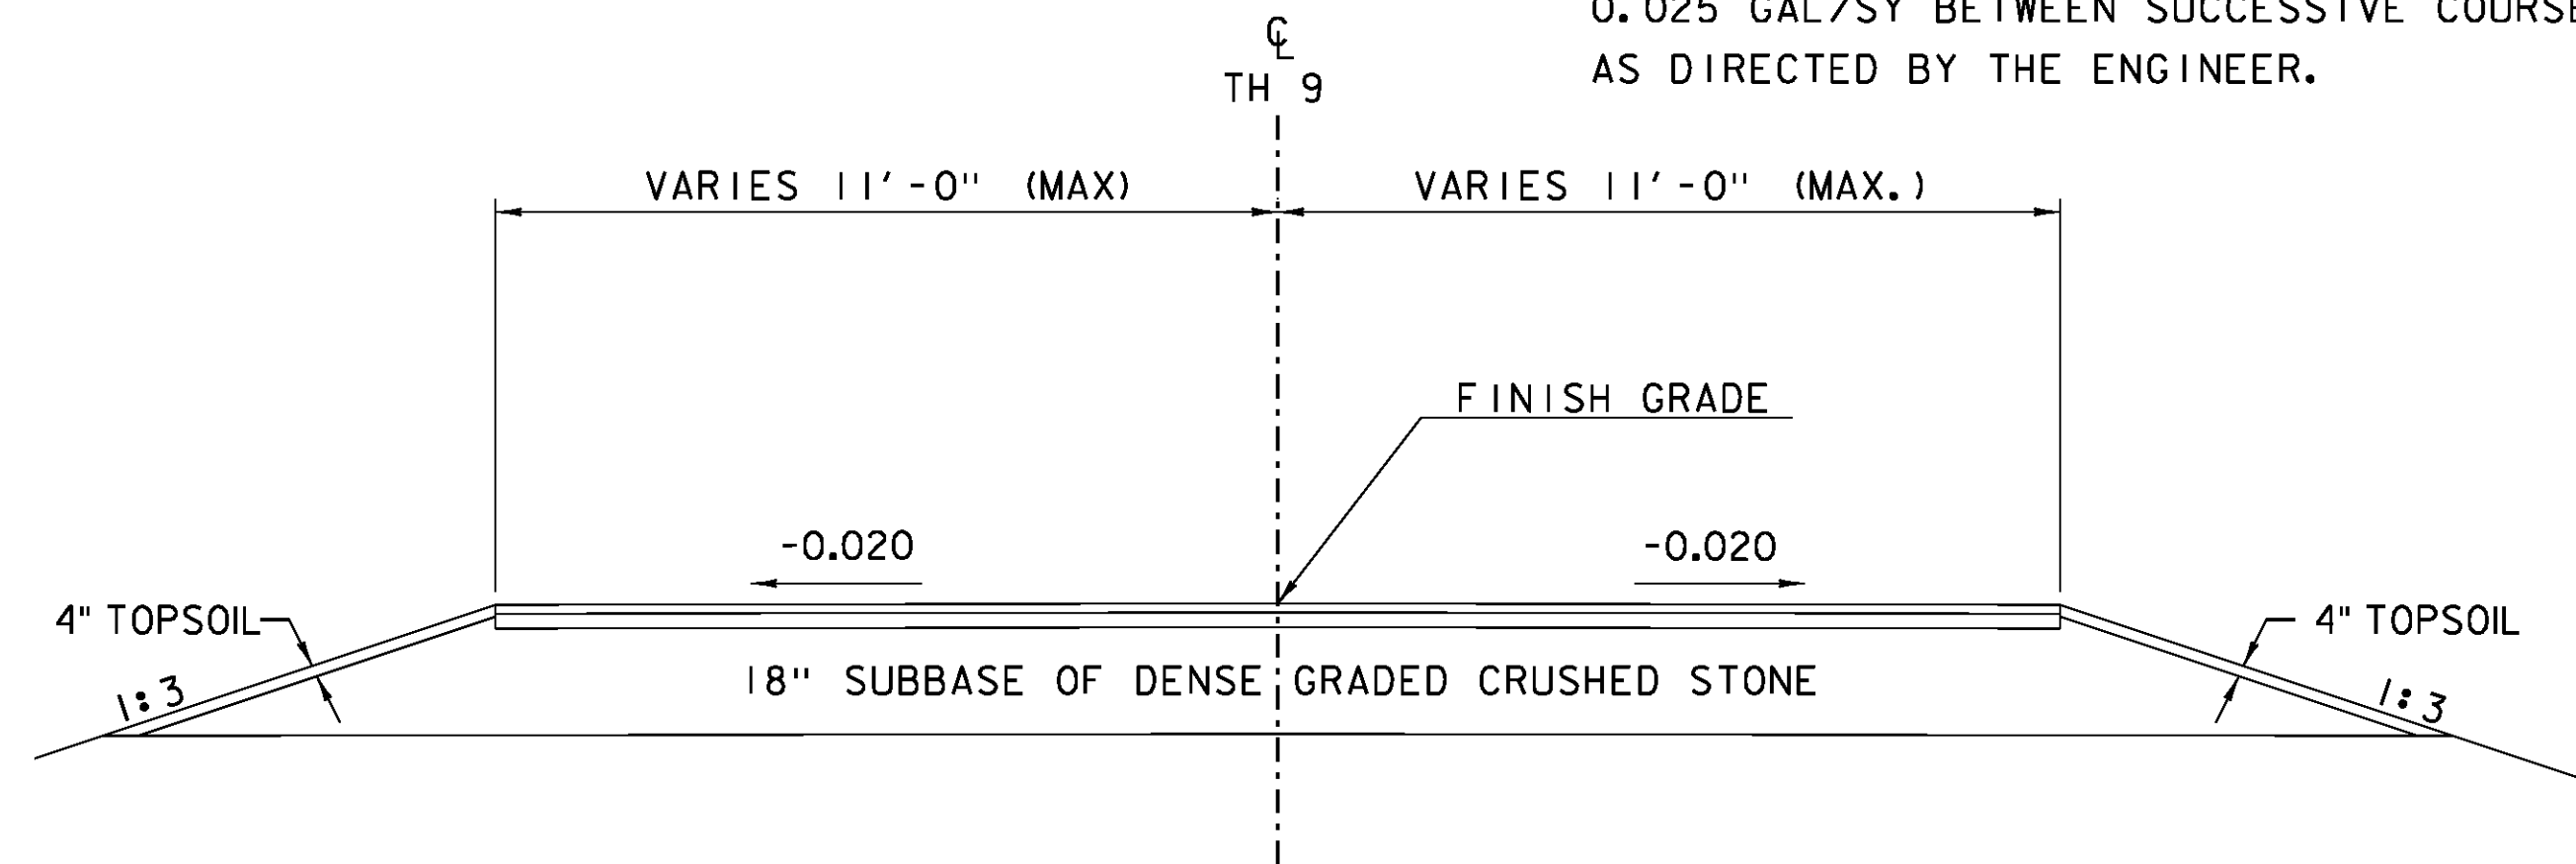

TH 9 TYPICAL

SCALE 3/8" = 1'-0"

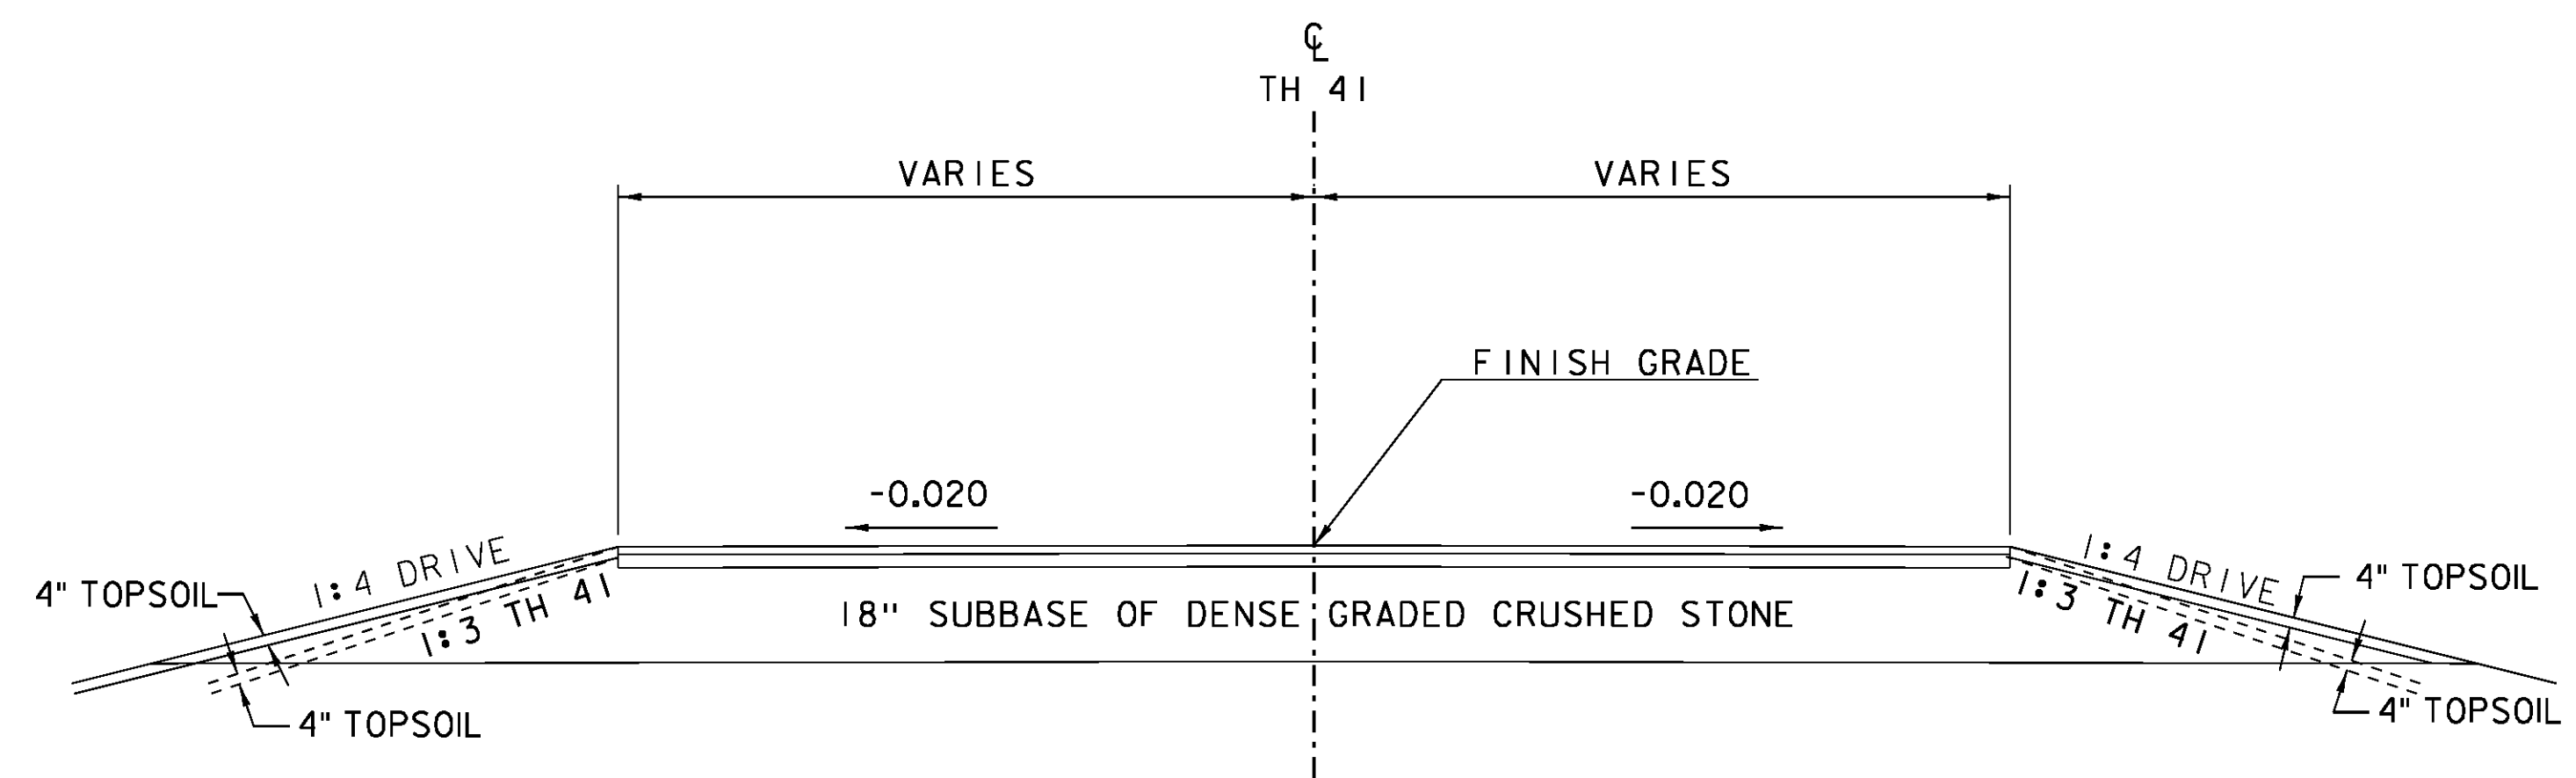

TH 41 & DRIVE TYPICAL

SCALE 3/8" = 1'-0"

MATERIAL TOLERANCES

(IF USED ON PROJECT)

SURFACE	
- PAVEMENT (TOTAL THICKNESS)	+/- 1/4"
- AGGREGATE SURFACE COURSE	+/- 1/2"
SUBBASE	+/- 1"
SAND BORROW	+/- 1"

PROJECT NAME: WARREN
 PROJECT NUMBER: BRF 013-4 (14)

FILE NAME: s78f242+yp.dgn
 PROJECT LEADER: J. LACROIX
 DESIGNED BY: U. STANLEY
 TYPICAL SECTIONS SHEET 2

PLOT DATE: 27-JUL-2012
 DRAWN BY: G. ROKES
 CHECKED BY: U. STANLEY
 SHEET 6 OF 83