

REMOVAL AND DISPOSAL OF GUARDRAIL
 STA 205+50.00 TO STA 206+50.00 LT
 STA 205+50.00 TO STA 206+24.00 RT
 STA 207+53.52 TO STA 210+67.82 LT
 STA 207+34.59 TO STA 208+07.79 RT

BOX BEAM GUARDRAIL
 STA 205+50.00 TO STA 205+78.62 LT
 STA 207+93.10 TO STA 208+97.92 LT
 STA 207+59.90 TO STA 208+40.06 RT

SPECIAL PROVISION (BRIDGE RAILING,
 GALVANIZED 2 RAIL BOX BEAM/CURB MOUNTED)
 STA 206+10.60 TO STA 207+61.10 LT
 STA 205+77.34 TO STA 207+27.90 RT

SPECIAL PROVISION (GUARDRAIL APPROACH
 SECTION, GALVANIZED 2 RAIL BOX BEAM)
 STA 205+78.62 TO STA 206+10.60 LT
 STA 205+50.00 TO STA 205+77.34 RT
 STA 207+61.10 TO STA 207+93.10 LT
 STA 207+27.90 TO STA 207+59.90 RT

MANUFACTURED TERMINAL SECTION,
 TANGENT
 STA 208+97.92 TO STA 209+11.93 LT


COLD PLANING, BITUMINOUS PAVEMENT
 STA 210+00.00 TO STA 211+00.00

RELOCATE MAILBOX, SINGLE SUPPORT
 TH 41 STA 400+14.00 RT

RELOCATE MAILBOX, MULTIPLE SUPPORT
 TH 9 STA 300+76.00 RT (2 MAILBOX)

DELINEATOR WITH STEEL POST
 VT 100 STA 209+12.00 LT (BLUE)
 VT 100 STA 208+40.00 RT (GREEN)
 TH 9 STA 300+35.38 25.2 FT LT (WHITE)
 TH 9 STA 300+45.38 67.1 FT RT (WHITE)
 TH 41 STA 400+87.00 19.2 FT LT (WHITE)
 TH 41 STA 400+87.00 17.8 FT RT (WHITE)
 TH 41 STA 400+78.65 16.1 FT LT (WHITE)
 TH 41 STA 400+97.00 15.3 FT LT (WHITE)

SOLID ROCK EXCAVATION
 VT 100 STA 209+00 TO STA 210+00 RT

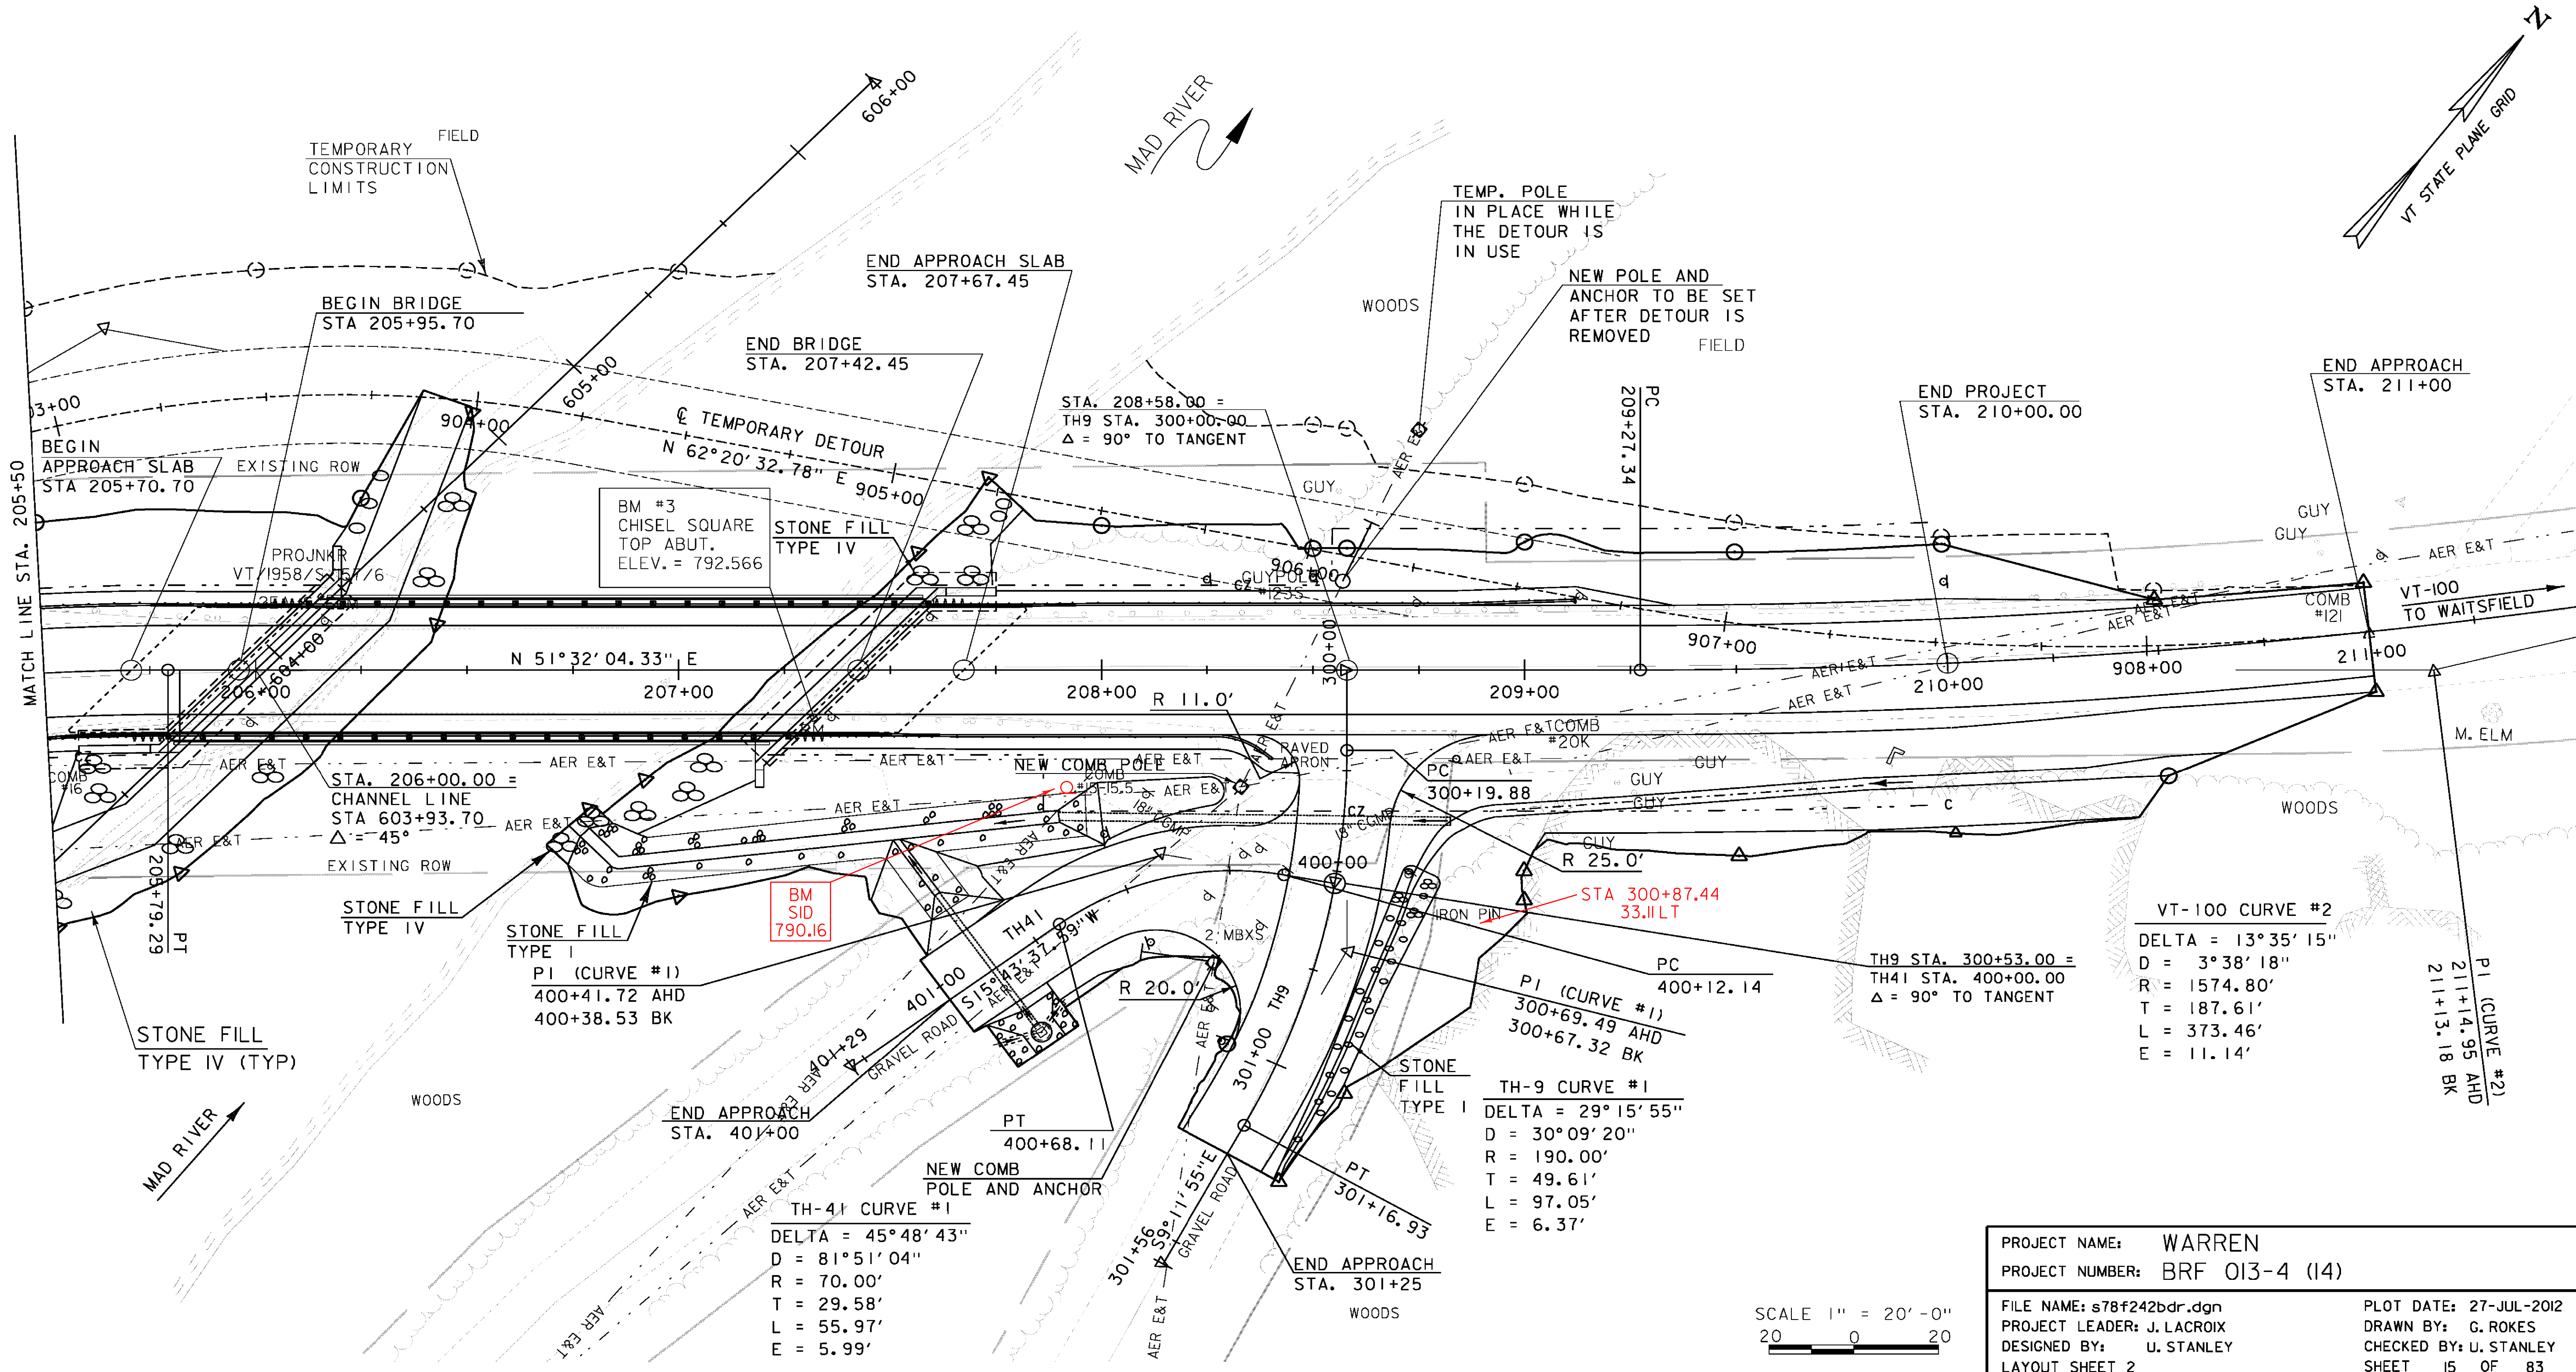

PROJECT NAME:	WARREN	PLOT DATE:	27-JUL-2012
PROJECT NUMBER:	BRF 013-4 (14)	DRAWN BY:	G. ROKES
FILE NAME:	s78f242bdr.dgn	CHECKED BY:	U. STANLEY
PROJECT LEADER:	J. LACROIX	SHEET	15 OF 83
DESIGNED BY:	U. STANLEY		
LAYOUT SHEET 2			