


PROFILE DRIVE 203+75.00

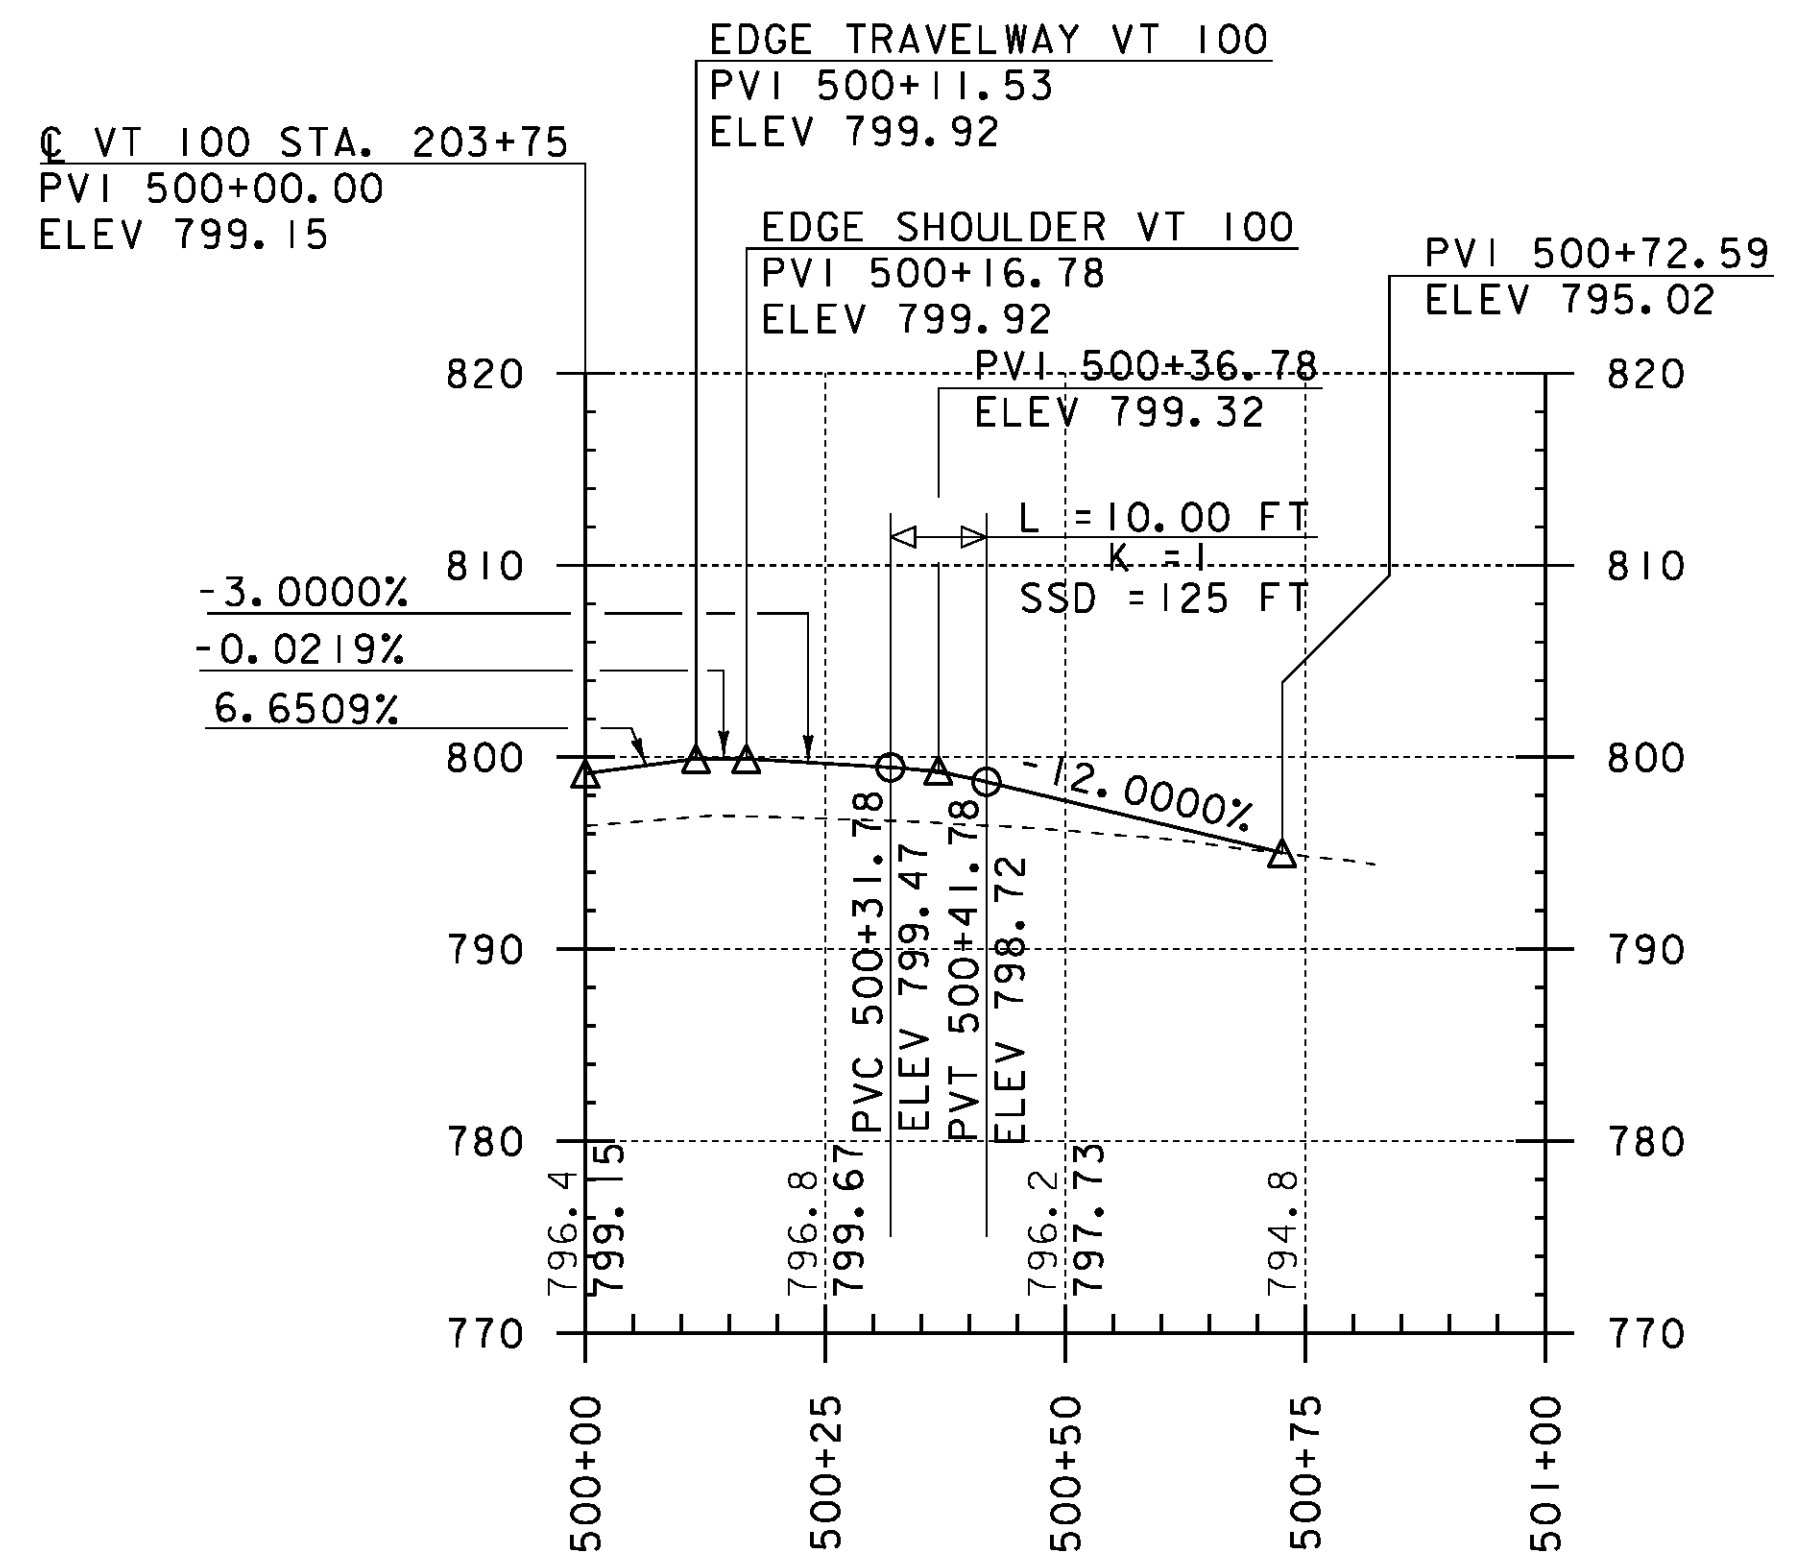

THE GRADES SHOWN TO THE NEAREST TENTH ARE THE EXISTING GROUND ELEVATIONS ALONG THE NEW ALIGNMENT. THE GRADES SHOWN TO THE NEAREST HUNDREDTH ARE THE PROPOSED GRADES FOR THE NEW ALIGNMENT.

PROJECT NAME: WARREN	
PROJECT NUMBER: BR 013-4 (14)	
FILE NAME: s78f242xs.dgn	PLOT DATE: 27-JUL-2012
PROJECT LEADER: J. LACROIX	DRAWN BY: G. ROKES
DESIGNED BY: U. STANLEY	CHECKED BY: U. STANLEY
DRIVE @ 203+91.65 PROFILE	SHEET 19 OF 83