


### STEEL HANDRAIL DETAIL

SCALE 3/4" = 1'-0"



- HANDRAIL POST, RAILS, AND BASE PLATE ARE TO BE GROUND SMOOTH AND GALVANIZED.
- OPEN POST & RAIL HANDRAIL STYLE REQUIRED DUE TO THE ELEVATION OF THE PATH RELATIVE TO HIGH WATER. POST SHALL BE SPACED AT 8'-0" CENTER TO CENTER MAX.
- PAYMENT FOR THIS RAILING AND ITS INSTALLATION WILL BE MADE UNDER CONTRACT ITEM 900.640 SPECIAL PROVISION (PEDESTRIAN HAND RAILING).

RECREATION PATH  
 5" PORTLAND CEMENT CONCRETE SIDEWALK  
 18" STONE FILL TYPE I  
 36" STONE FILL TYPE III

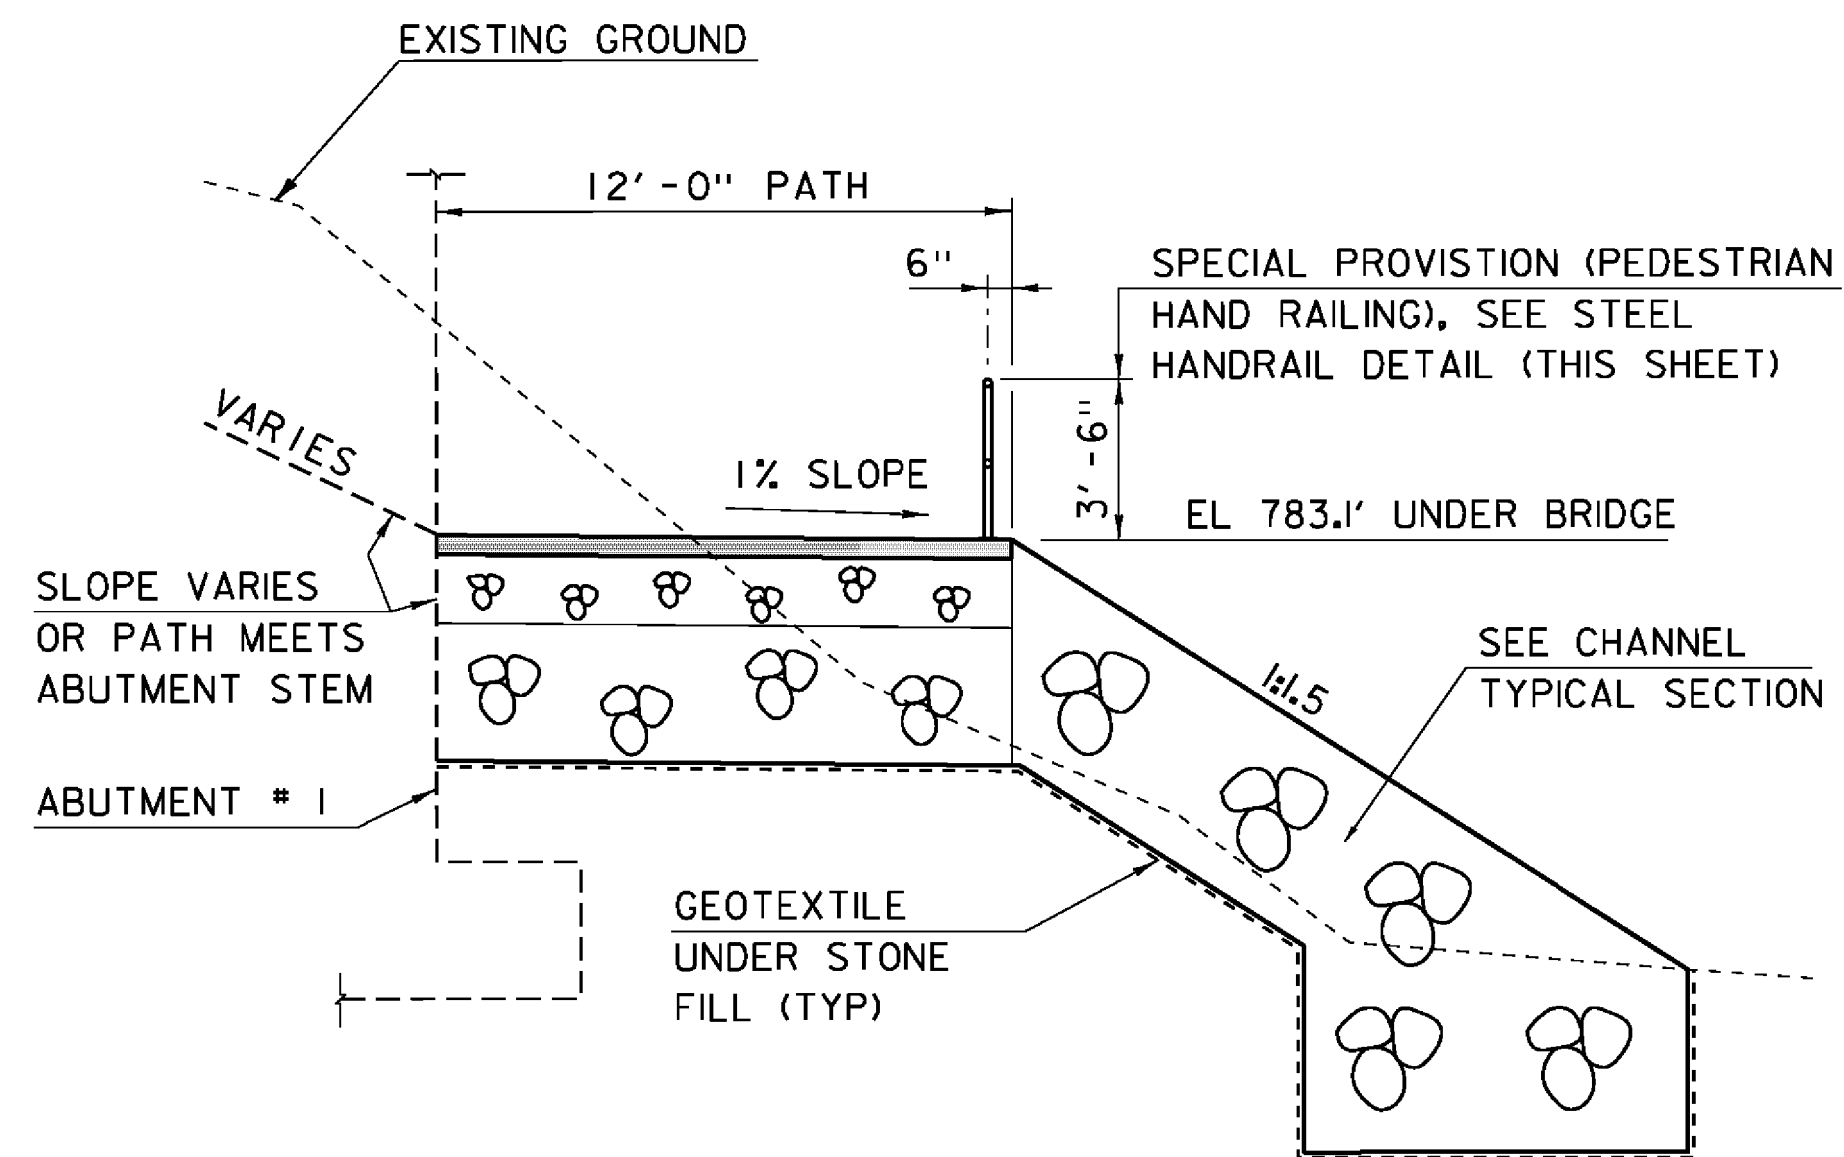

### RECREATION PATH TYPICAL

SCALE 1/4" = 1'-0"

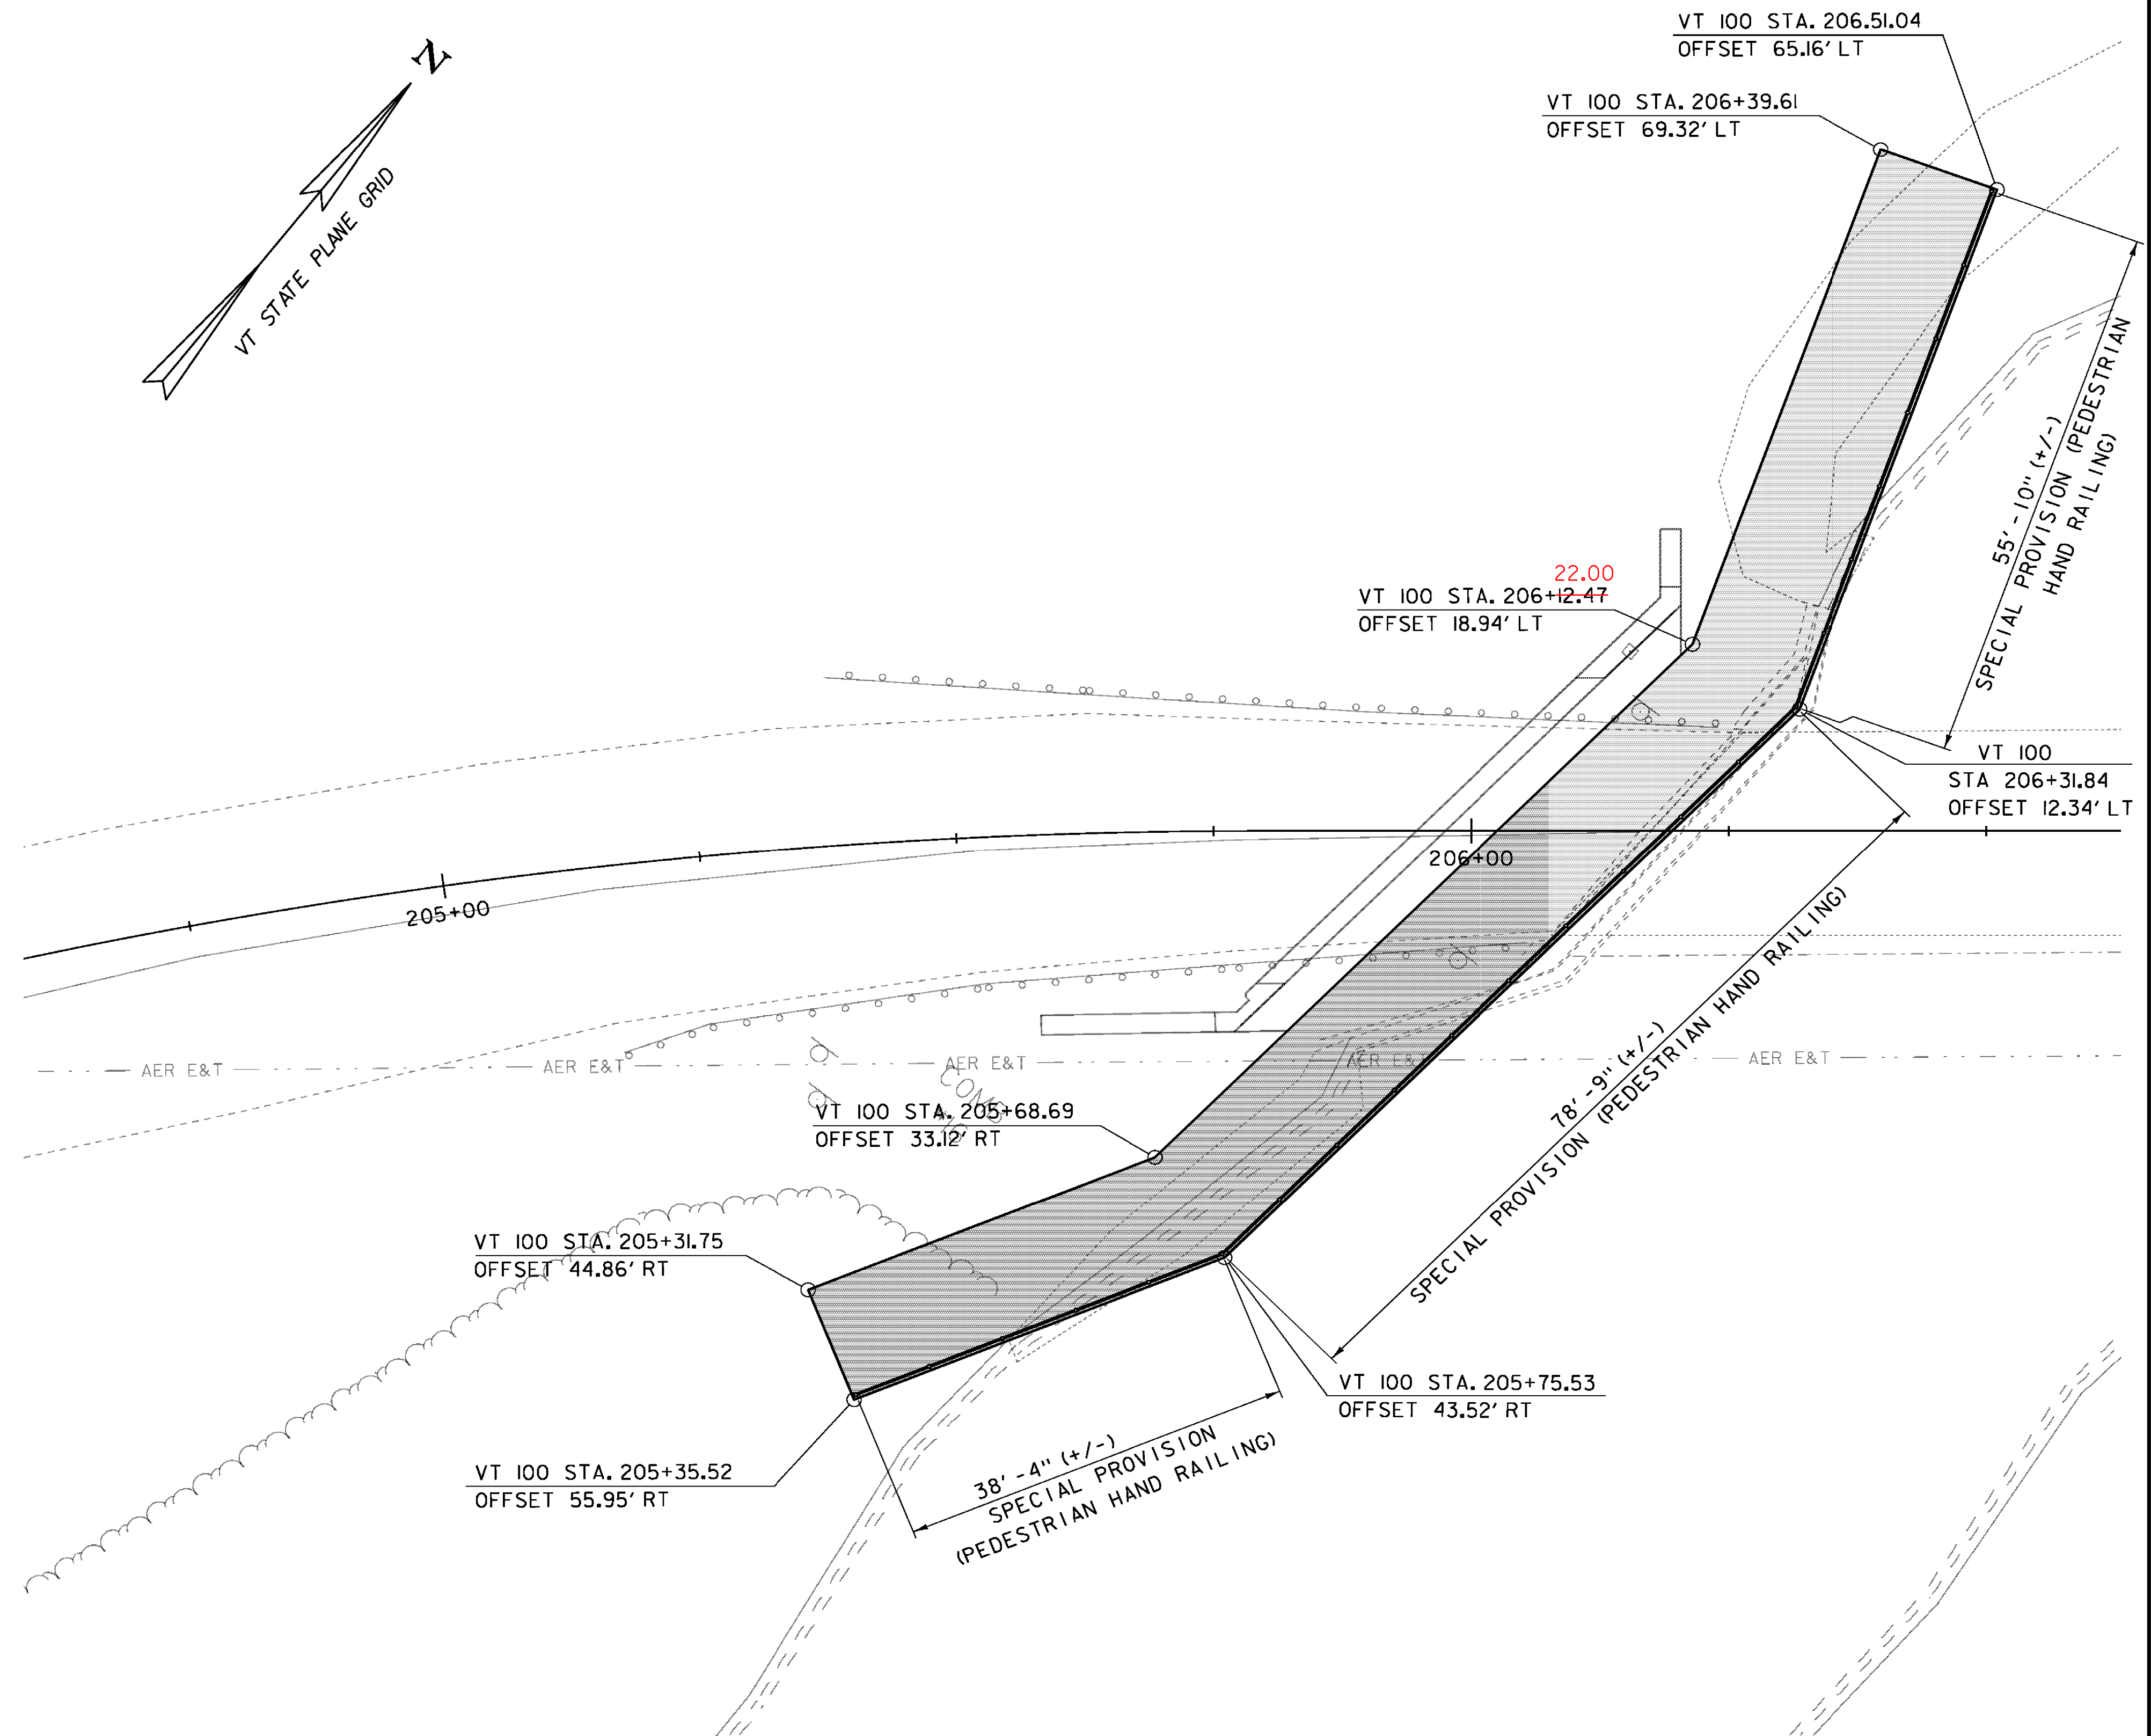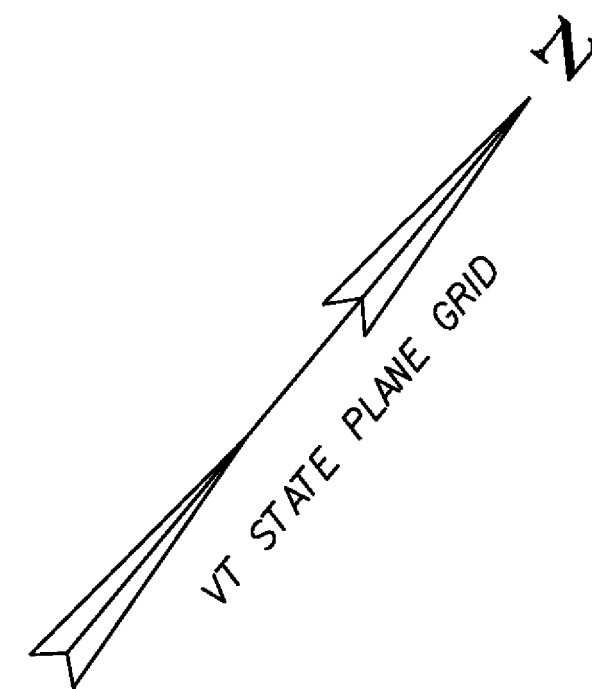

SCALE 1" = 10'-0"  
 10 0 10

PROJECT NAME:	WARREN	PLOT DATE:	27-JUL-2012
PROJECT NUMBER:	BRF 013-4(14)	DRAWN BY:	U. STANLEY
FILE NAME:	s78f242recpath.dgn	CHECKED BY:	M. LONGSTREET
PROJECT LEADER:	J. LACROIX	RECREATION PATH LAYOUT AND SECTION	SHEET 23 OF 83
DESIGNED BY:	U. STANLEY		