


SOILS INFORMATION
 WAITSFIELD SILT LOAM
 0 TO 3 PERCENT SLOPES
 NOT HIGHLY ERODIBLE

SOILS INFORMATION
 TUMBRIDGE LYMAN COMPLEX
 35 TO 60 PERCENT SLOPES
 VERY ROCKY, HIGHLY ERODIBLE

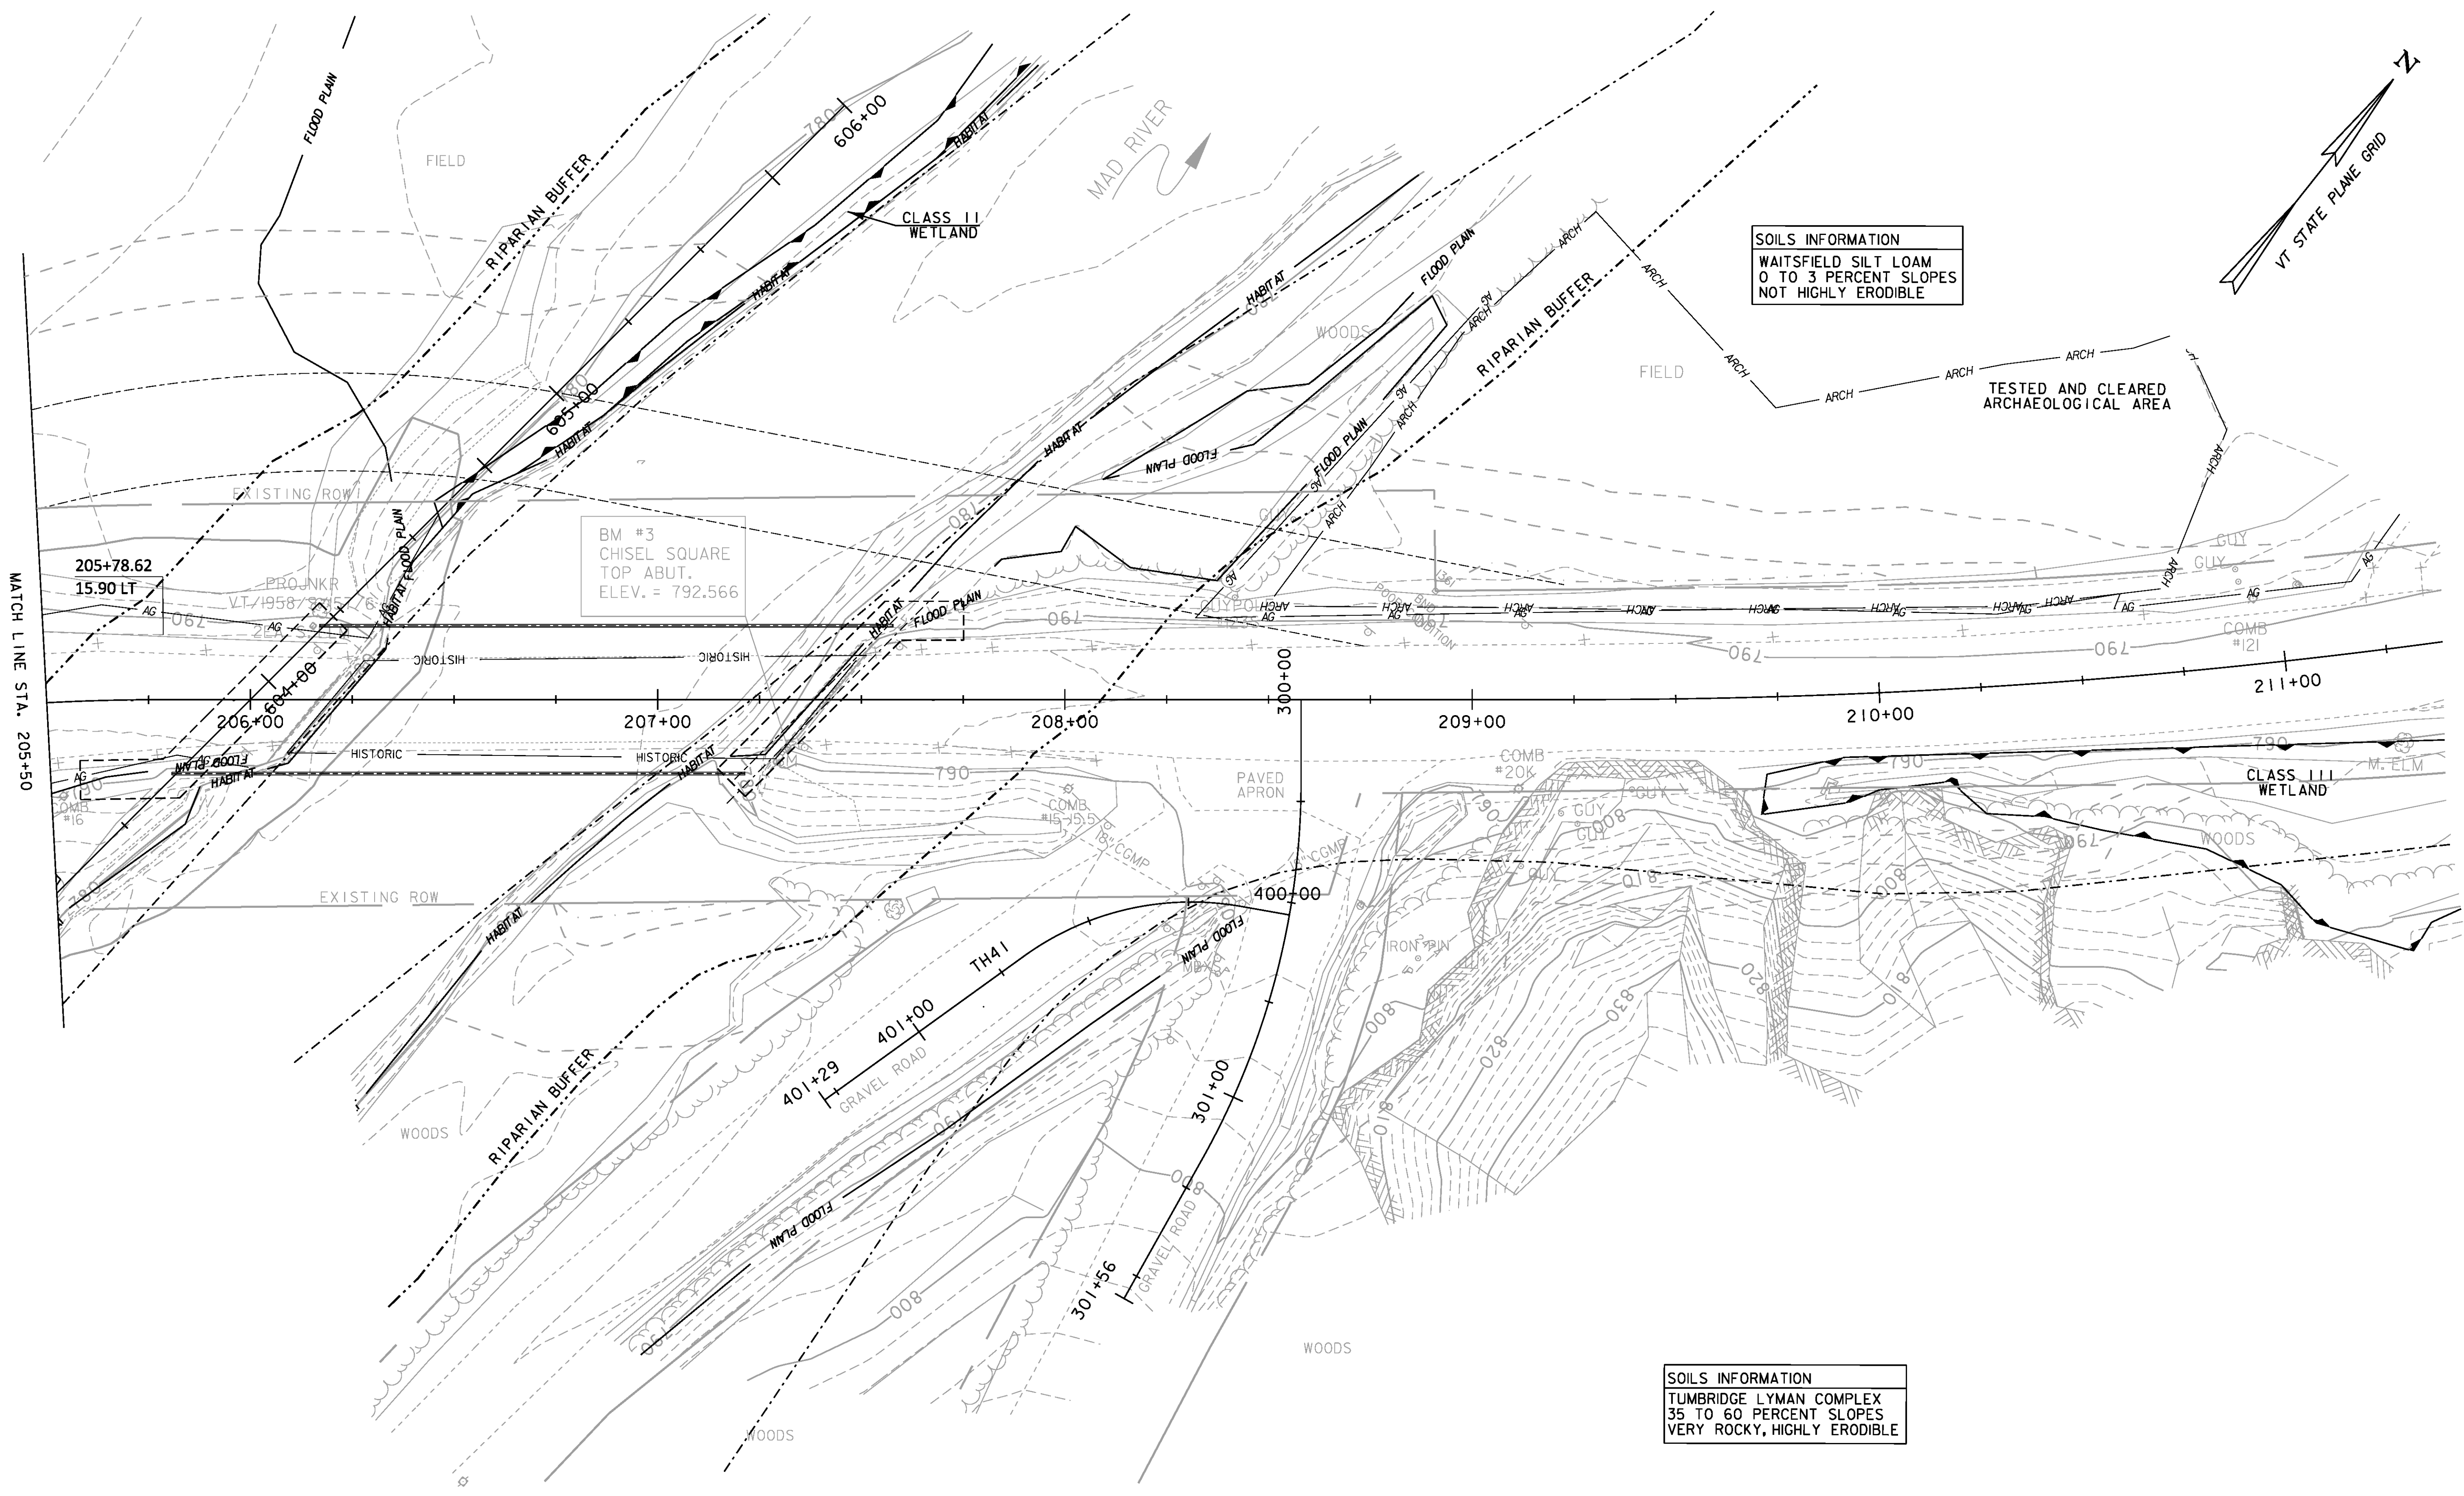

MATCH LINE STA. 205+50

BM #3
 CHISEL SQUARE
 TOP ABUT.
 ELEV. = 792.566

PROJECT NAME:	WARREN	FILE NAME:	s78f242erobdr.dgn	PLOT DATE:	27-JUL-2012
PROJECT NUMBER:	BRF 013-4 (14)	PROJECT LEADER:	J. LACROIX	DRAWN BY:	G. ROKES
		DESIGNED BY:	U. STANLEY	CHECKED BY:	M.EVANSMONGEON
		EPSC EXISTING CONDITIONS SHEET 2		SHEET 29	OF 83

SCALE 1" = 20' - 0"
 20 0 20