



SOILS INFORMATION
 WAITSFIELD SILT LOAM
 0 TO 3 PERCENT SLOPES
 NOT HIGHLY ERODIBLE

BM #21
 RRSP
 ELEV. 795.87

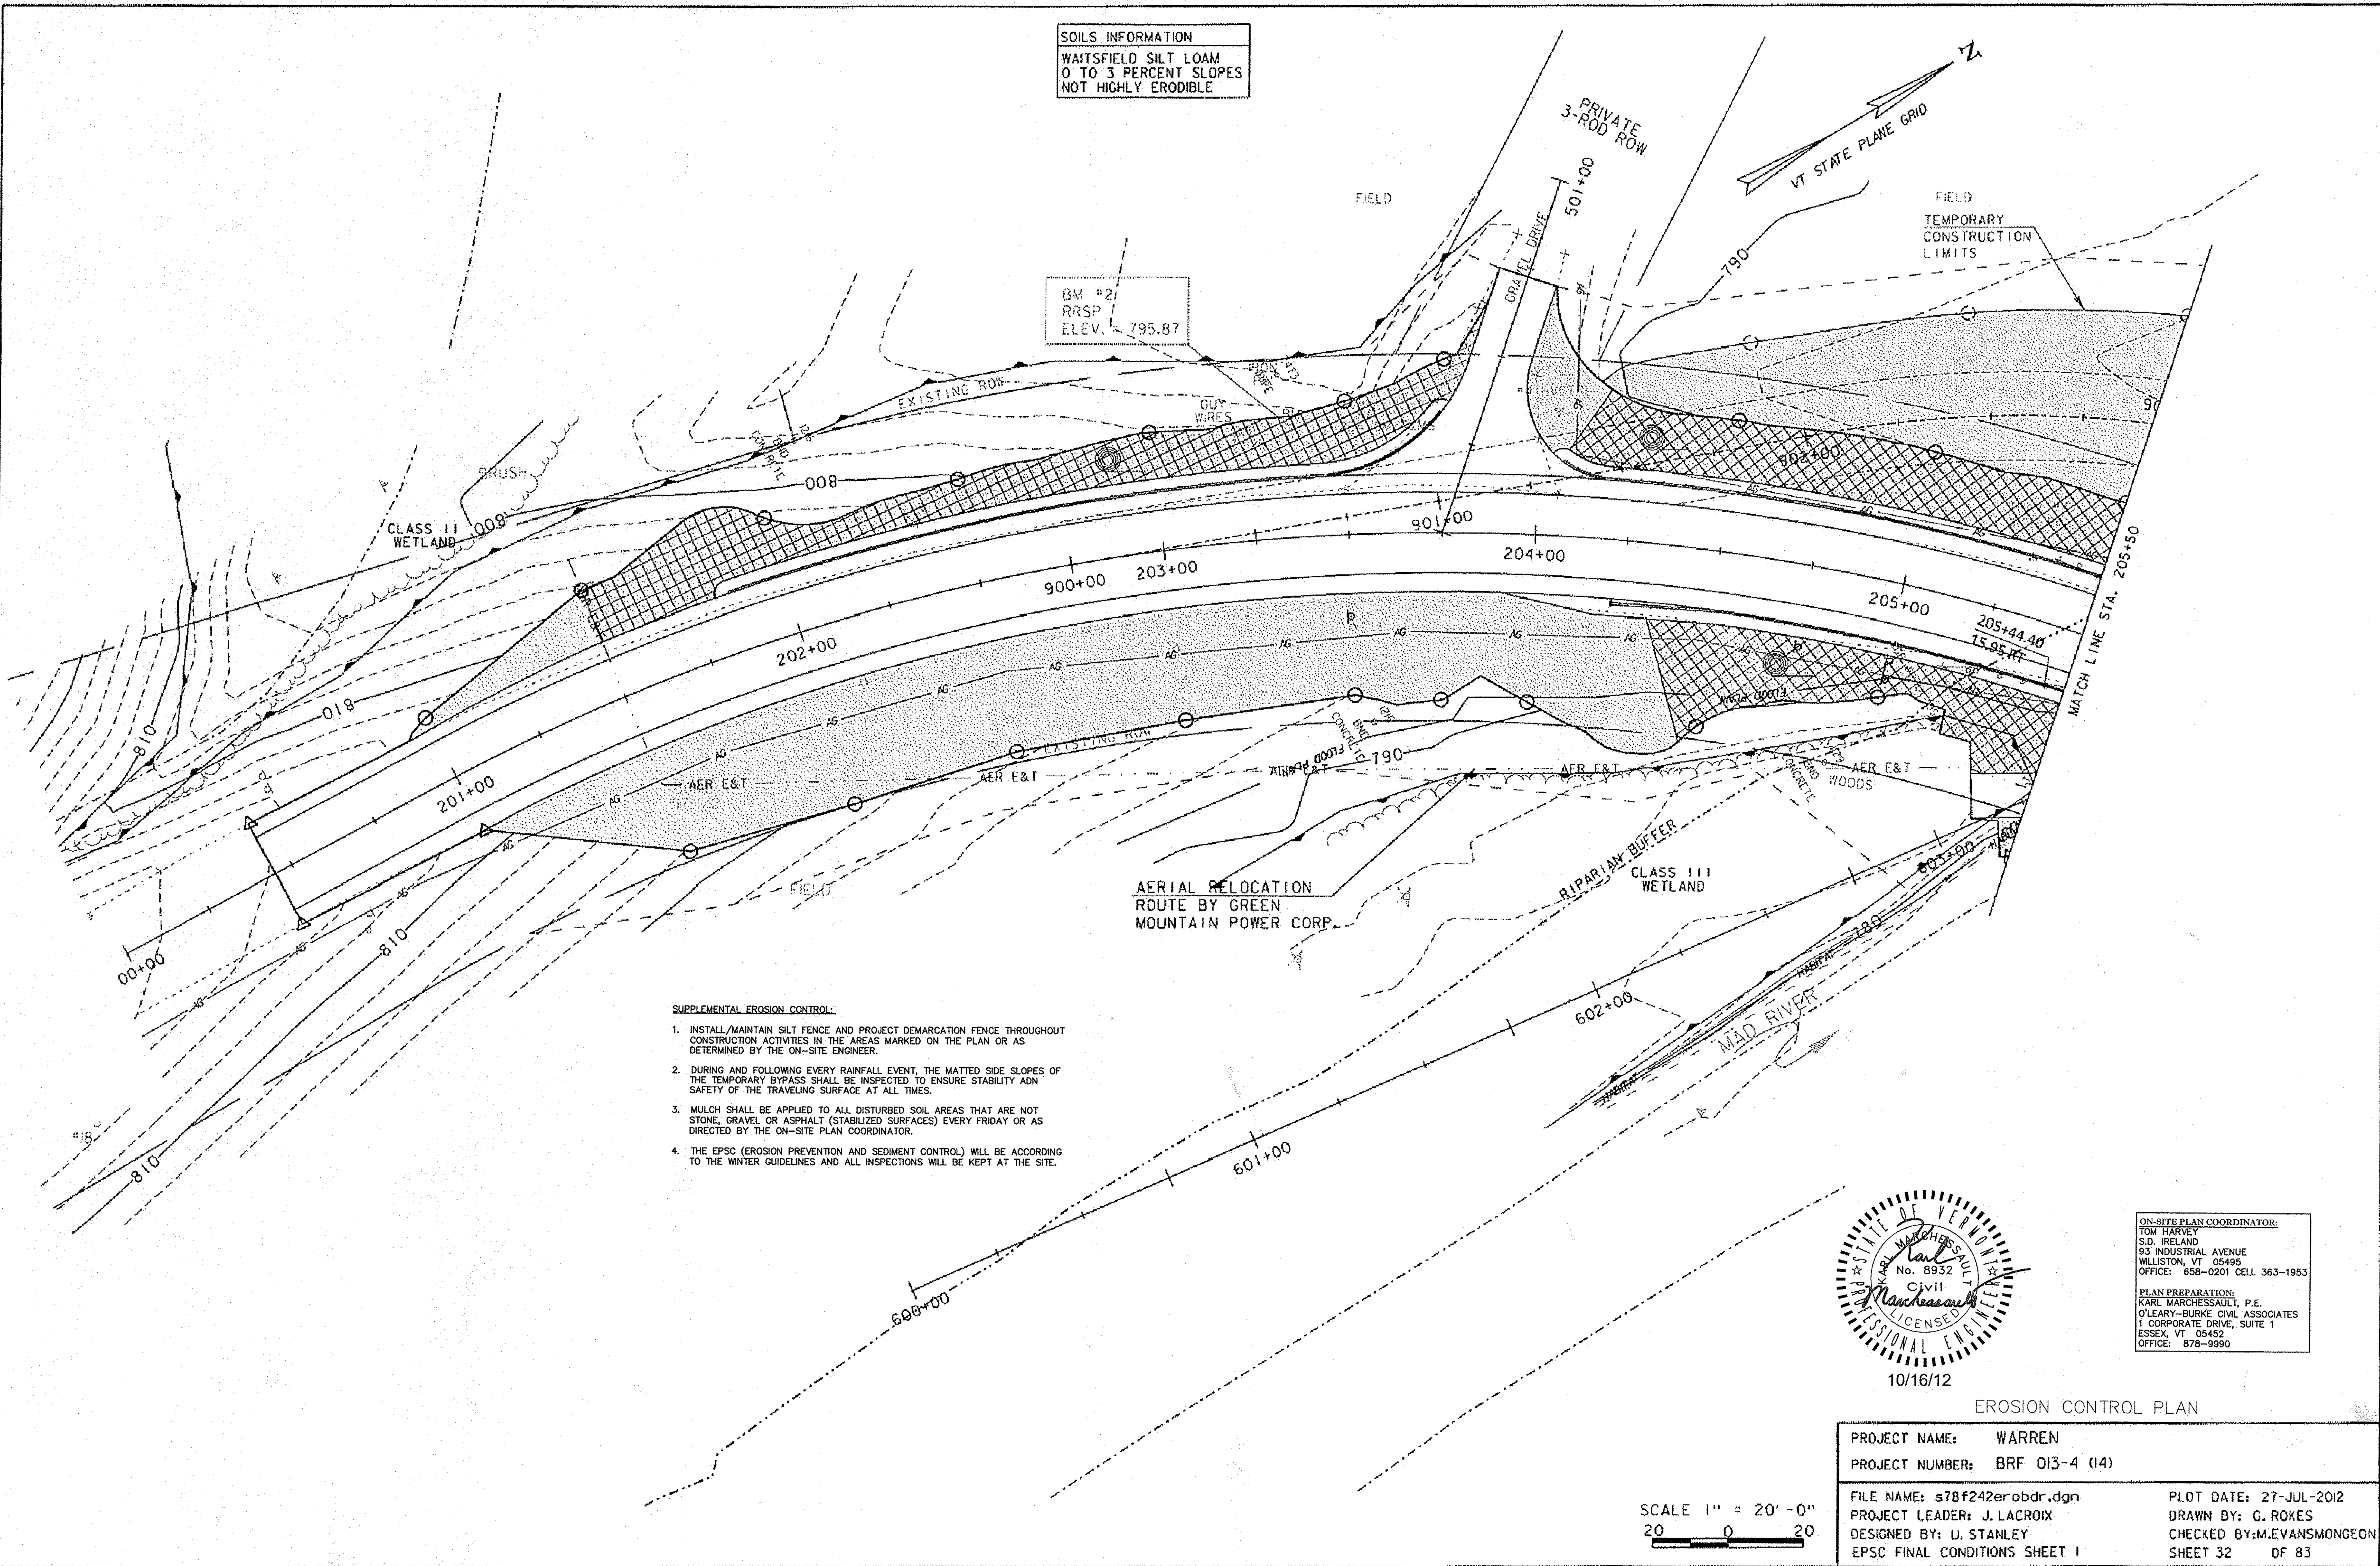

- SUPPLEMENTAL EROSION CONTROL:**
1. INSTALL/MAINTAIN SILT FENCE AND PROJECT DEMARCATION FENCE THROUGHOUT CONSTRUCTION ACTIVITIES IN THE AREAS MARKED ON THE PLAN OR AS DETERMINED BY THE ON-SITE ENGINEER.
 2. DURING AND FOLLOWING EVERY RAINFALL EVENT, THE MATTED SIDE SLOPES OF THE TEMPORARY BYPASS SHALL BE INSPECTED TO ENSURE STABILITY AND SAFETY OF THE TRAVELING SURFACE AT ALL TIMES.
 3. MULCH SHALL BE APPLIED TO ALL DISTURBED SOIL AREAS THAT ARE NOT STONE, GRAVEL OR ASPHALT (STABILIZED SURFACES) EVERY FRIDAY OR AS DIRECTED BY THE ON-SITE PLAN COORDINATOR.
 4. THE EPSC (EROSION PREVENTION AND SEDIMENT CONTROL) WILL BE ACCORDING TO THE WINTER GUIDELINES AND ALL INSPECTIONS WILL BE KEPT AT THE SITE.

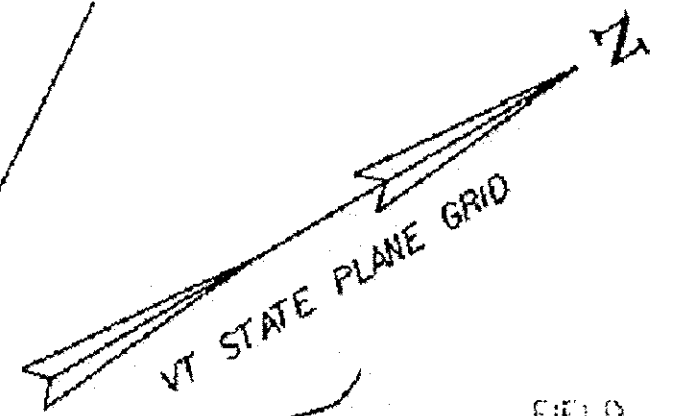

ON-SITE PLAN COORDINATOR:
 TOM HARVEY
 S.D. IRELAND
 83 INDUSTRIAL AVENUE
 WILLISTON, VT 05495
 OFFICE: 658-0201 CELL 363-1953

PLAN PREPARATION:
 KARL MARCHESSAULT, P.E.
 O'LEARY-BURKE CIVIL ASSOCIATES
 1 CORPORATE DRIVE, SUITE 1
 ESSEX, VT 05452
 OFFICE: 878-9990

10/16/12

EROSION CONTROL PLAN

| | | | | | |
|-------------------------------|----------------|-----------------|-------------------|-------------|-------------|
| PROJECT NAME: | WARREN | FILE NAME: | s78f242erobdr.dgn | PILOT DATE: | 27-JUL-2012 |
| PROJECT NUMBER: | BRF 013-4 (14) | PROJECT LEADER: | J. LACROIX | DRAWN BY: | G. ROKES |
| DESIGNED BY: | U. STANLEY | CHECKED BY: | M. EVANSMONGEON | SHEET 32 | OF 83 |
| EPSC FINAL CONDITIONS SHEET 1 | | | | | |

