



NEW AND SALVAGED SIGNS

EXISTING SIGNS

N = NEW
 R = REMOVE
 RET = RETAIN
 S = SALVAGE
 R&S = REMOVE AND SALVAGE

DURABLE 4 INCH YELLOW LINE (DOUBLE CENTER LINE)
 ML STA 200+45.00 TO STA 205+50.00
 DURABLE 4 INCH WHITE LINE
 ML STA 200+45.00 TO STA 205+50.00 LT
 ML STA 200+45.00 TO STA 205+50.00 RT

GENERAL T.I.C.S. TYPE B	→	RET
LOAD OR TACK SYMBOL	↑	RET
GENERAL T.I.C.S. TYPE A	↑	RET

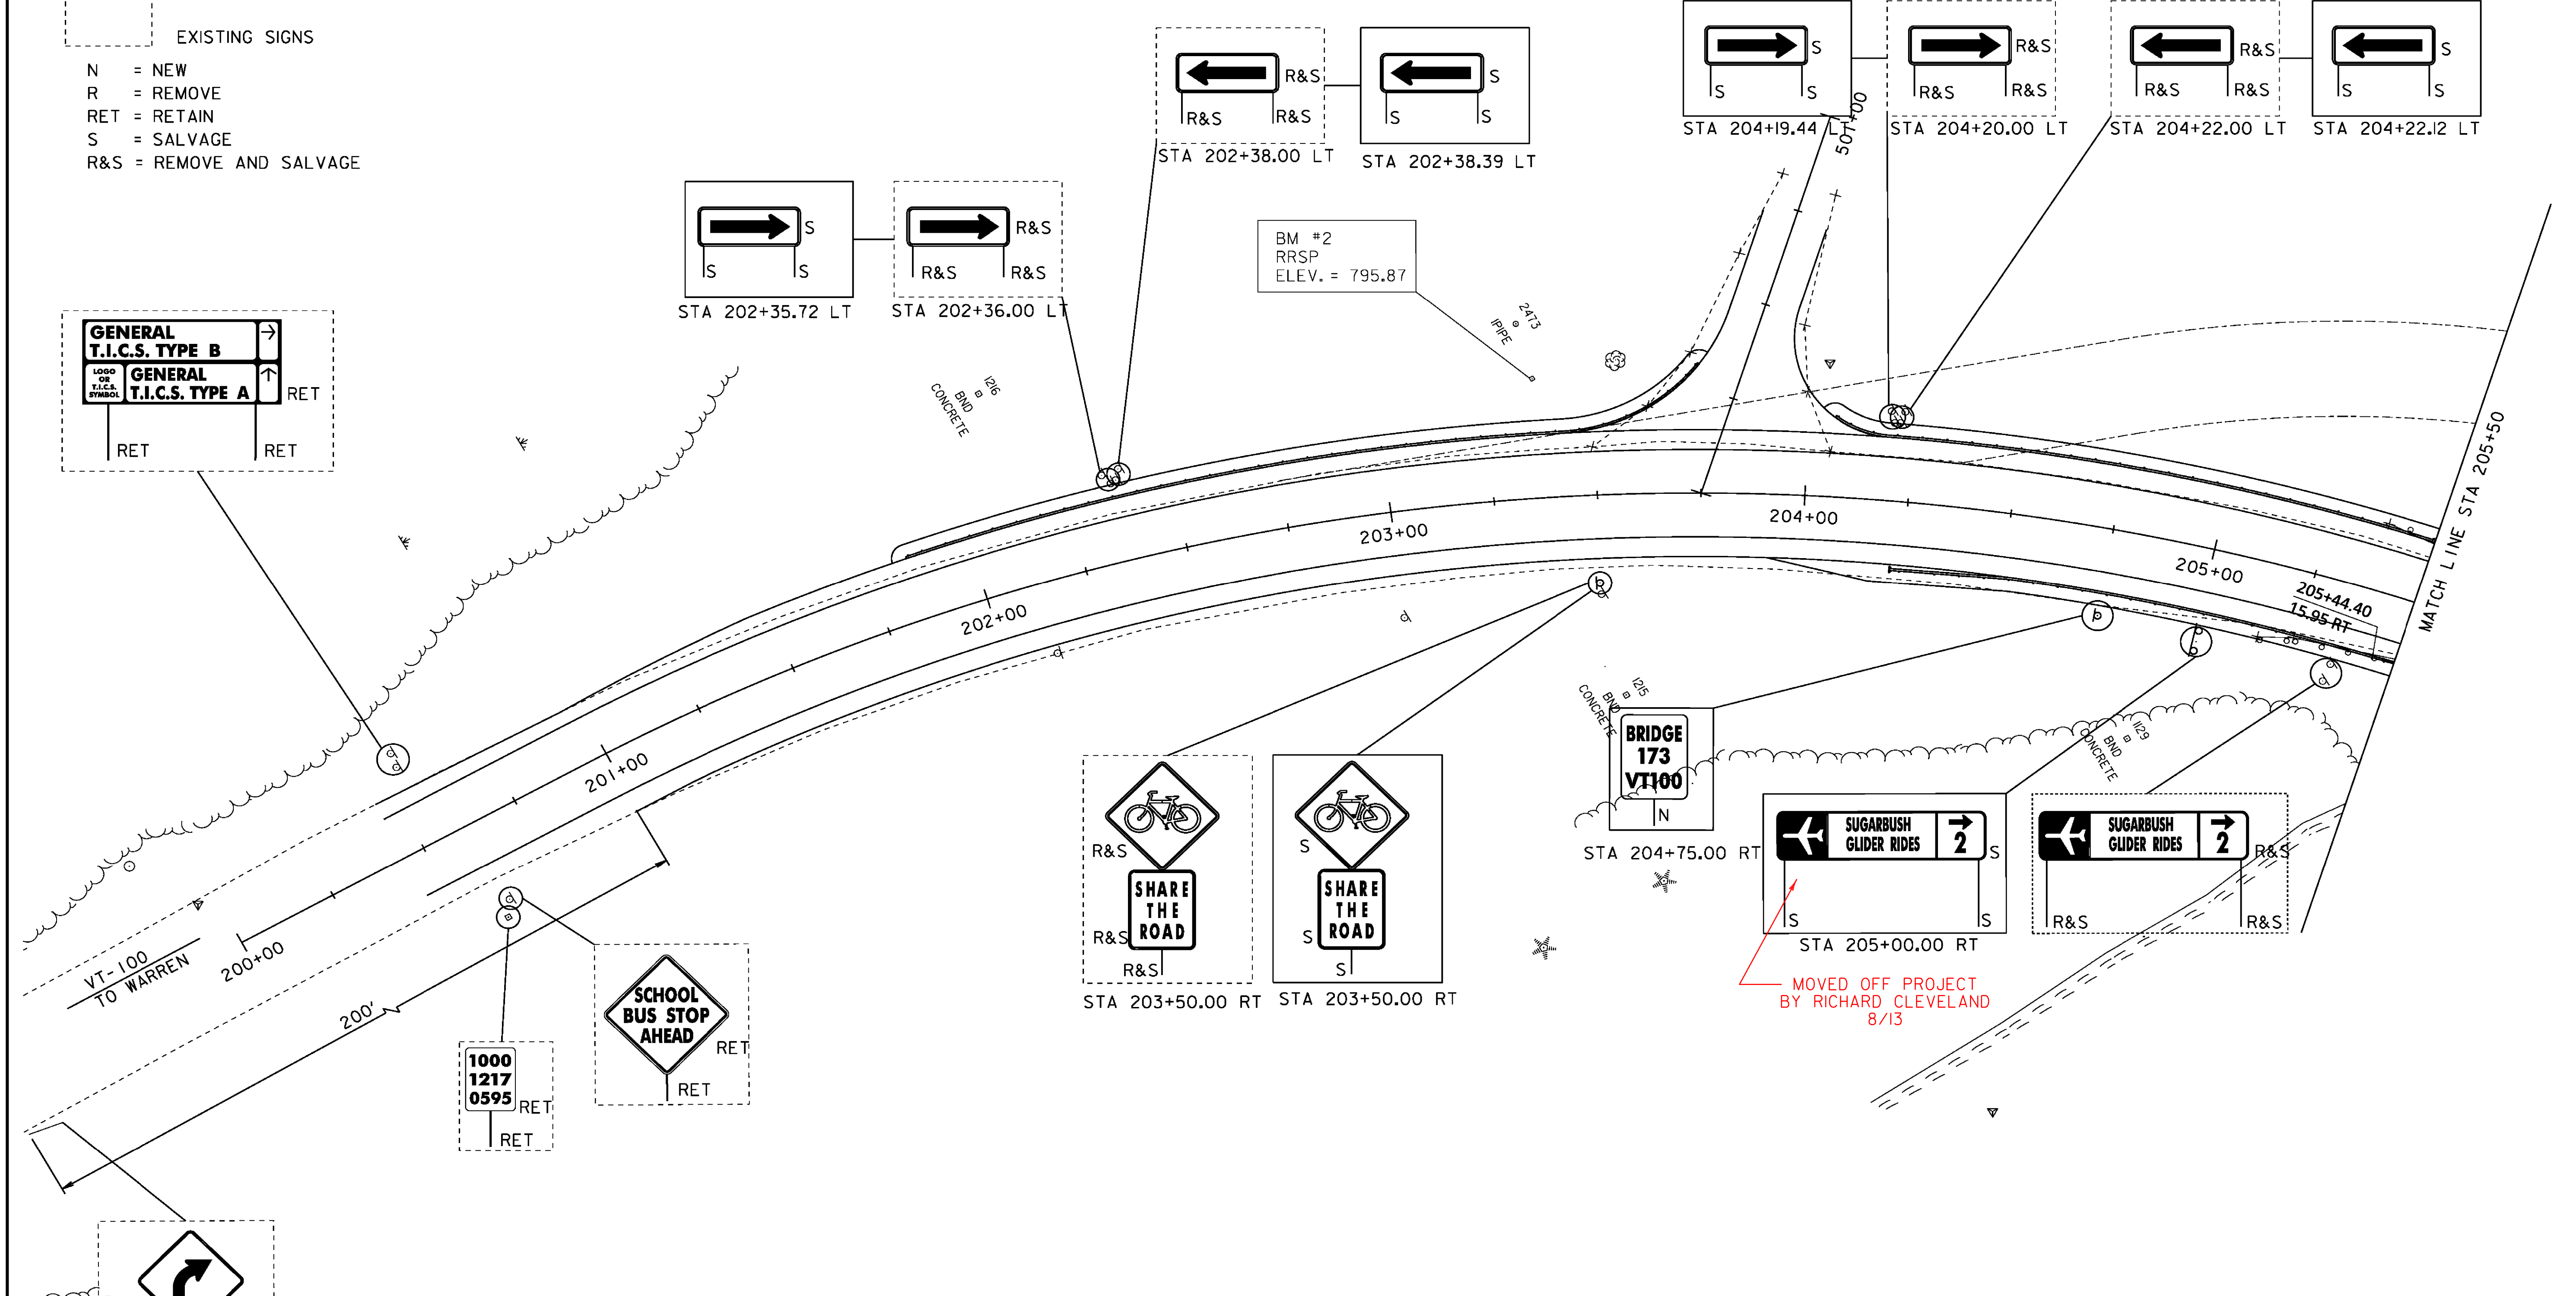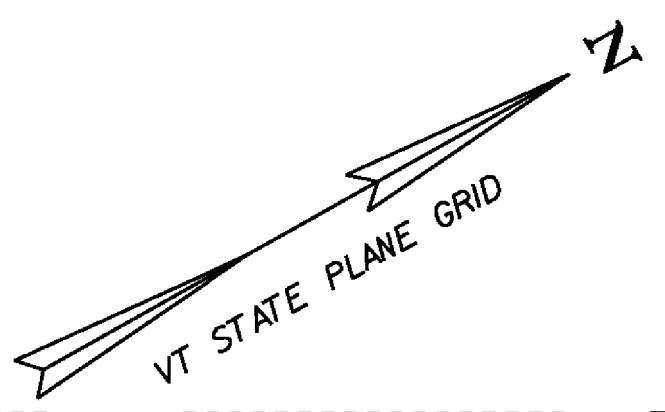

MOVED OFF PROJECT BY RICHARD CLEVELAND 8/13

RET
 RET
 RET
 RET

SCALE 1" = 20' - 0"
 20 0 20

PROJECT NAME: WARREN	PLOT DATE: 27-JUL-2012
PROJECT NUMBER: BRF 013-4 (I4)	DRAWN BY: G. ROKES
FILE NAME: s78f242signsht.dgn	CHECKED BY: U. STANLEY
PROJECT LEADER: J. LACROIX	SHEET 37 OF 83
DESIGNED BY: U. STANLEY	
TRAFFIC SIGN LAYOUT SHEET I	