




**ABUTMENT #1 PLAN VIEW**  
SCALE 1/4" = 1'-0"

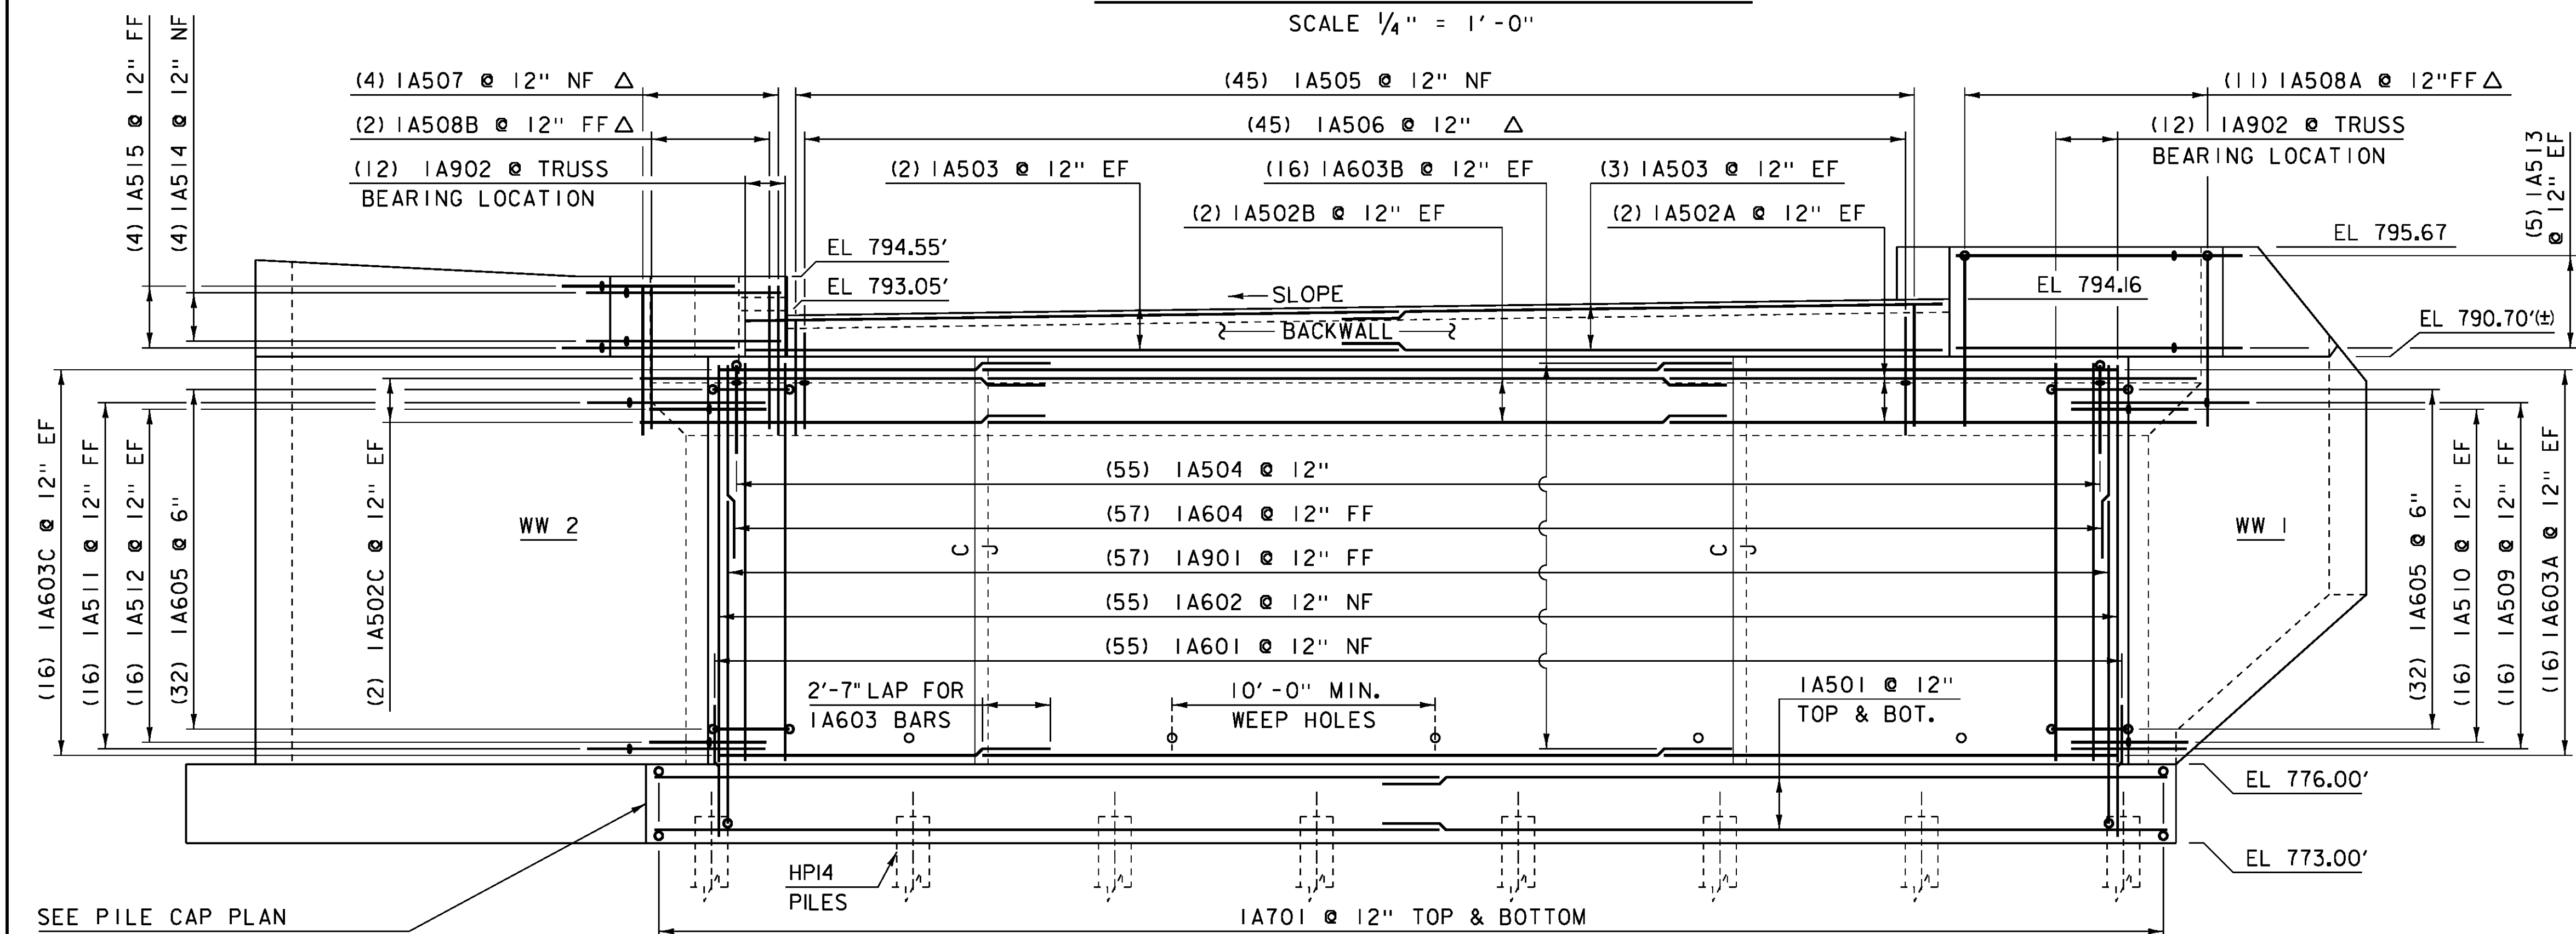

**ABUTMENT #1 ELEVATION**  
SCALE 1/4" = 1'-0"

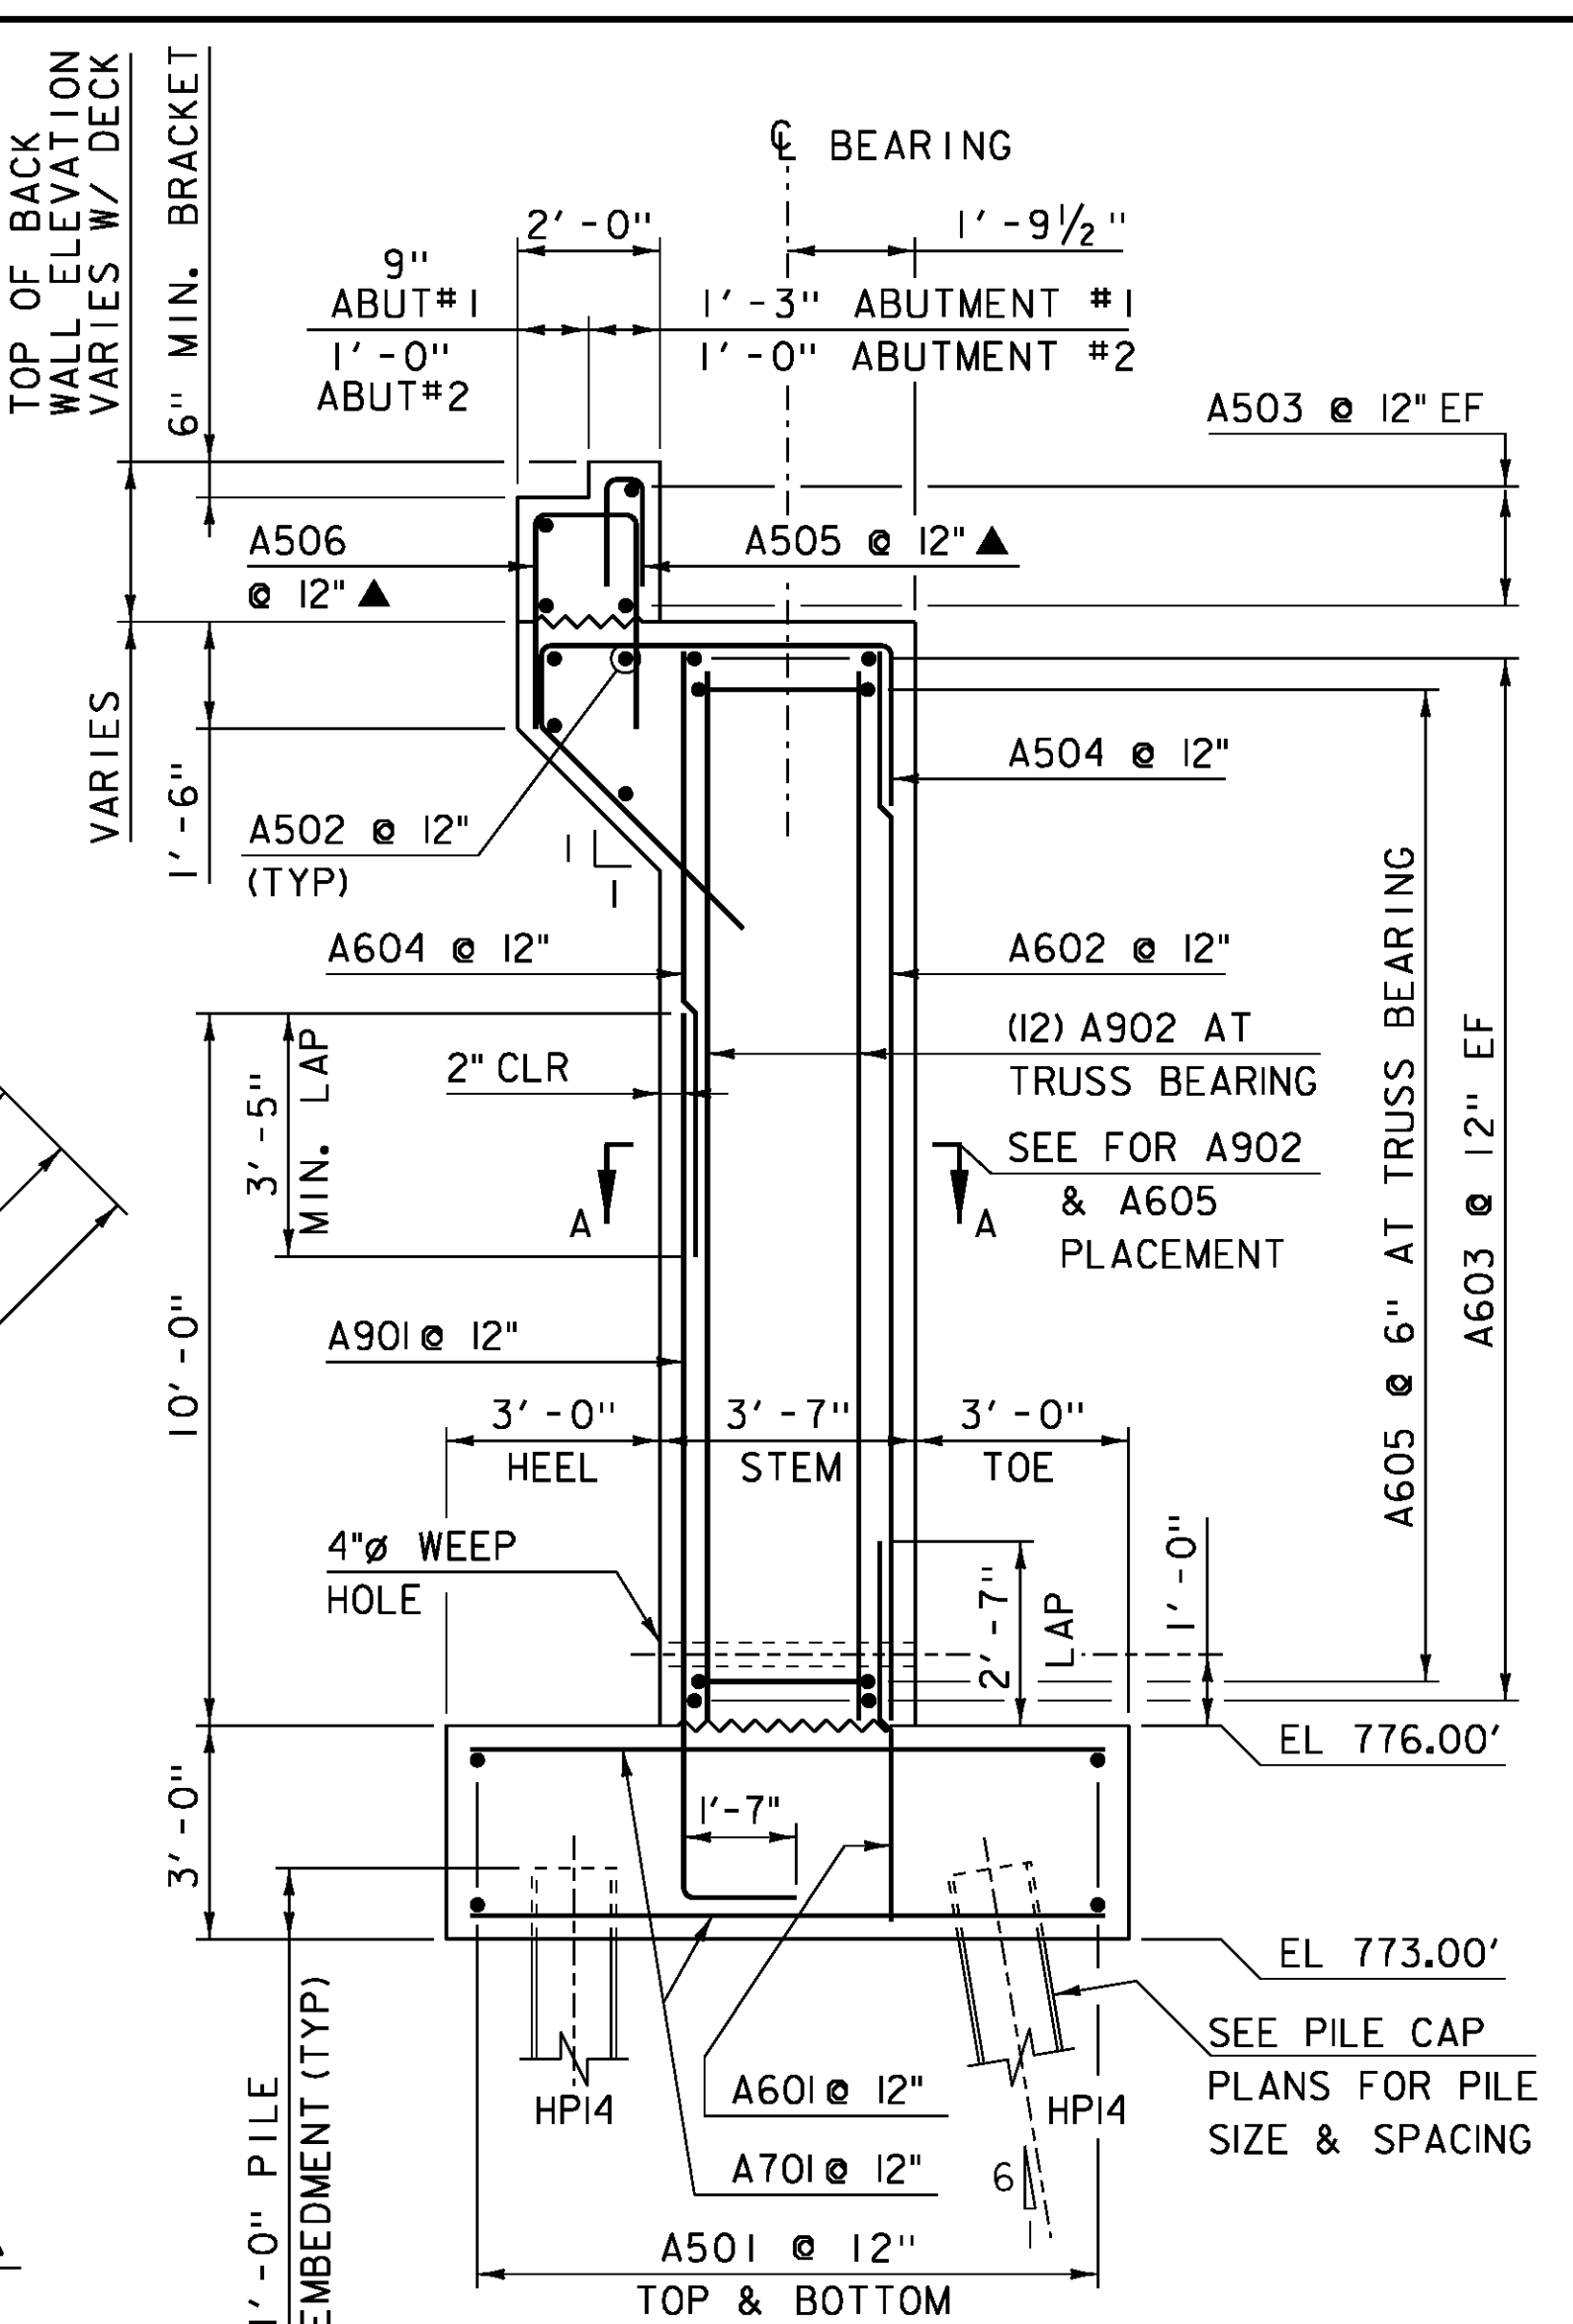

**ABUTMENT #1&2 TYPICAL**  
SCALE 3/8" = 1'-0"

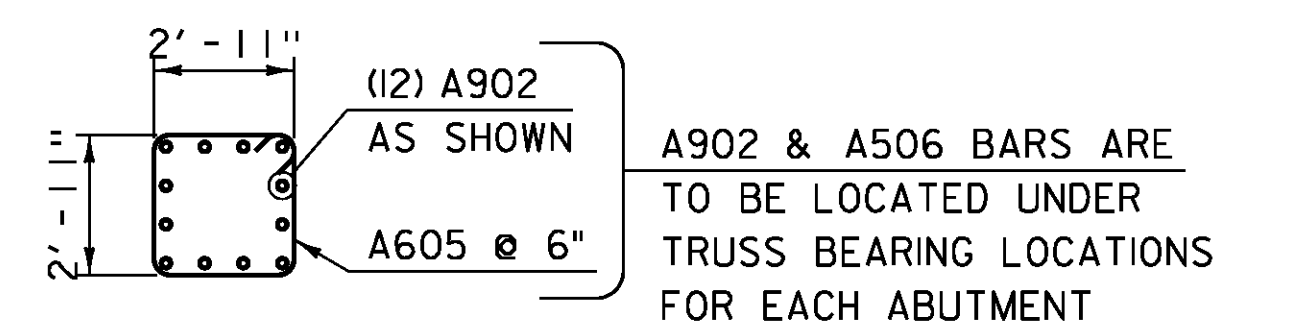

**A-A DETAIL**

**NOTE:**  
NF = NEAR FACE  
FF = FAR FACE  
EF = EACH FACE  
Δ = CUT TO FIT IN FIELD 3" CLEAR, UNLESS OTHERWISE SPECIFIED ON THE PLANS.  
2'-2" BAR LAP UNLESS OTHERWISE SPECIFIED ON THE PLANS.

SEE PILE CAP PLAN FOR PILE CAP REINFORCING AND HPI4 PILE LOCATIONS

PROJECT NAME: WARREN	PLOT DATE: 07-MAR-2013
PROJECT NUMBER: BRF 013-4 (14)	DRAWN BY: M.LONGSTREET
FILE NAME: s78f242sub.dgn	CHECKED BY: U. STANLEY
PROJECT LEADER: J.LACROIX	SHEET 50 OF 83
DESIGNED BY: U.STANLEY	
ABUTMENT #1 PLAN & ELEVATION	