



SEE REVISED PAGE

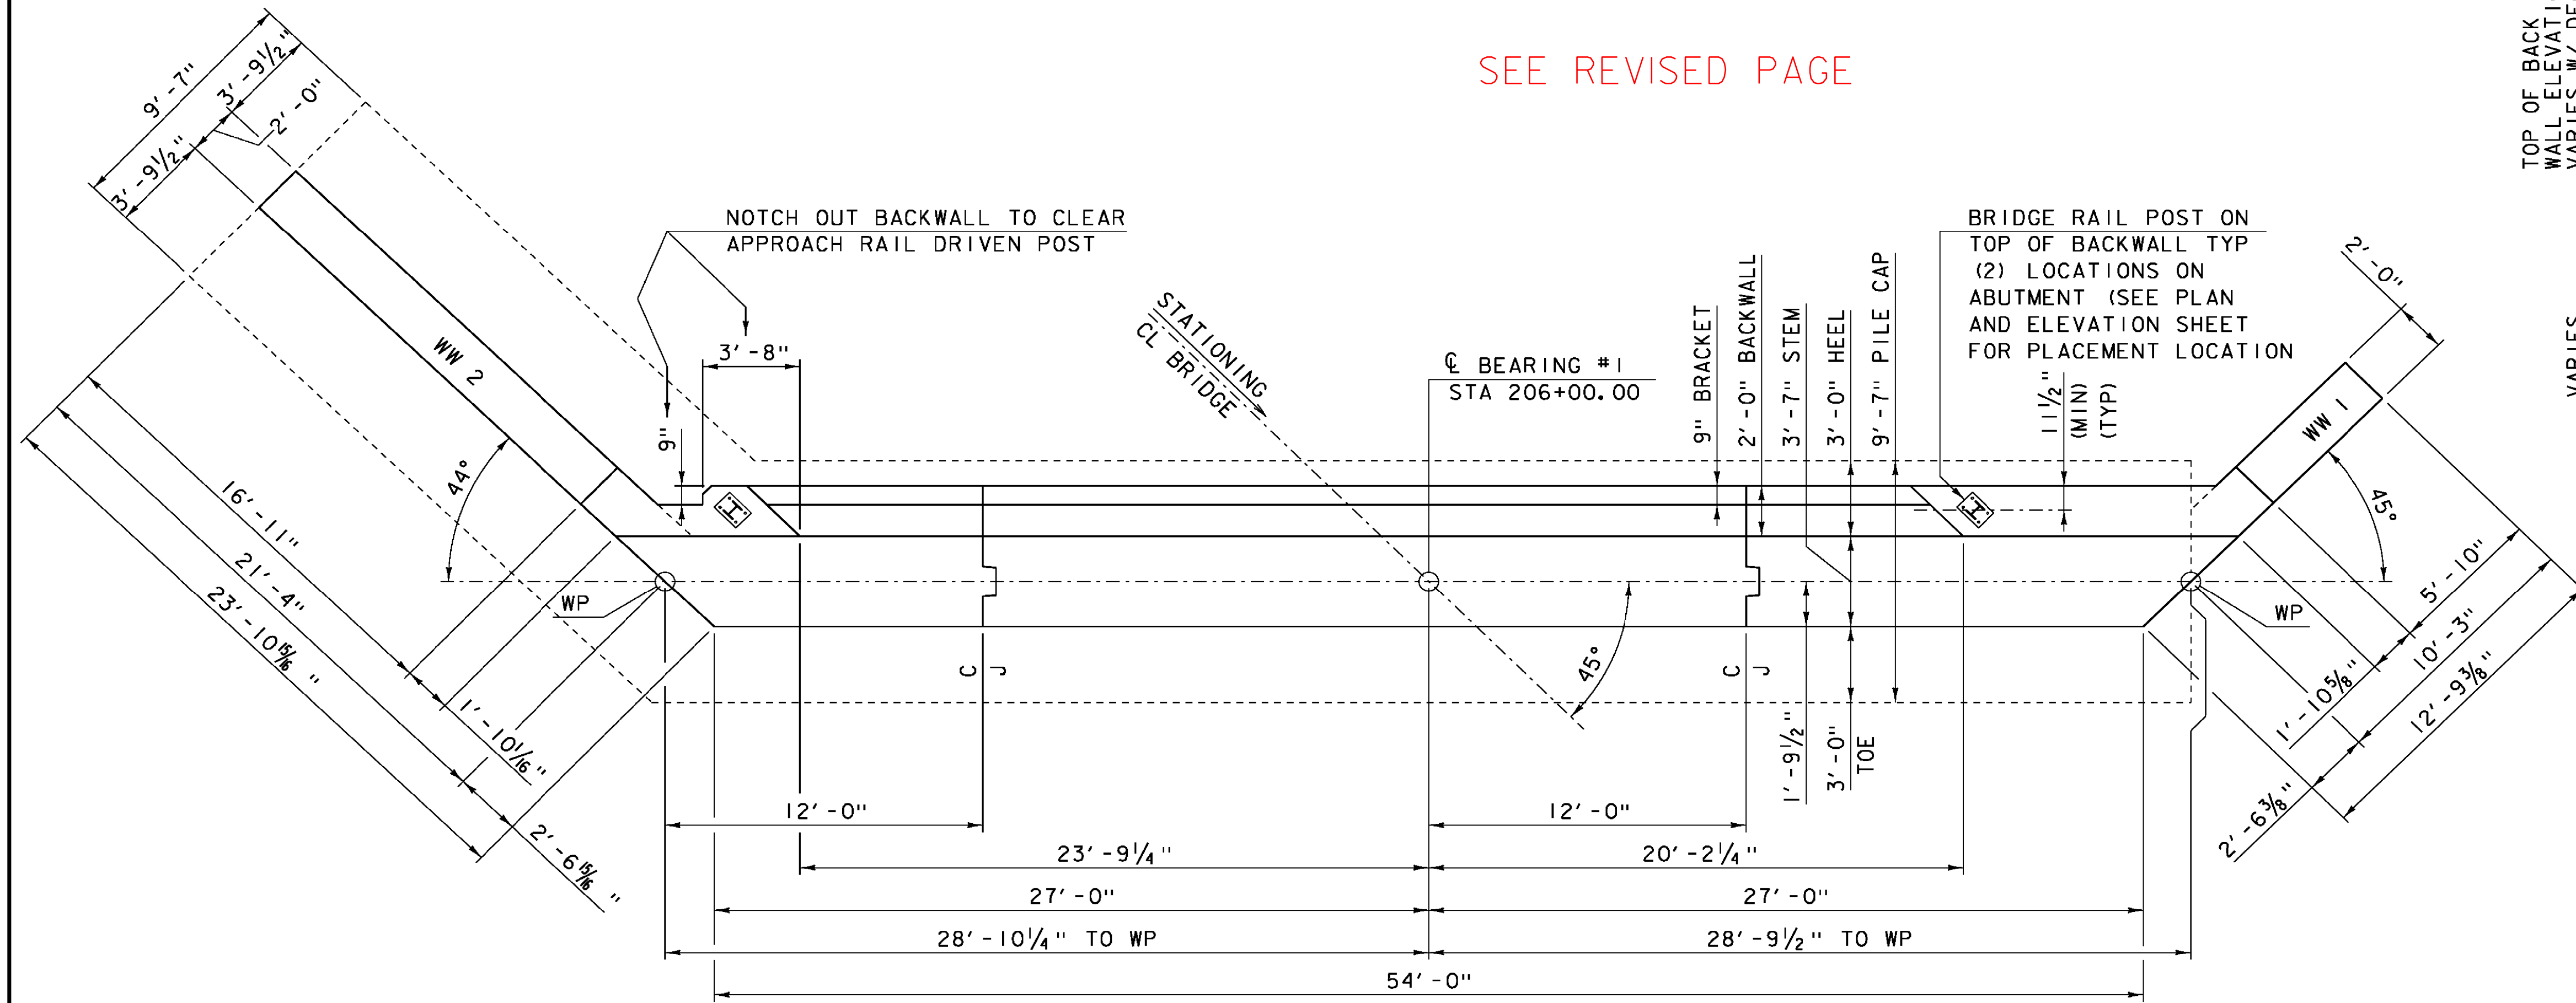


ABUTMENT #1 PLAN VIEW

SCALE 1/4" = 1'-0"

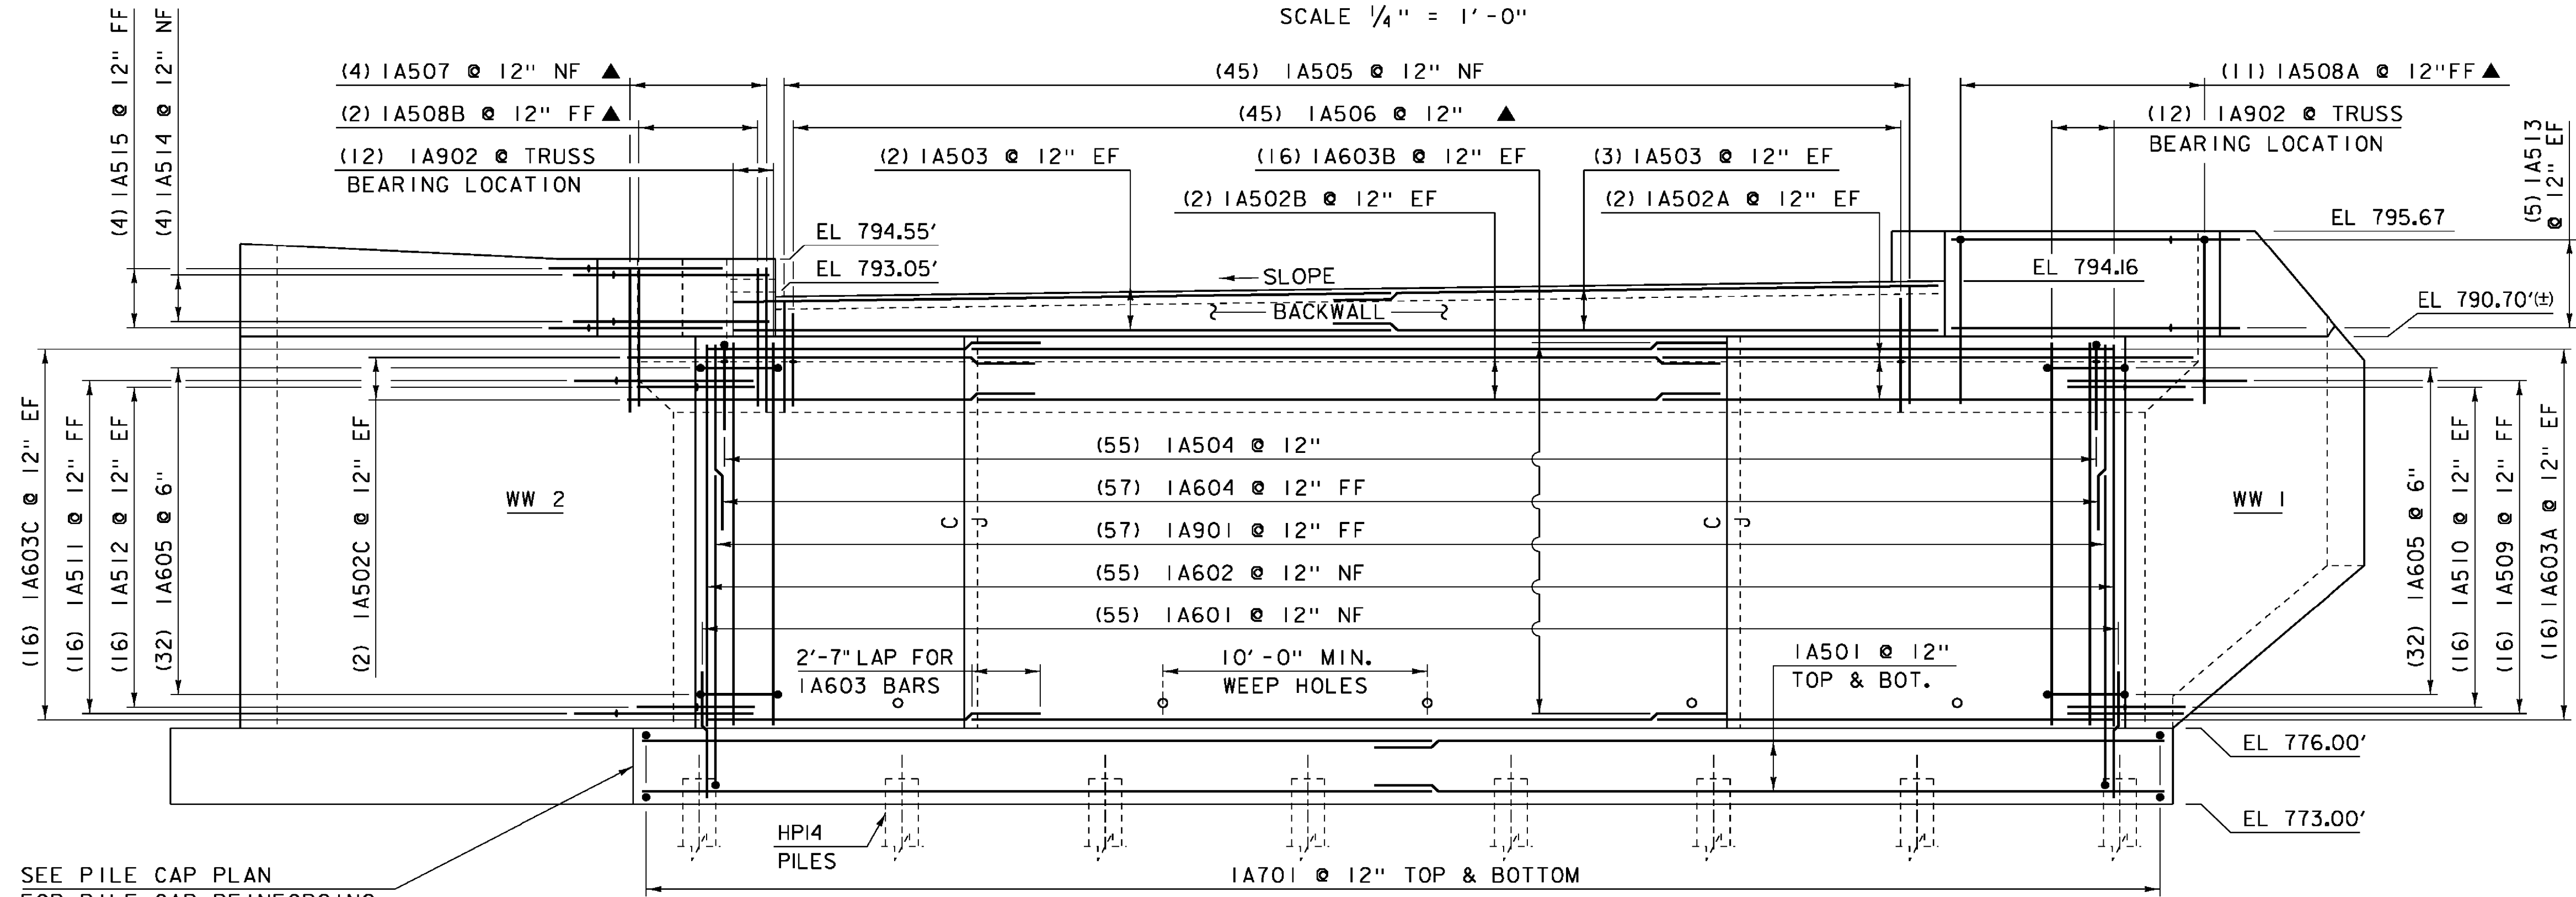


ABUTMENT #1 ELEVATION

SCALE 1/4" = 1'-0"

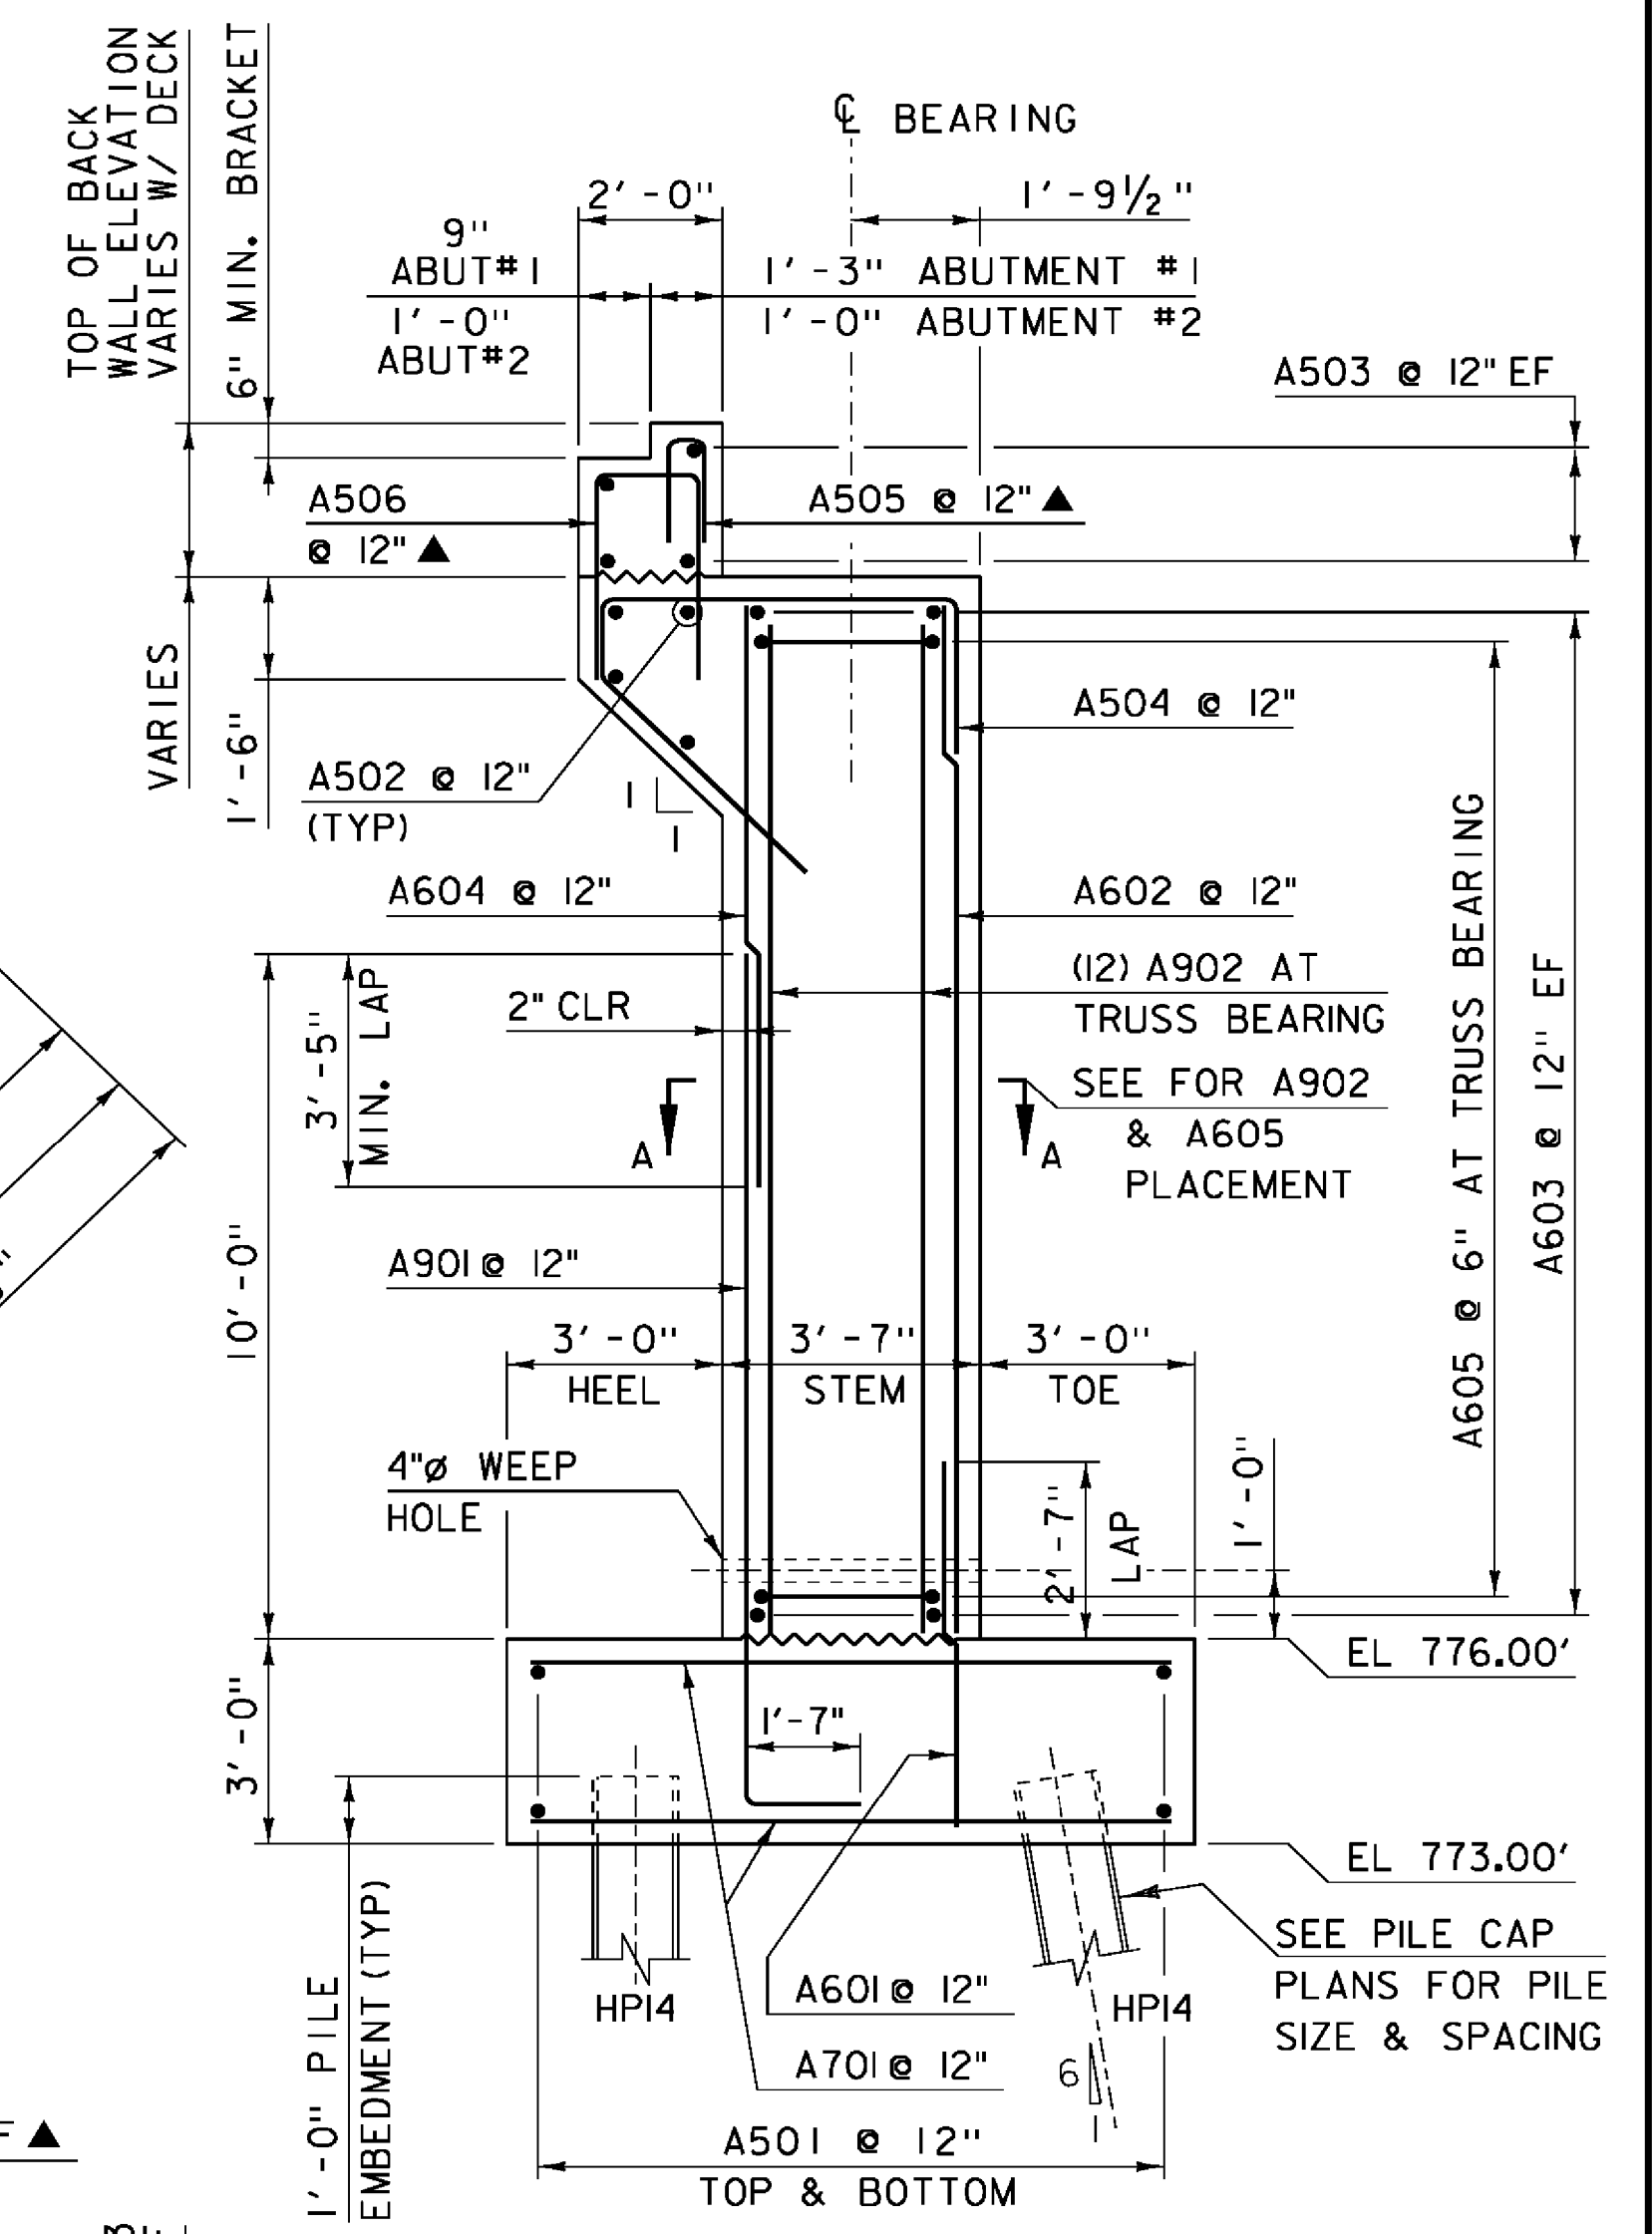

ABUTMENT #1 TYPICAL

SCALE 3/8" = 1'-0"

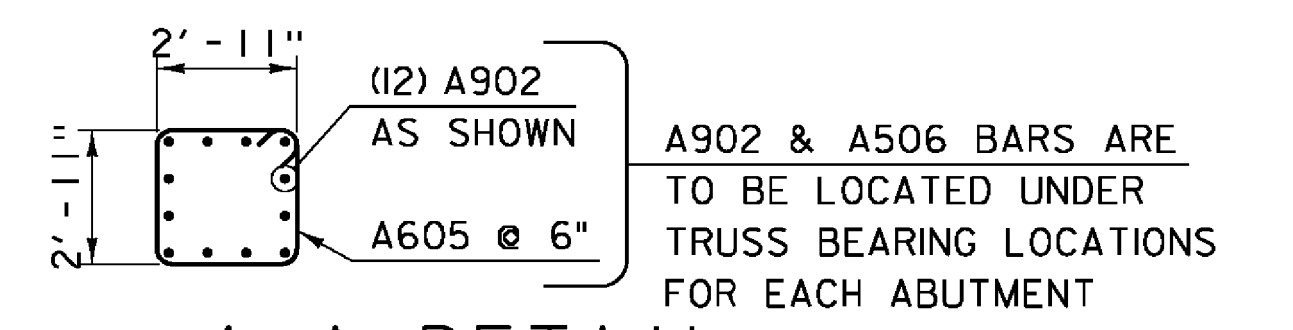

A-A DETAIL

NOTE:

- NF = NEAR FACE
- FF = FAR FACE
- EF = EACH FACE
- ▲ = CUT TO FIT IN FIELD
- 3" CLEAR, UNLESS OTHERWISE SPECIFIED ON THE PLANS.
- 2'-2" BAR LAP UNLESS OTHERWISE SPECIFIED ON THE PLANS.

PROJECT NAME:	WARREN	PLOT DATE:	27-JUL-2012
PROJECT NUMBER:	BRF 013-4 (I4)	DRAWN BY:	M.LONGSTREET
FILE NAME:	s78f242sub.dgn	DESIGNED BY:	U.STANLEY
PROJECT LEADER:	J.LACROIX	CHECKED BY:	U. STANLEY
ABUTMENT #1 PLAN & ELEVATION			SHEET 50 OF 83