



ABUTMENT #2 PLAN VIEW

SCALE 1/4" = 1'-0"

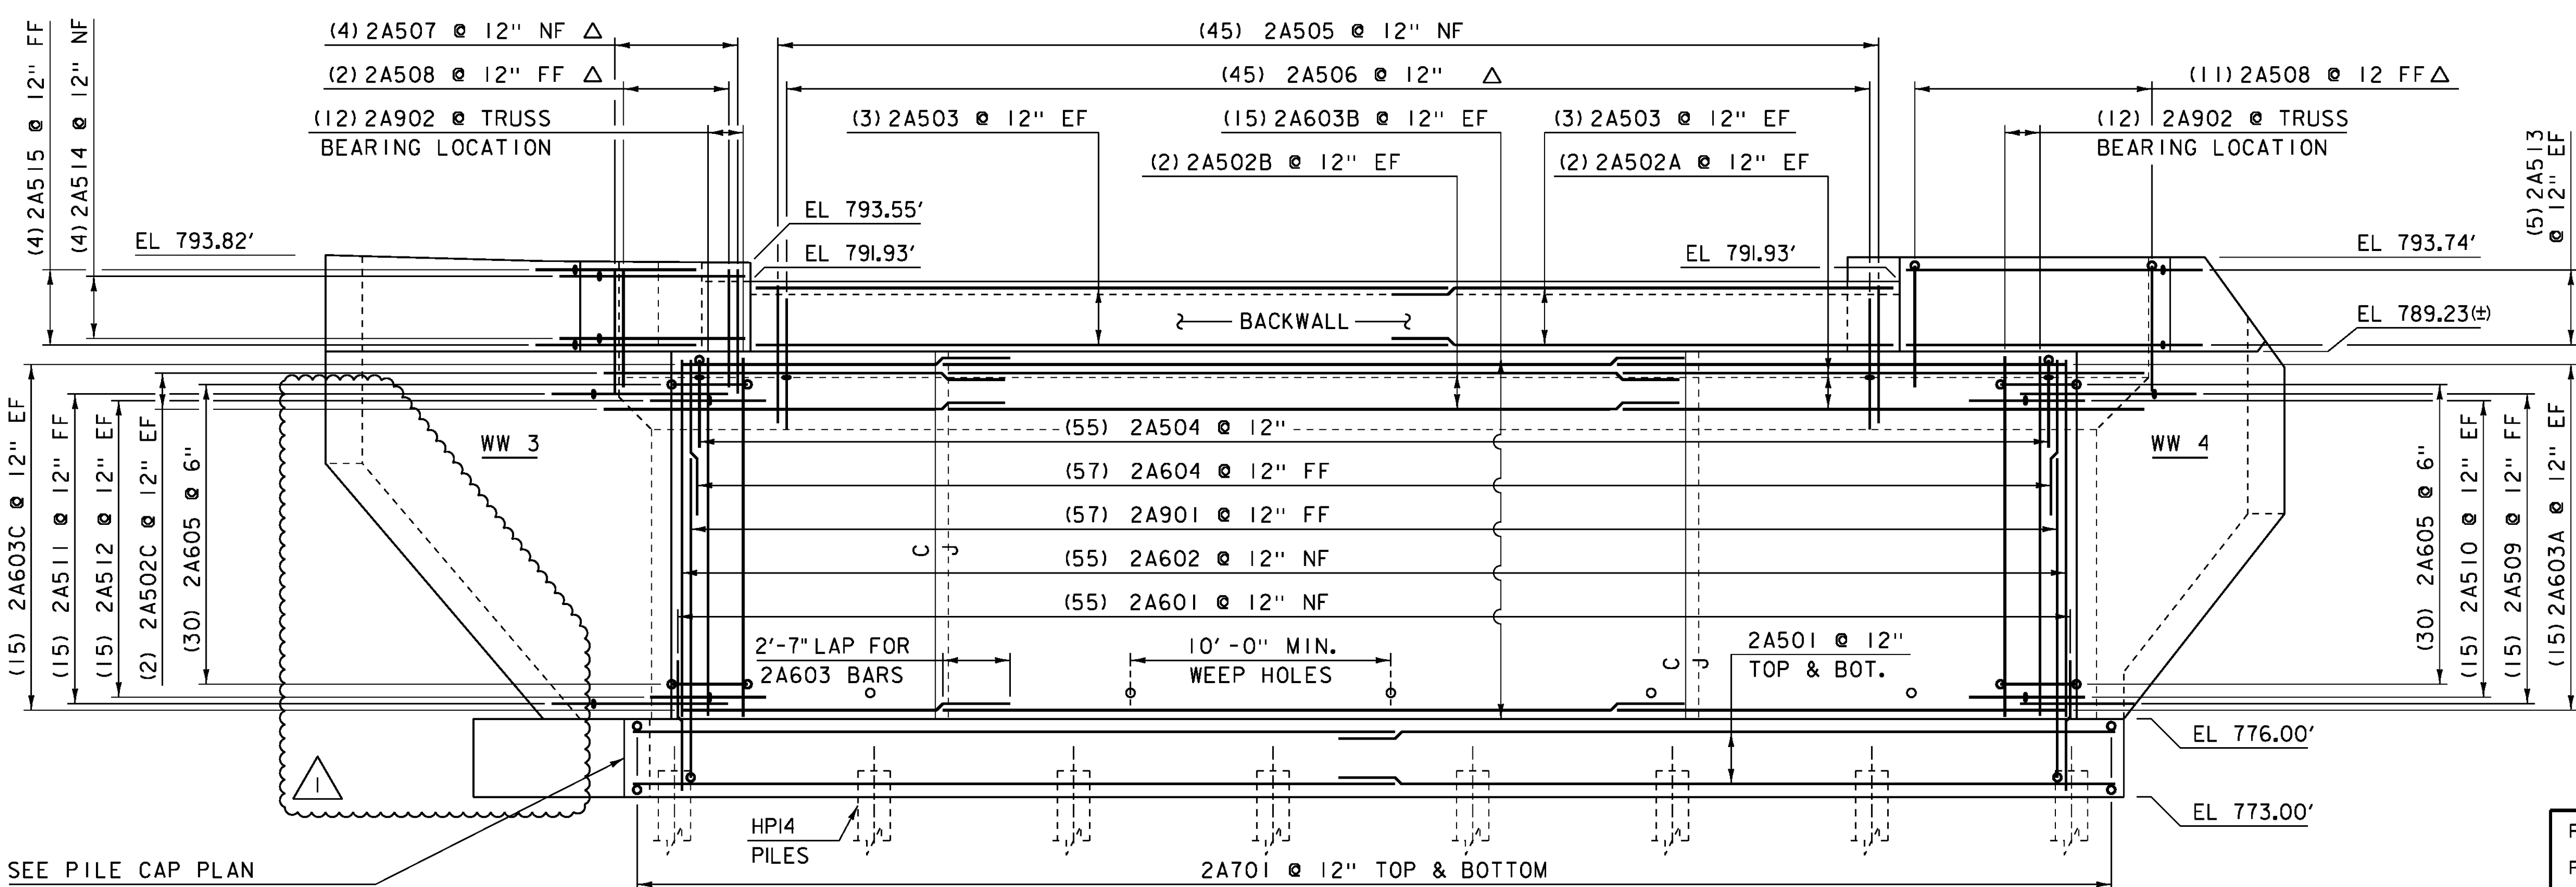

ABUTMENT #2 ELEVATION

SCALE 1/4" = 1'-0"

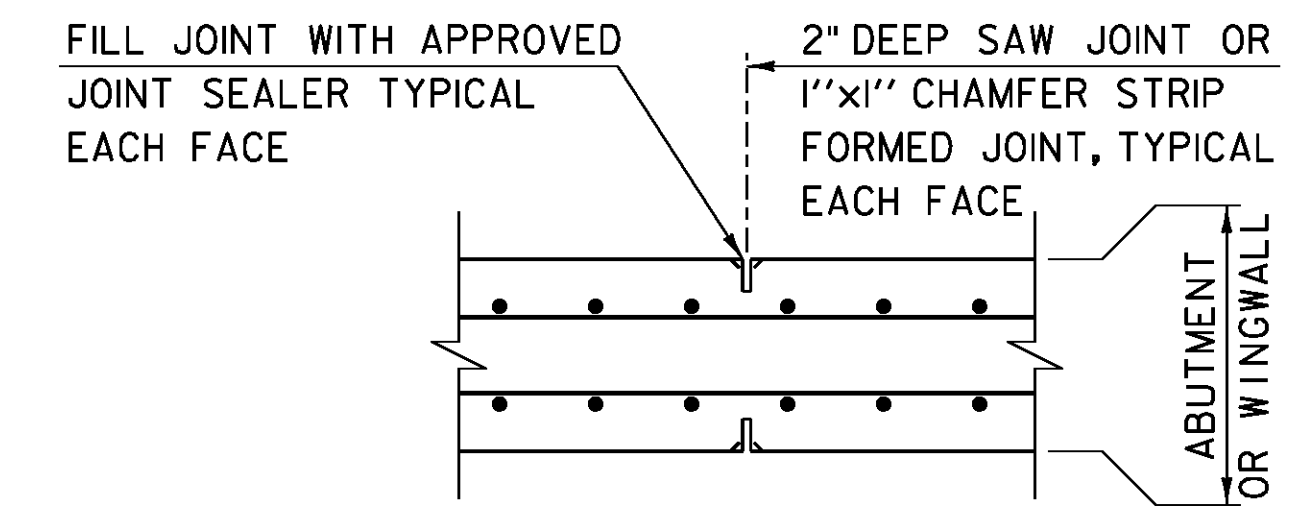

CONTRACTION JOINT

1) CONTRACTION JOINTS SHALL BE PLACED AT NOT MORE THAN 30 FEET APART, MEASURED ALONG THE FACE OF THE ABUTMENT. CONTRACTION JOINTS TO BE USED ON CONTINUOUS POURS OVER 40 FEET IN LENGTH AS MEASURED ALONG THE ABUTMENT FACE.

SEE PILE CAP PLAN FOR PILE CAP REINFORCING AND HPI4 PILE LOCATIONS

| | | | |
|--------------------------------|------------------------|------------------------|----------------|
| PROJECT NAME: WARREN | | PLOT DATE: 07-MAR-2013 | |
| PROJECT NUMBER: BRF 013-4 (14) | | DRAWN BY: M.LONGSTREET | |
| FILE NAME: s78f242sub.dgn | DESIGNED BY: U.STANLEY | CHECKED BY: U.STANLEY | SHEET 51 OF 83 |

| REVISION | DATE | DESCRIPTION | BY |
|----------|------------|--|-----|
| 1 | 01-25-2013 | REMOVE 11' OF FOOTING & (4) PILES & REVISED REBAR FOR WW#3 | MCL |