



SEE REVISED PAGE

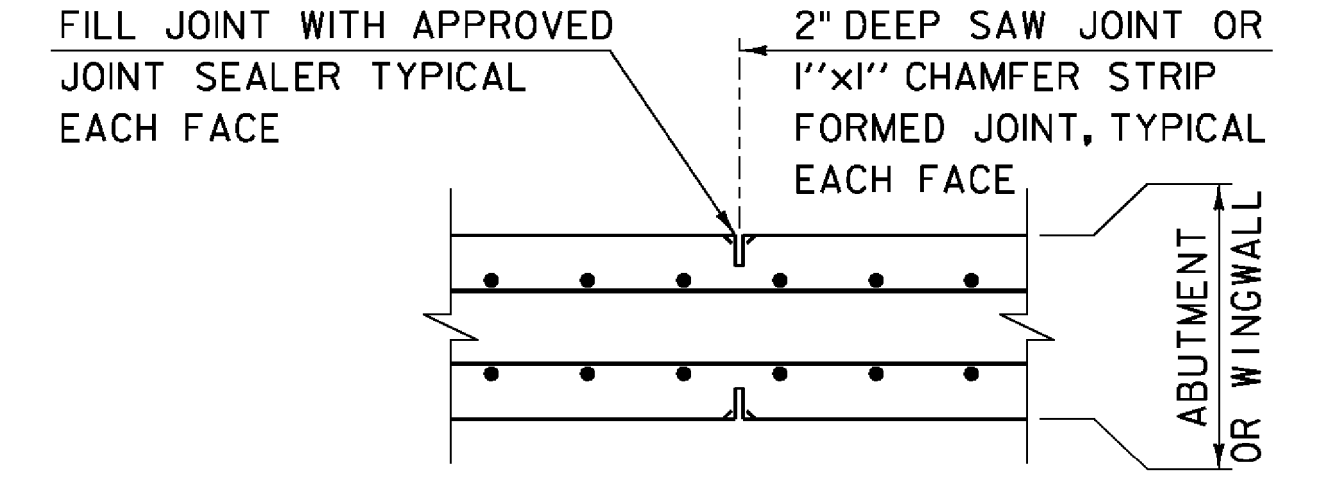


CONTRACTION JOINT

- CONTRACTION JOINTS SHALL BE PLACED AT NOT MORE THAN 30 FEET APART, MEASURED ALONG THE FACE OF THE ABUTMENT. CONTRACTION JOINTS TO BE USED ON CONTINUOUS POURS OVER 40 FEET IN LENGTH AS MEASURED ALONG THE ABUTMENT FACE.

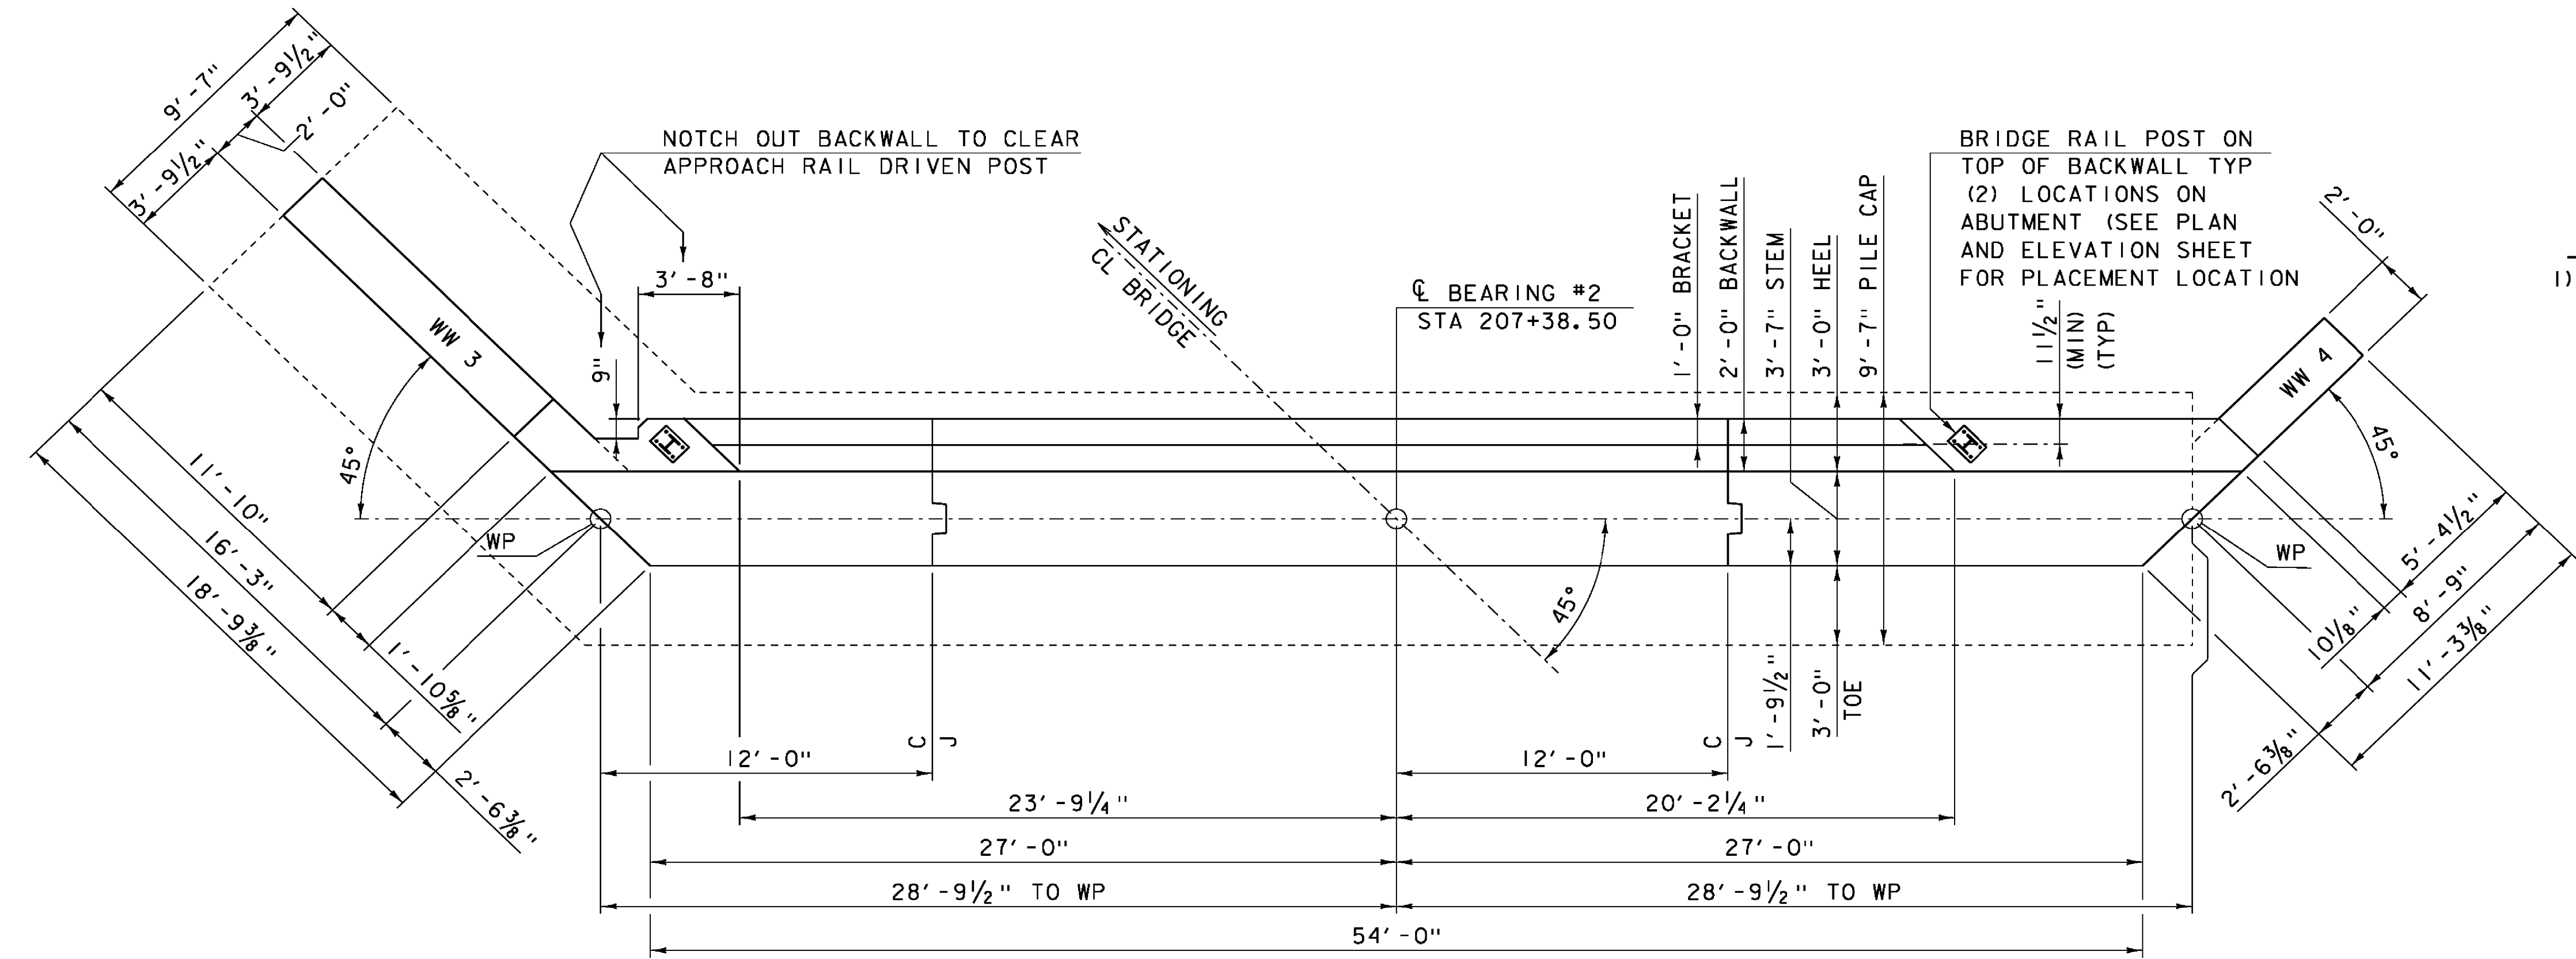

ABUTMENT #2 PLAN VIEW

SCALE 1/4" = 1'-0"

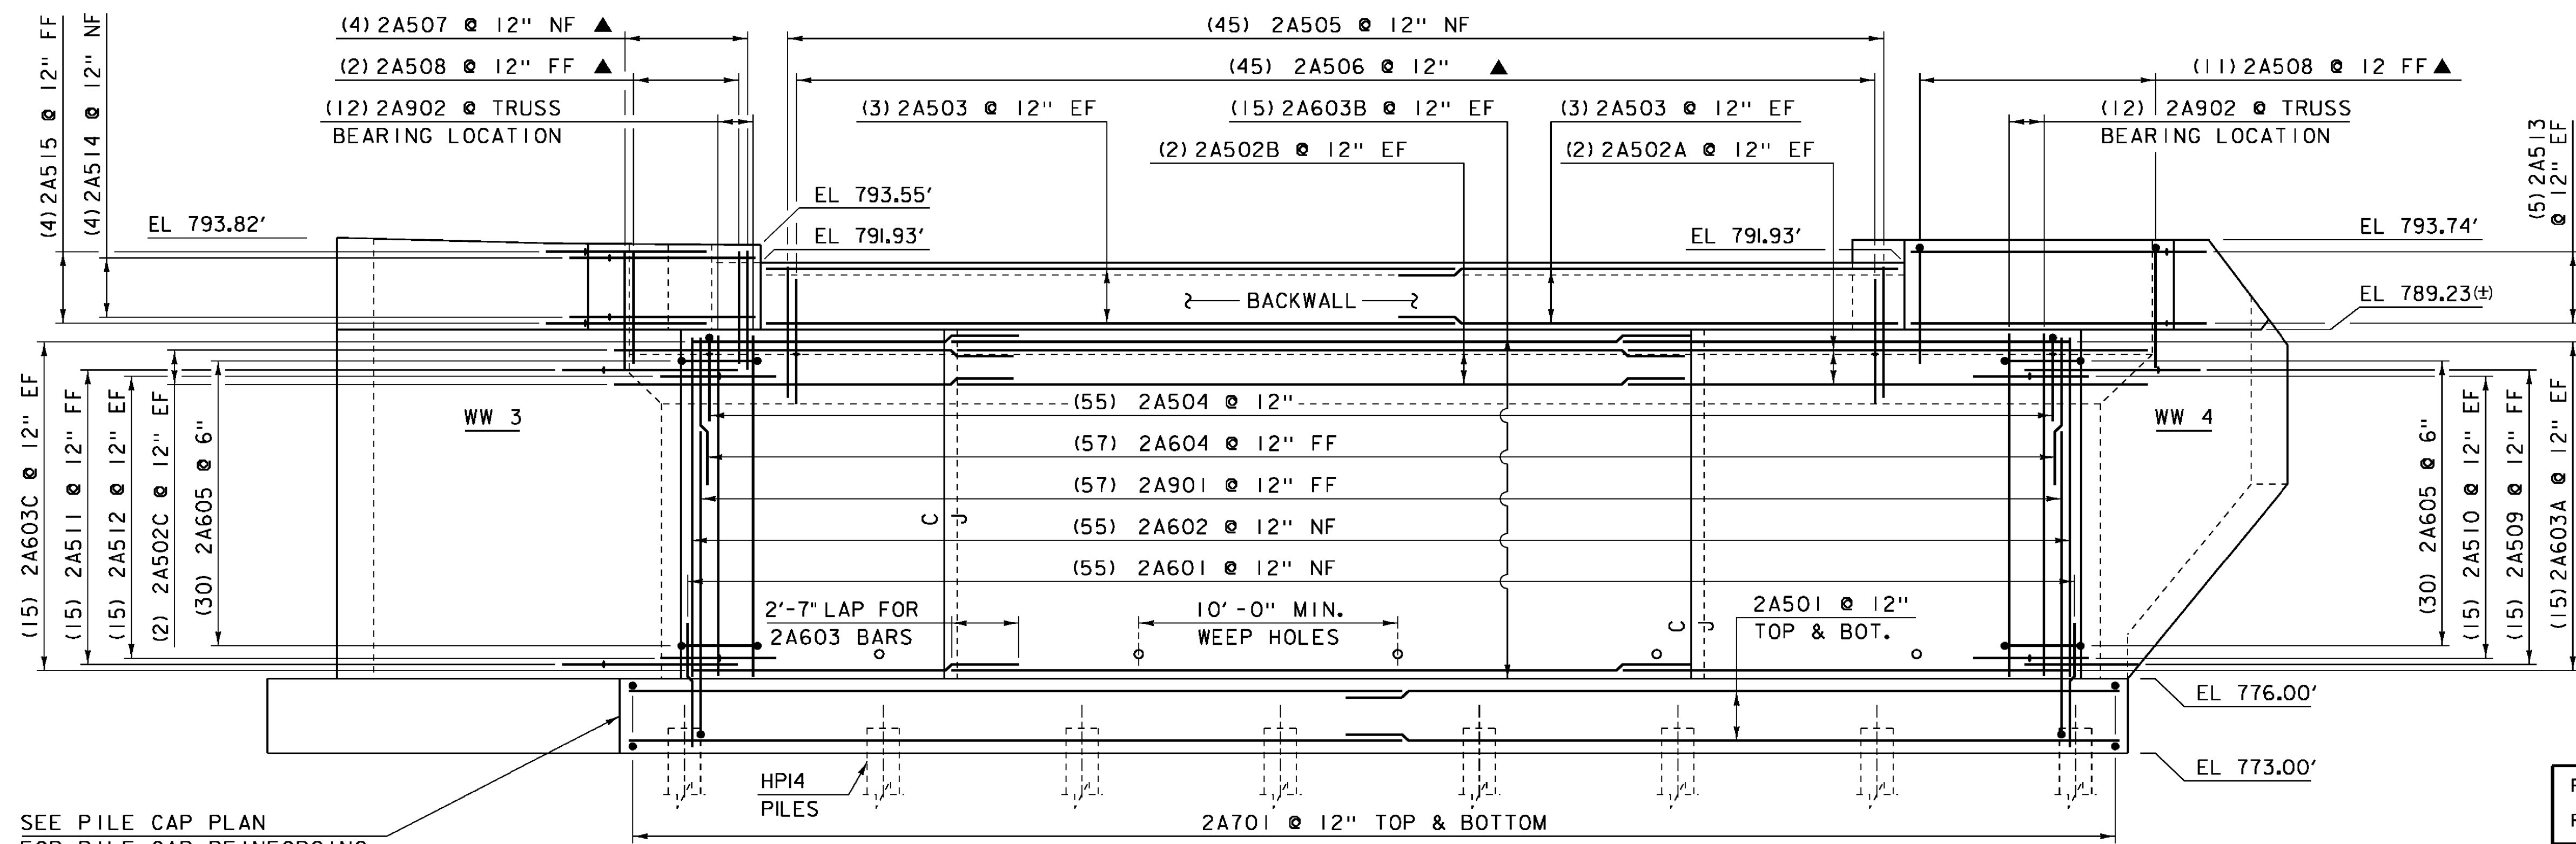

ABUTMENT #2 ELEVATION

SCALE 1/4" = 1'-0"

NOTE:
 NF = NEAR FACE
 FF = FAR FACE
 EF = EACH FACE
 ▲ = CUT TO FIT IN FIELD
 3" CLEAR, UNLESS OTHERWISE SPECIFIED ON THE PLANS.
 2'-2" BAR LAP UNLESS OTHERWISE SPECIFIED ON THE PLANS.

SEE PILE CAP PLAN FOR PILE CAP REINFORCING AND HPI4 PILE LOCATIONS

PROJECT NAME:	WARREN	PLOT DATE:	27-JUL-2012
PROJECT NUMBER:	BRF 013-4 (I4)	DRAWN BY:	M.LONGSTREET
FILE NAME:	s78f242sub.dgn	CHECKED BY:	U. STANLEY
PROJECT LEADER:	J.LACROIX	SHEET	51 OF 83
DESIGNED BY:	U. STANLEY	ABUTMENT #2 PLAN & ELEVATION	