



**WINGWALL #2 ELEVATION**

SCALE 1/4" = 1'-0"

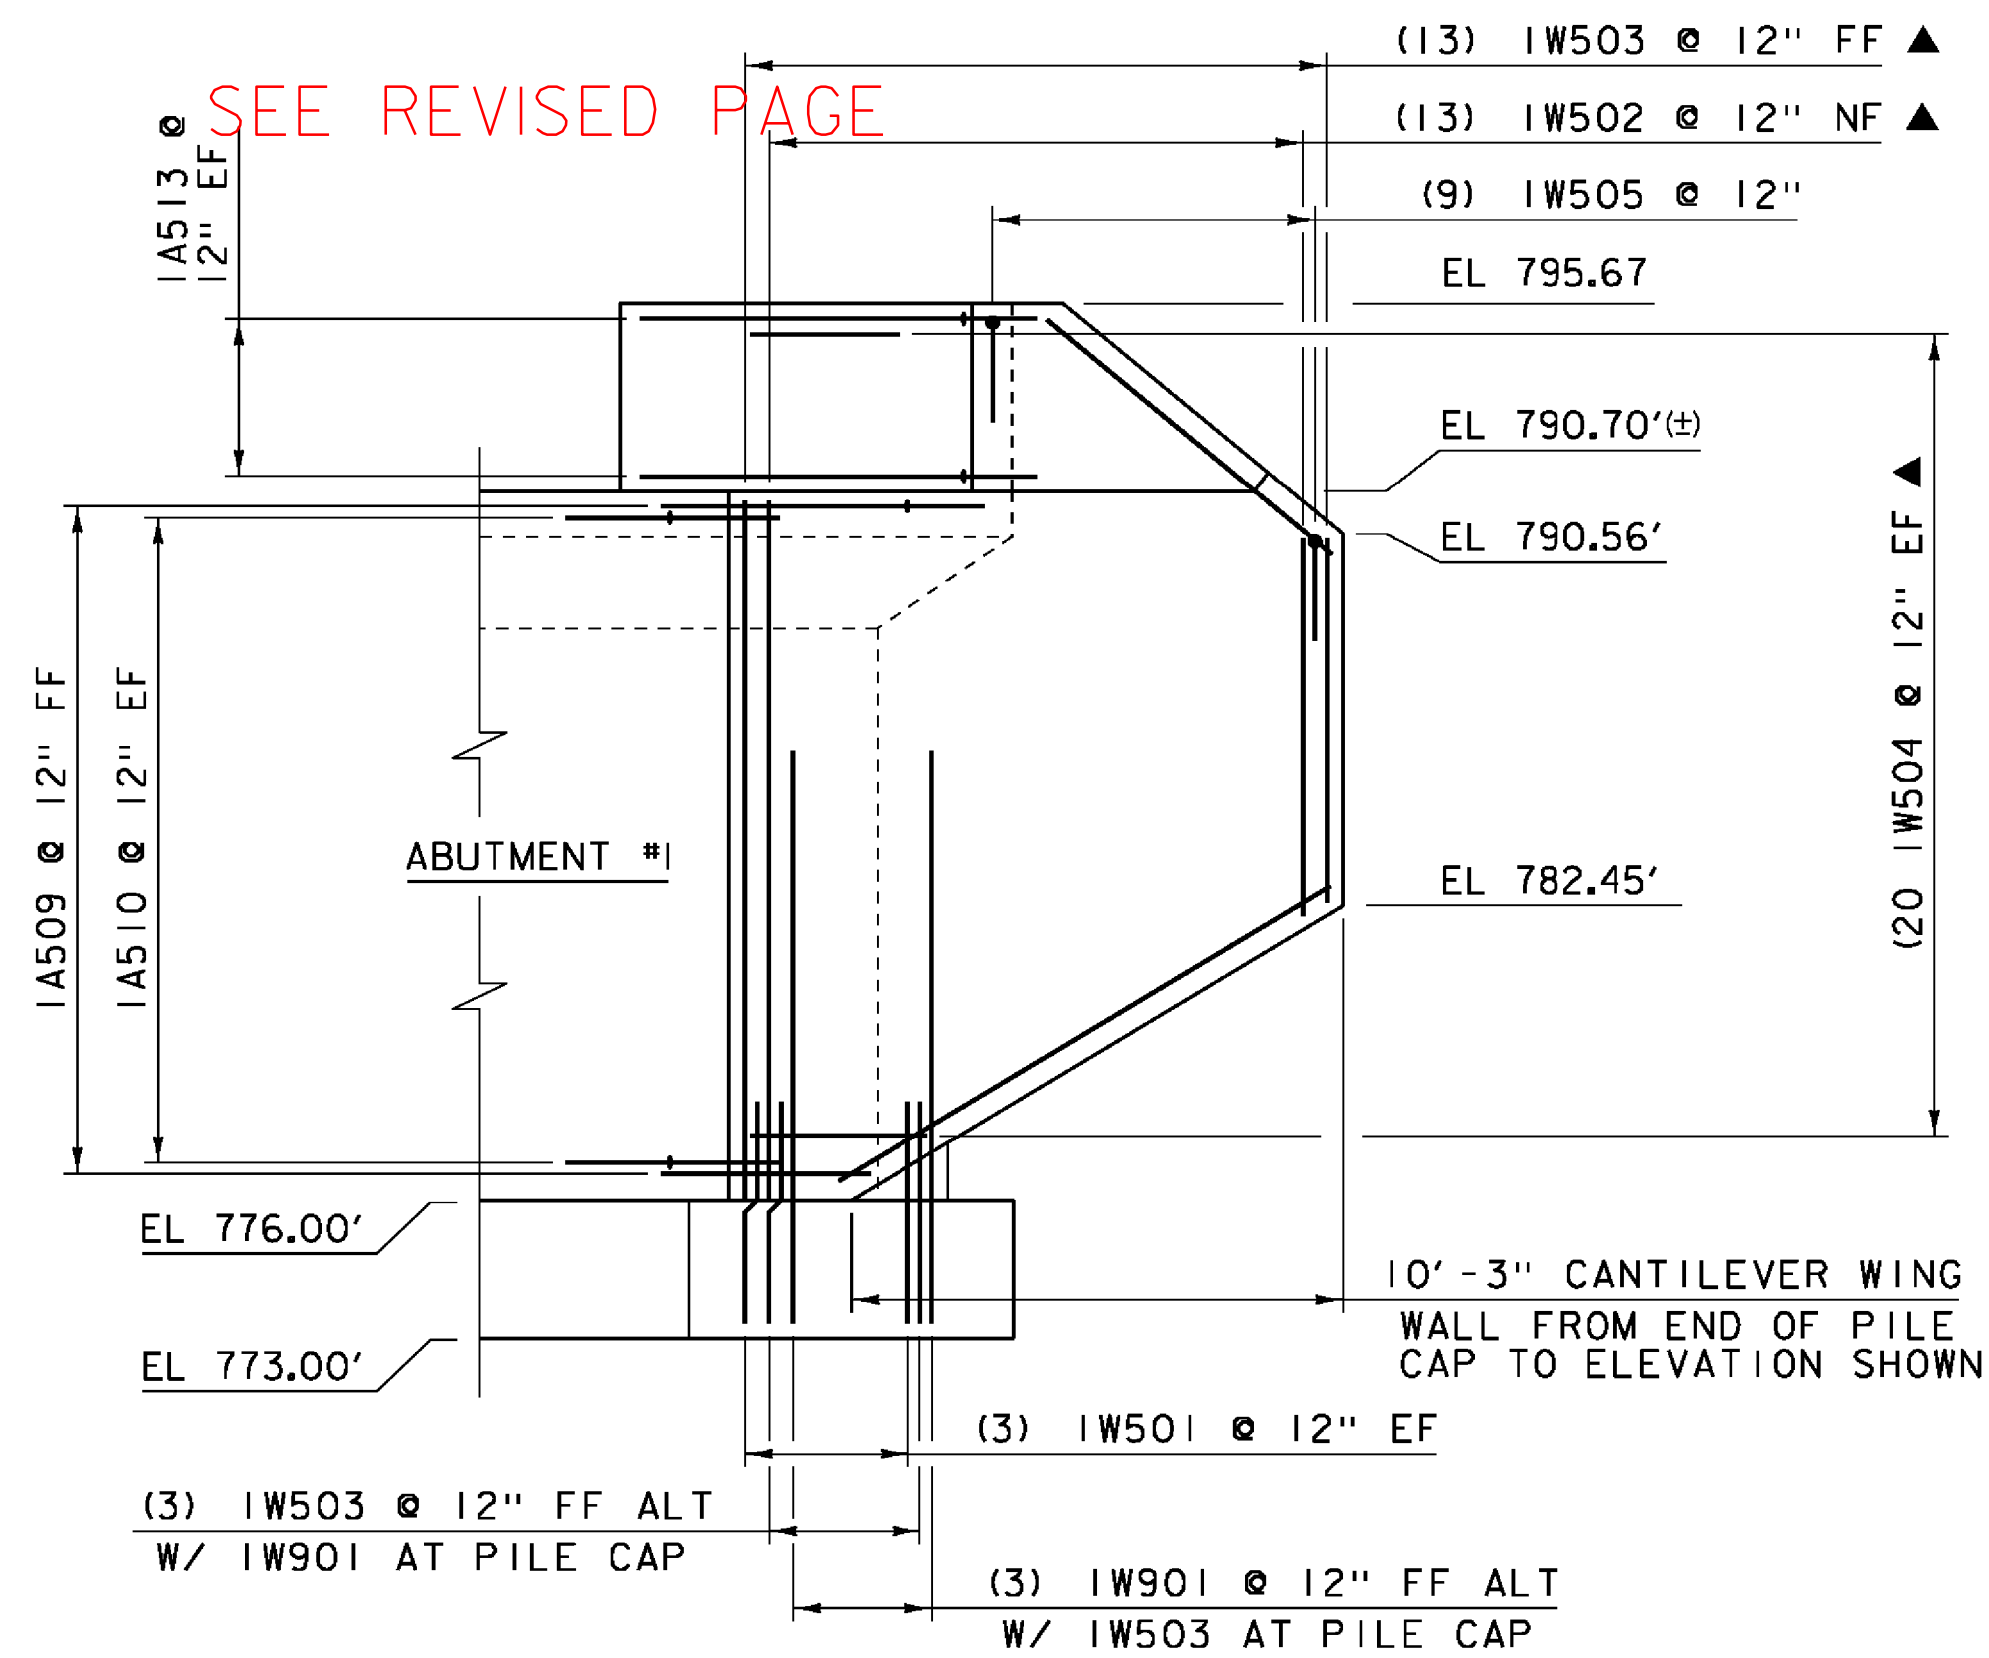


**WINGWALL #1 ELEVATION**

SCALE 1/4" = 1'-0"

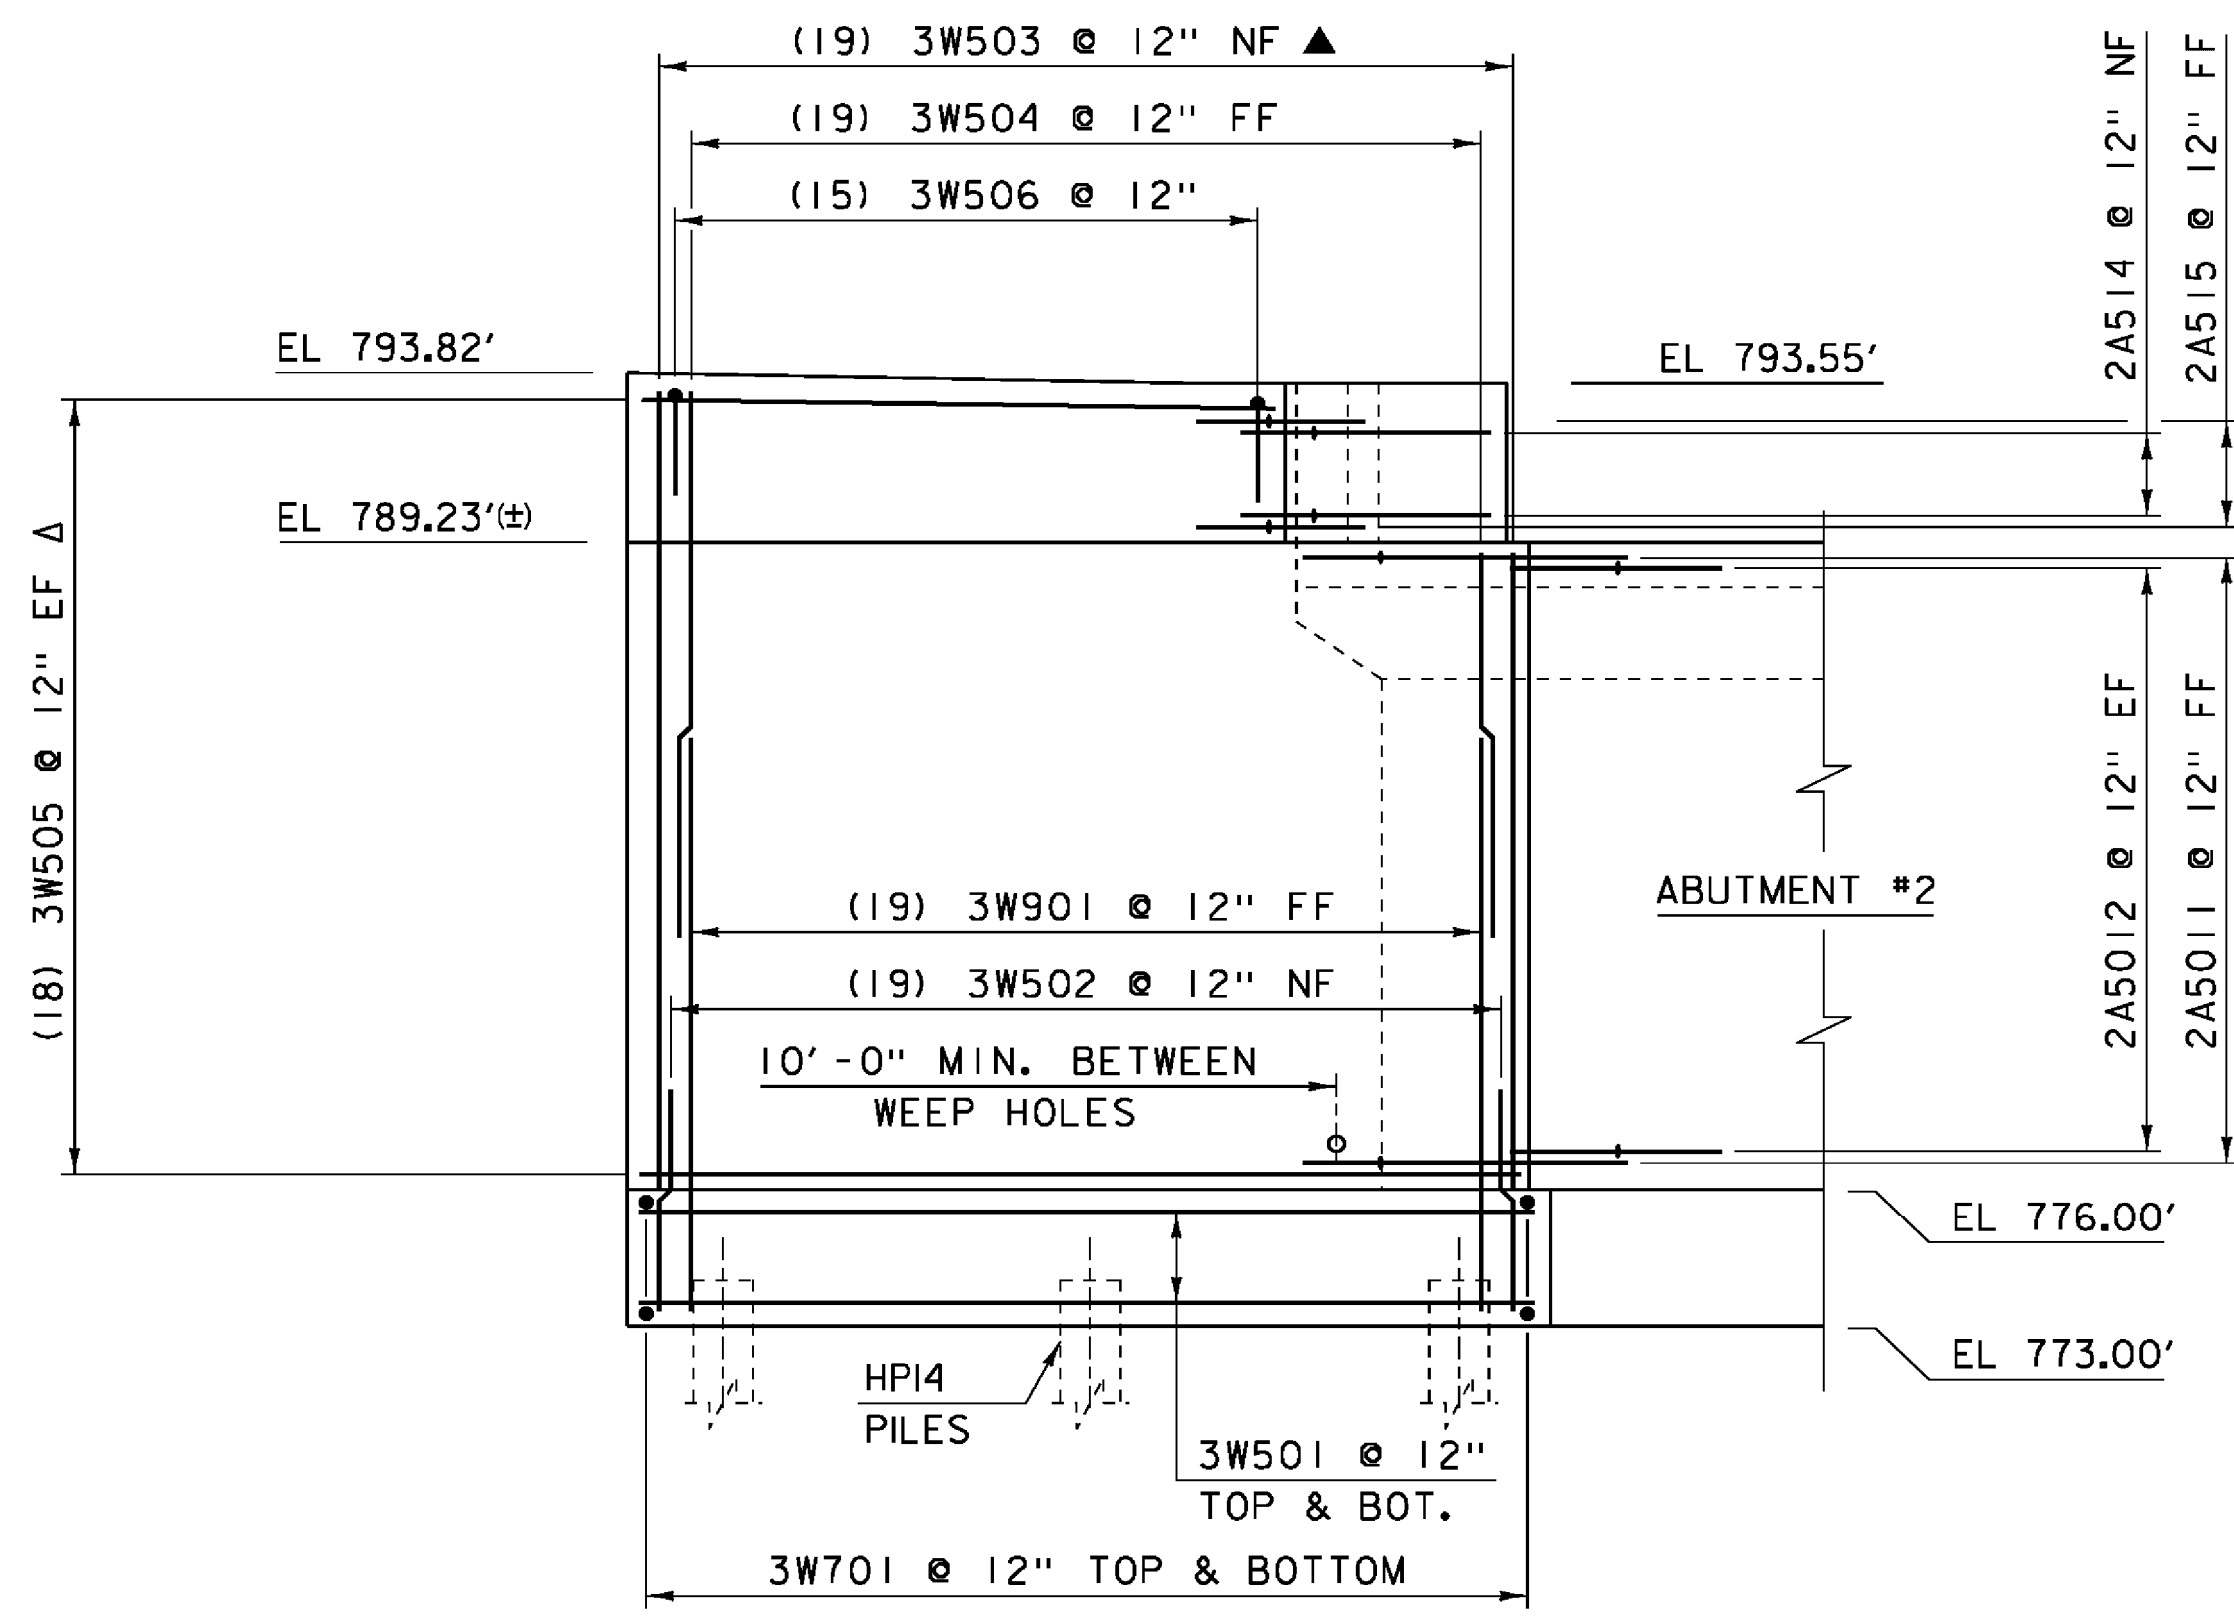

**WINGWALL #3 ELEVATION**

SCALE 1/4" = 1'-0"

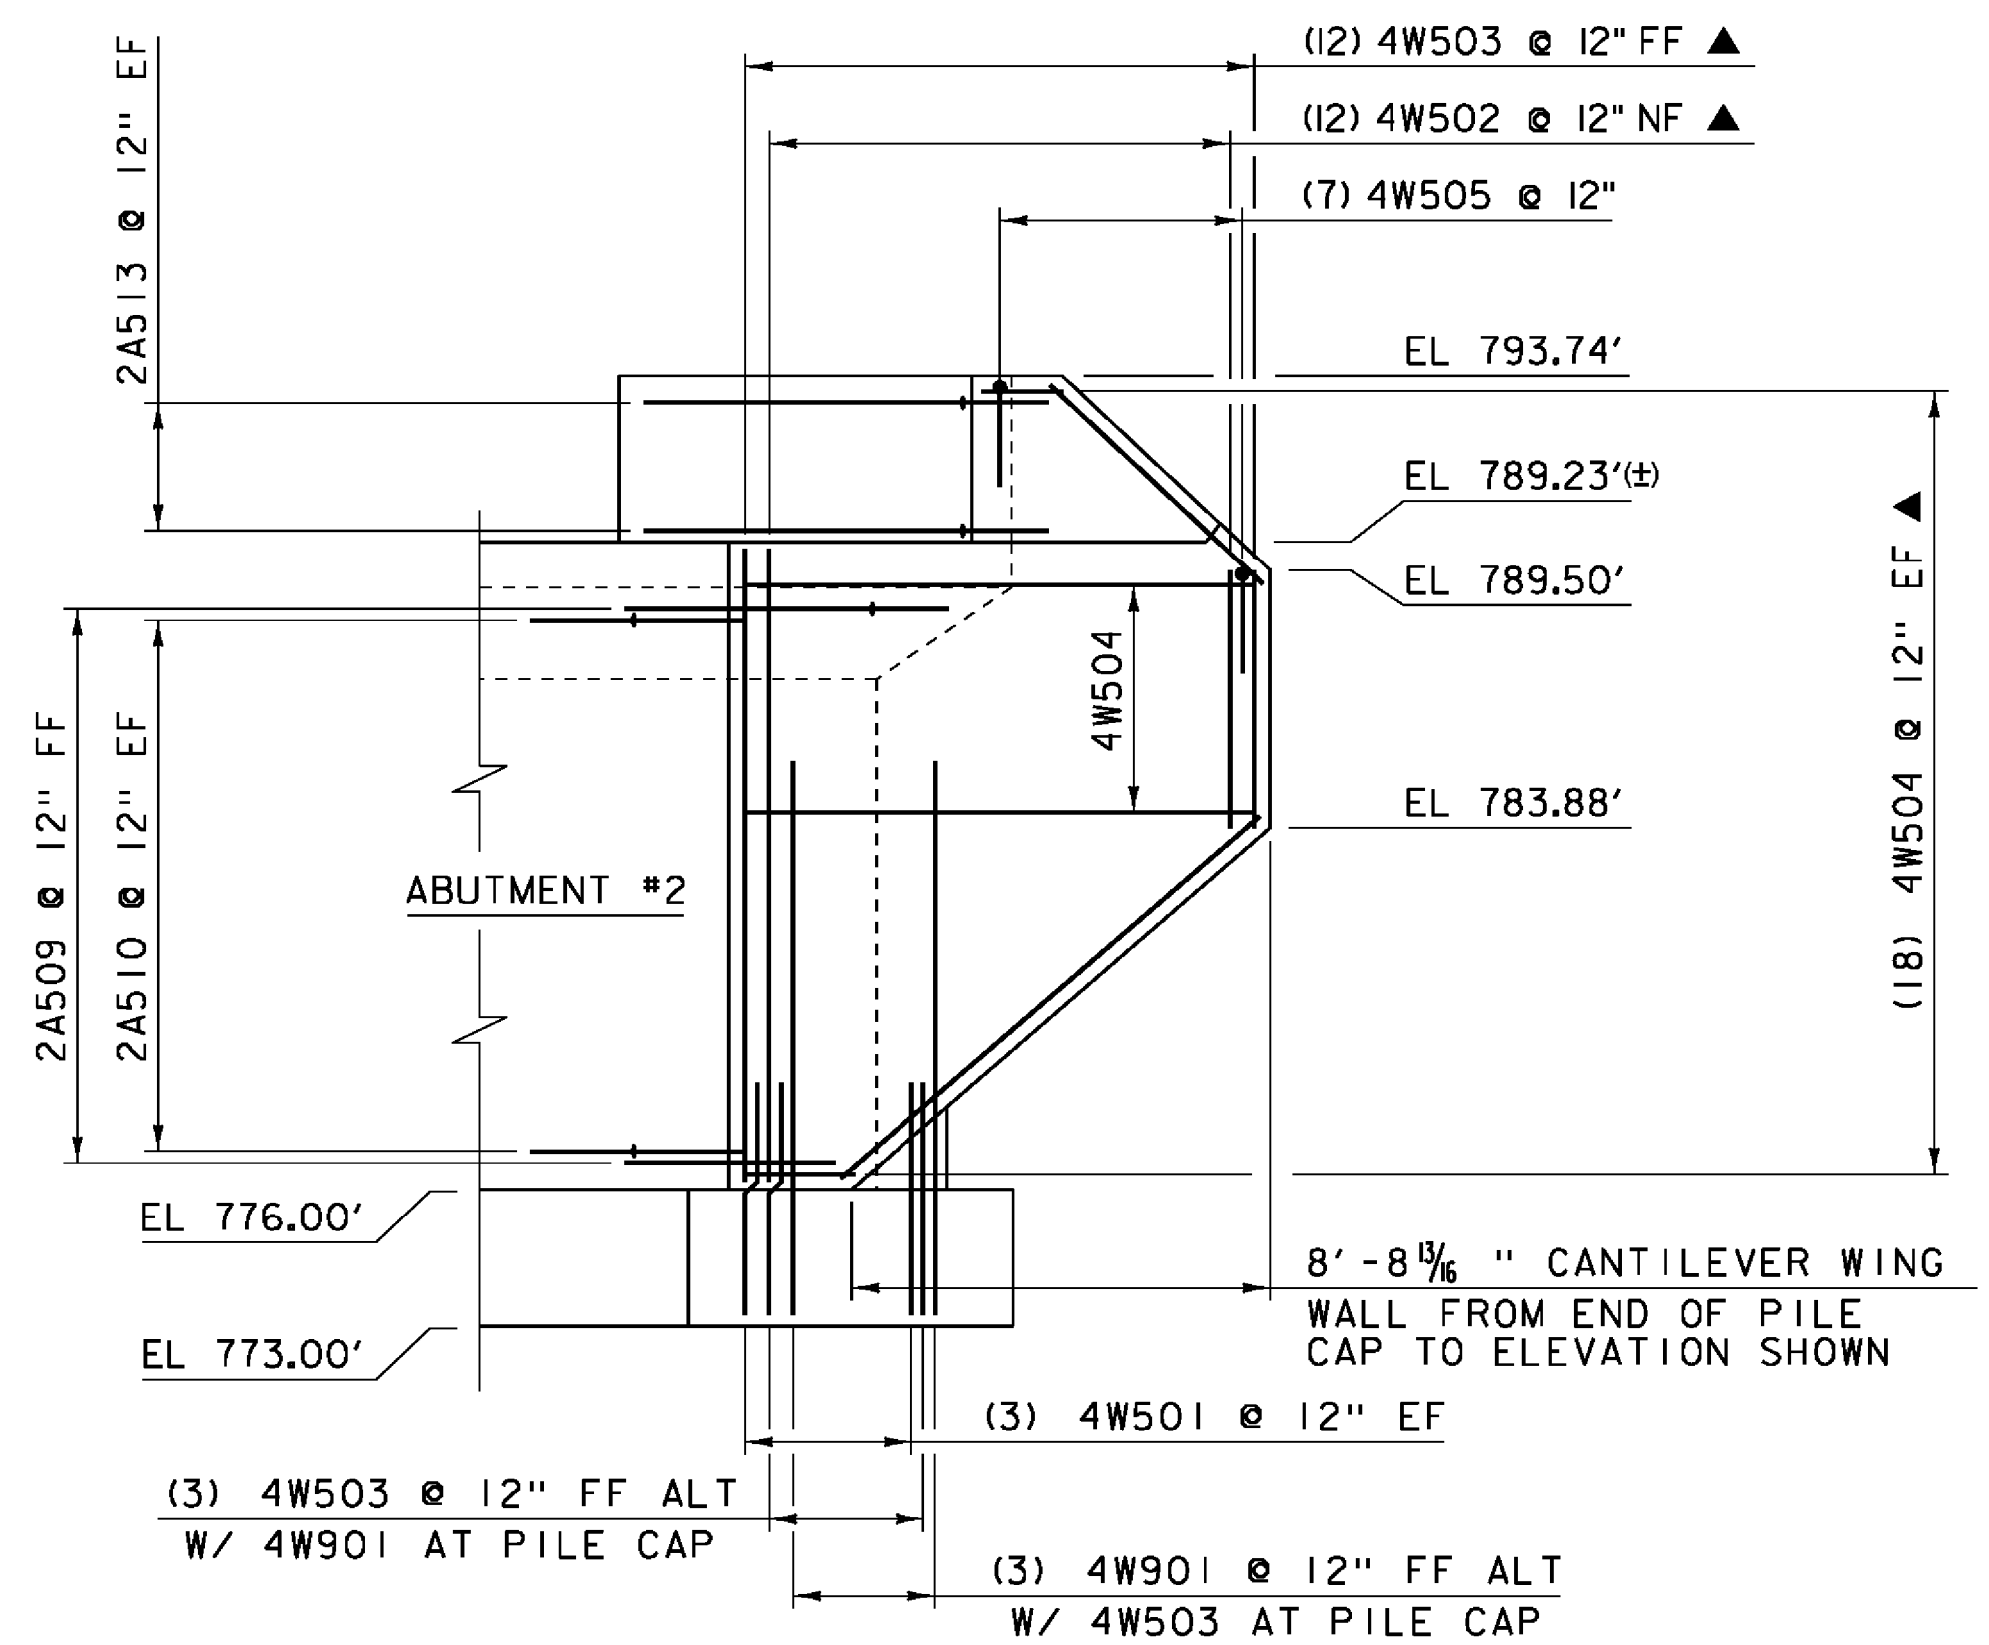

**WINGWALL #4 ELEVATION**

SCALE 1/4" = 1'-0"

**NOTE:**  
 NF = NEAR FACE  
 FF = FAR FACE  
 EF = EACH FACE  
 ▲ = CUT TO FIT IN FIELD  
 3" CLEAR, UNLESS OTHERWISE SPECIFIED ON THE PLANS.  
 2'-2" BAR LAP UNLESS OTHERWISE SPECIFIED ON THE PLANS.

PROJECT NAME:	WARREN	PLOT DATE:	27-JUL-2012
PROJECT NUMBER:	BRF 013-4 (I4)	DRAWN BY:	M.LONGSTREET
FILE NAME:	s78f242sub.dgn	DESIGNED BY:	U.STANLEY
PROJECT LEADER:	J.LACROIX	CHECKED BY:	U. STANLEY
WINGWALL ELEVATIONS		SHEET	53 OF 83