


ABUTMENT #1 PILE CAP PLAN

SCALE 1/4" = 1'-0"

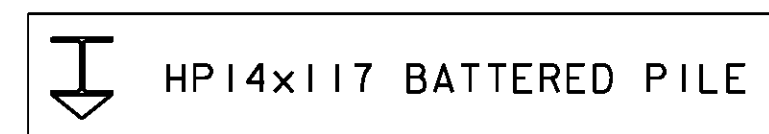

NOTE:  
 NF = NEAR FACE  
 FF = FAR FACE  
 EF = EACH FACE  
 Δ = CUT TO FIT IN FIELD  
 3" CLEAR, UNLESS OTHERWISE SPECIFIED ON THE PLANS.  
 2'-2" BAR LAP UNLESS OTHERWISE SPECIFIED ON THE PLANS.

PROJECT NAME:	WARREN
PROJECT NUMBER:	BRF 013-4 (14)
FILE NAME:	s78f242sub.dgn
PROJECT LEADER:	J.LACROIX
DESIGNED BY:	U.STANLEY
ABUTMENT #1 PILE CAP PLAN	
PLOT DATE:	07-MAR-2013
DRAWN BY:	M.LONGSTREET
CHECKED BY:	U. STANLEY
SHEET	54 OF 83