


ABUTMENT #2 PILE CAP PLAN

SCALE 1/4" = 1'-0"

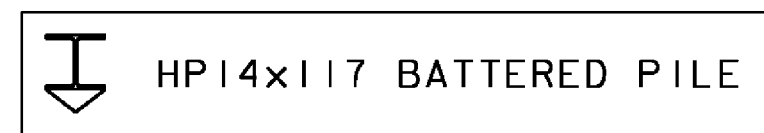

SEE REVISED PAGE

NOTE:
 NF = NEAR FACE
 FF = FAR FACE
 EF = EACH FACE
 ▲ = CUT TO FIT IN FIELD
 3" CLEAR, UNLESS OTHERWISE
 SPECIFIED ON THE PLANS.
 2'-2" BAR LAP UNLESS OTHERWISE
 SPECIFIED ON THE PLANS.

PROJECT NAME:	WARREN	PLOT DATE:	27-JUL-2012
PROJECT NUMBER:	BRF 013-4 (14)	DRAWN BY:	M.LONGSTREET
FILE NAME:	s78f242sub.dgn	CHECKED BY:	U. STANLEY
PROJECT LEADER:	J.LACROIX	SHEET	55 OF 83
DESIGNED BY:	U. STANLEY		
ABUTMENT #2 PILE CAP PLAN			