


202+50

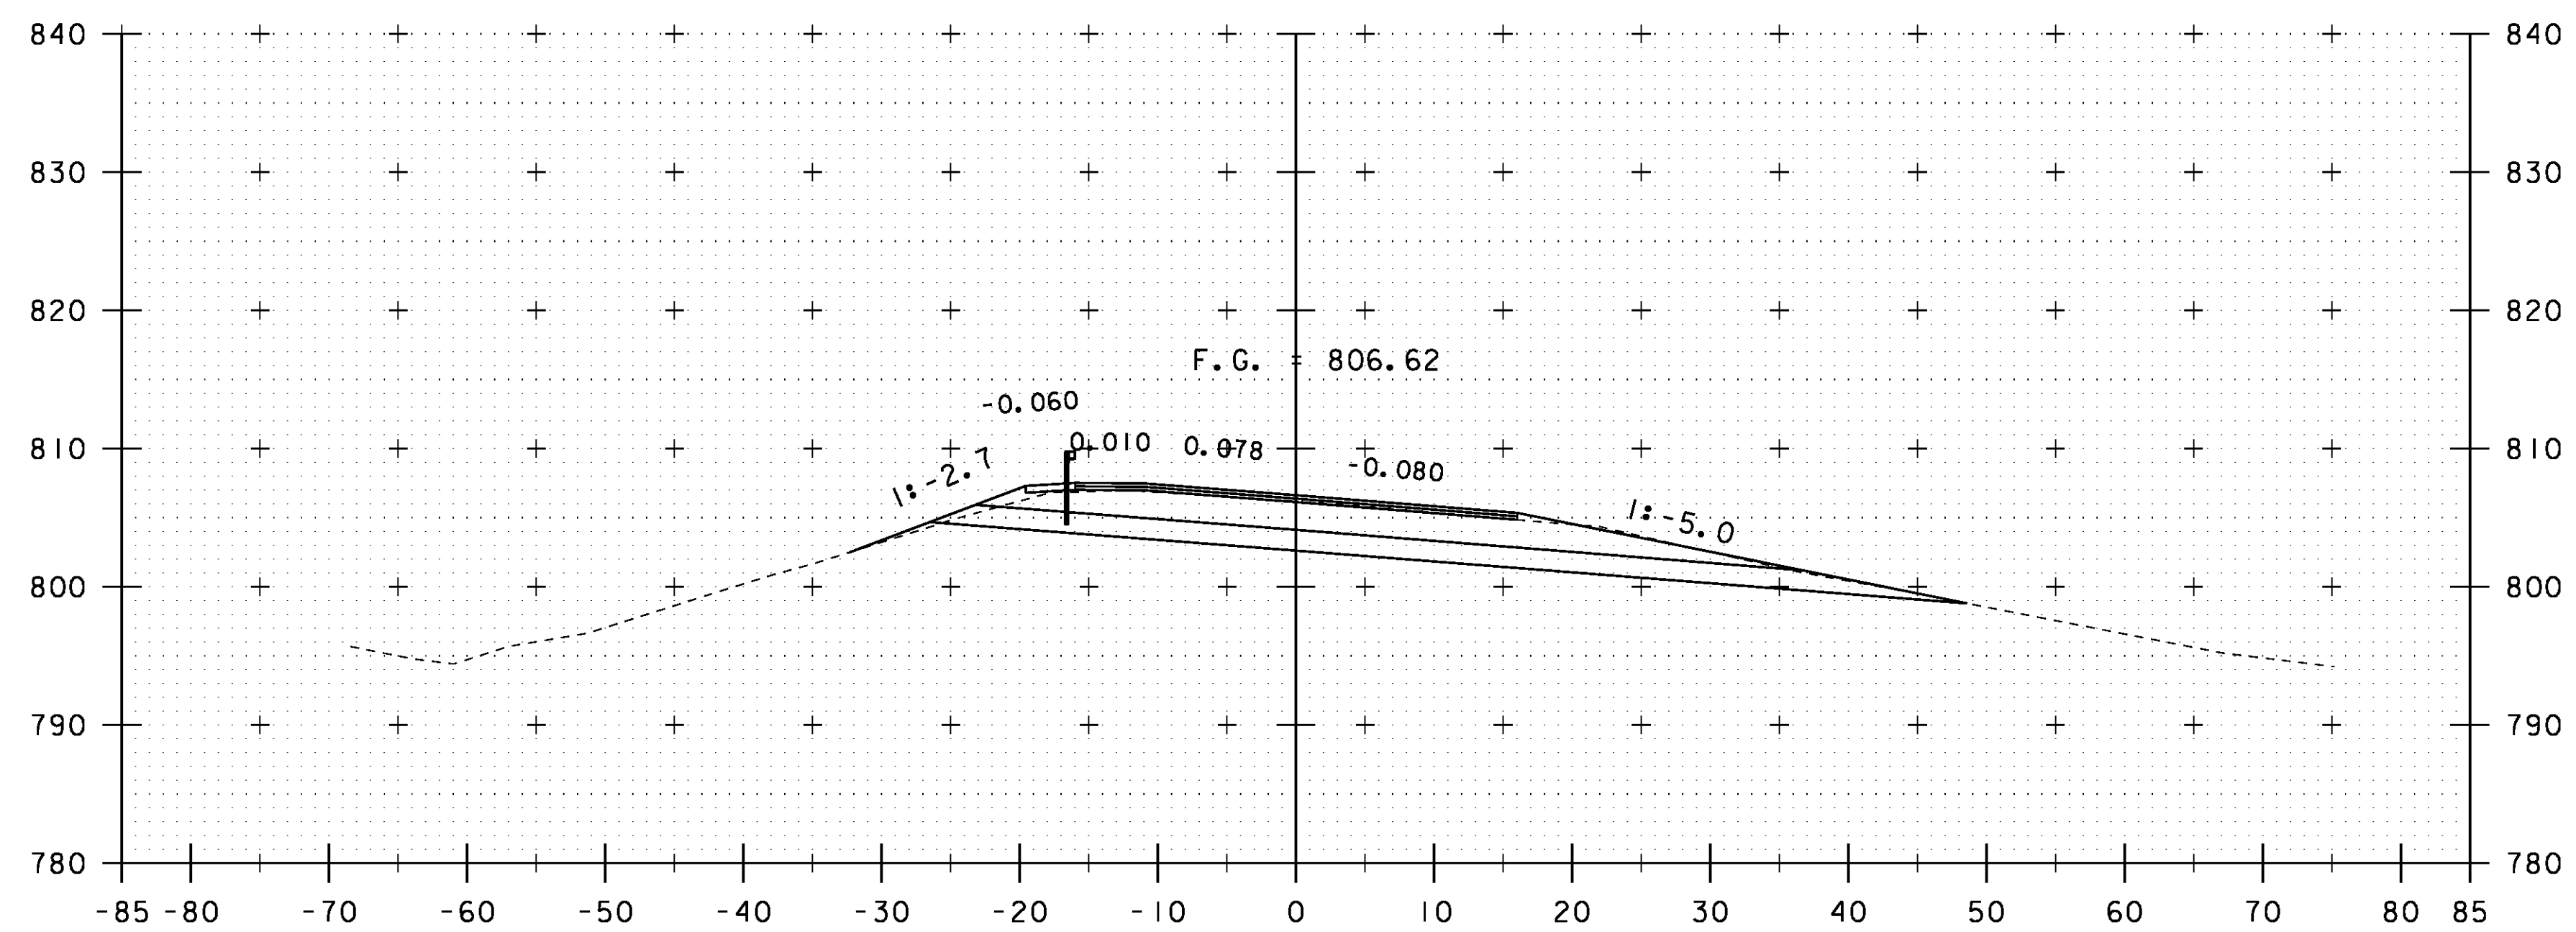

202+00

SCALE 1" = 10'-0"
 10 0 10

STA. 202+00 TO STA. 202+50

PROJECT NAME: WARREN	PLOT DATE: 27-JUL-2012
PROJECT NUMBER: BR 013-4 (14)	DRAWN BY: G. ROKES
FILE NAME: s78f242xs.dgn	CHECKED BY: U. STANLEY
PROJECT LEADER: J. LACROIX	SHEET 63 OF 83
DESIGNED BY: U. STANLEY	
VT 100 CROSS SECTIONS SHEET 3	