


203+50



203+00

SCALE 1" = 10'-0"

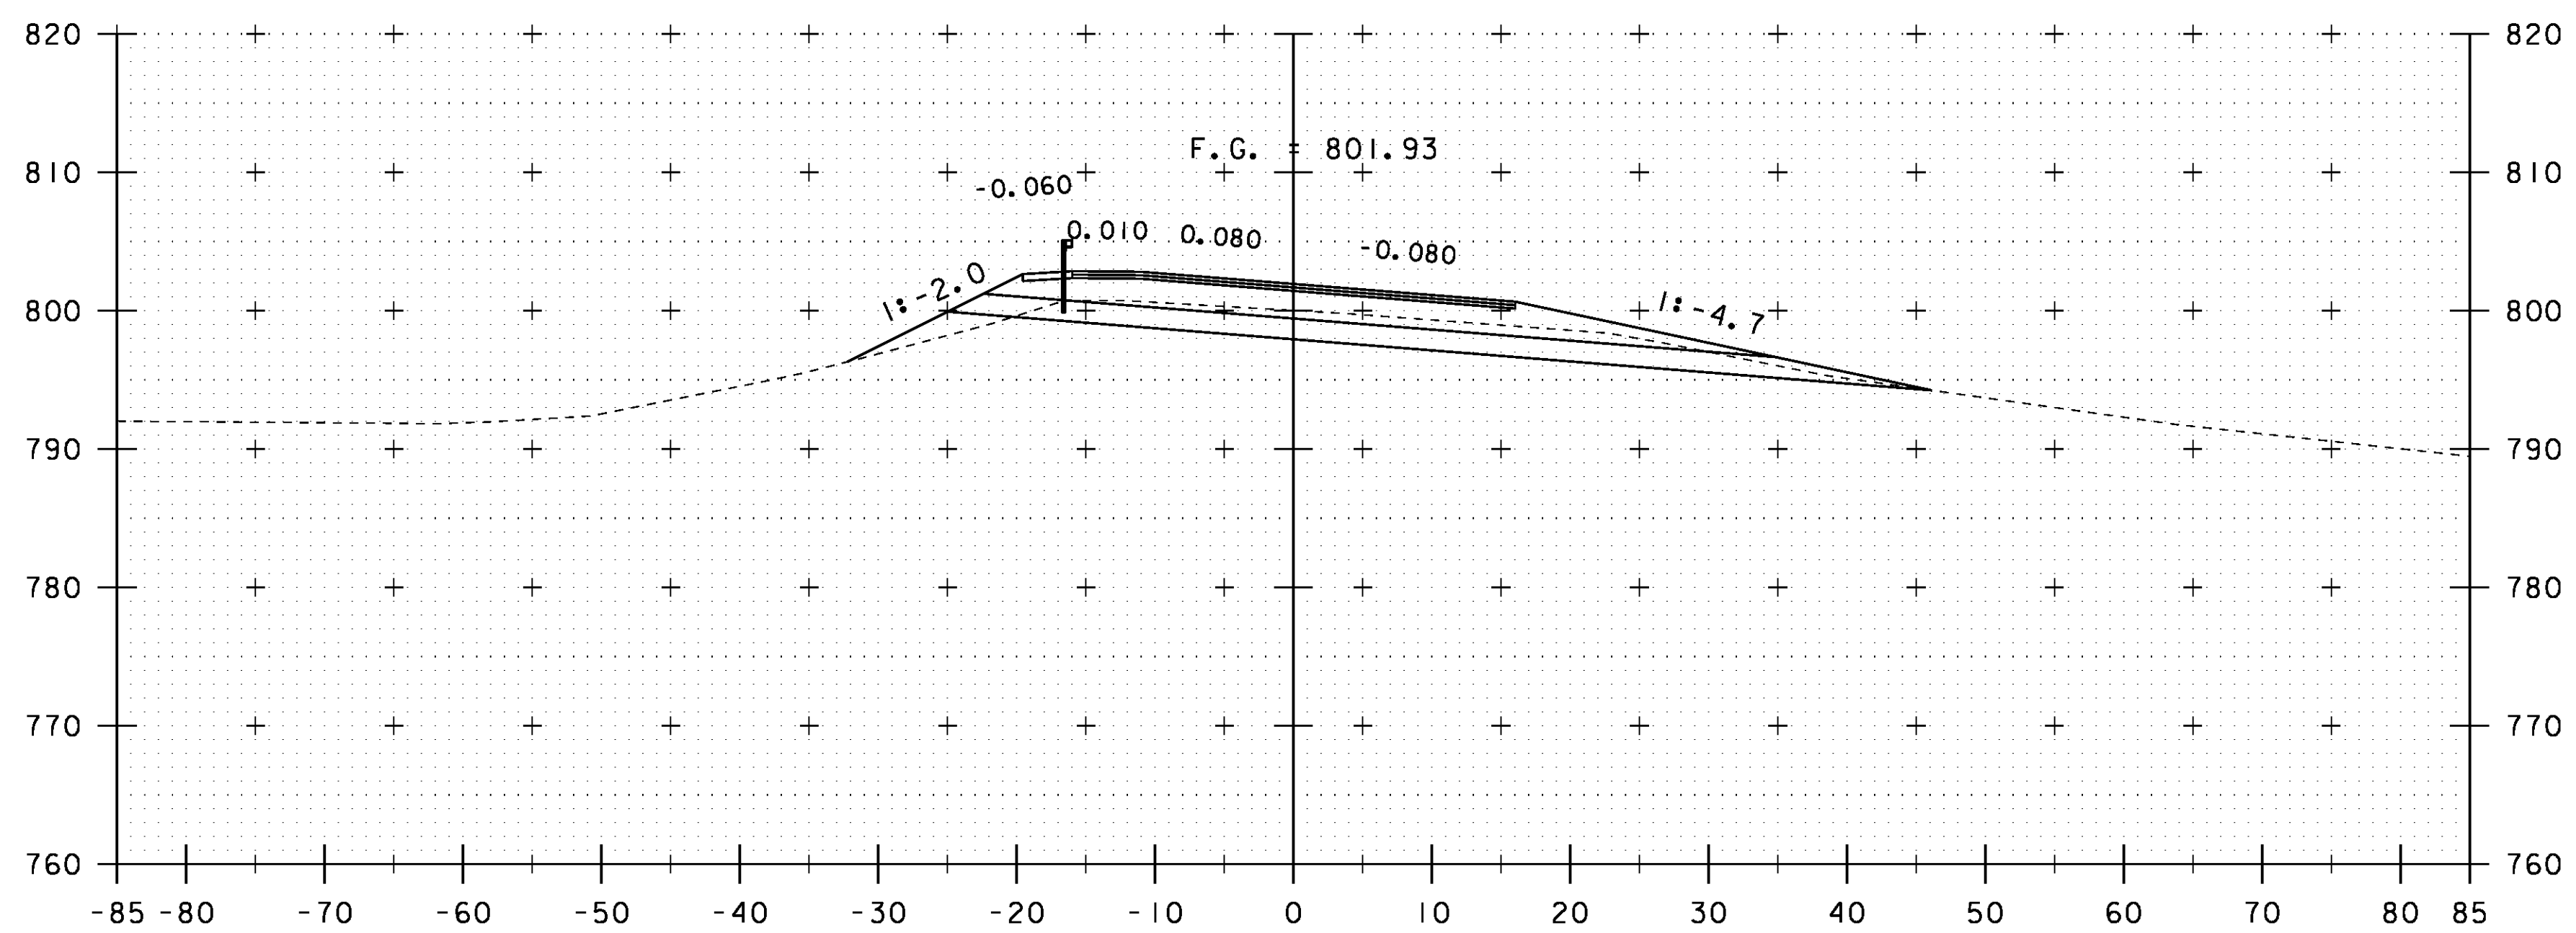

STA. 203+00 TO STA. 203+50

PROJECT NAME: WARREN  
PROJECT NUMBER: BRP 013-4 (14)

FILE NAME: s78f242xs.dgn  
 PROJECT LEADER: J. LACROIX  
 DESIGNED BY: U. STANLEY  
 VT 100 CROSS SECTIONS SHEET 4

PLOT DATE: 27-JUL-2012  
 DRAWN BY: G. ROKES  
 CHECKED BY: U. STANLEY  
 SHEET 64 OF 83