


205+00

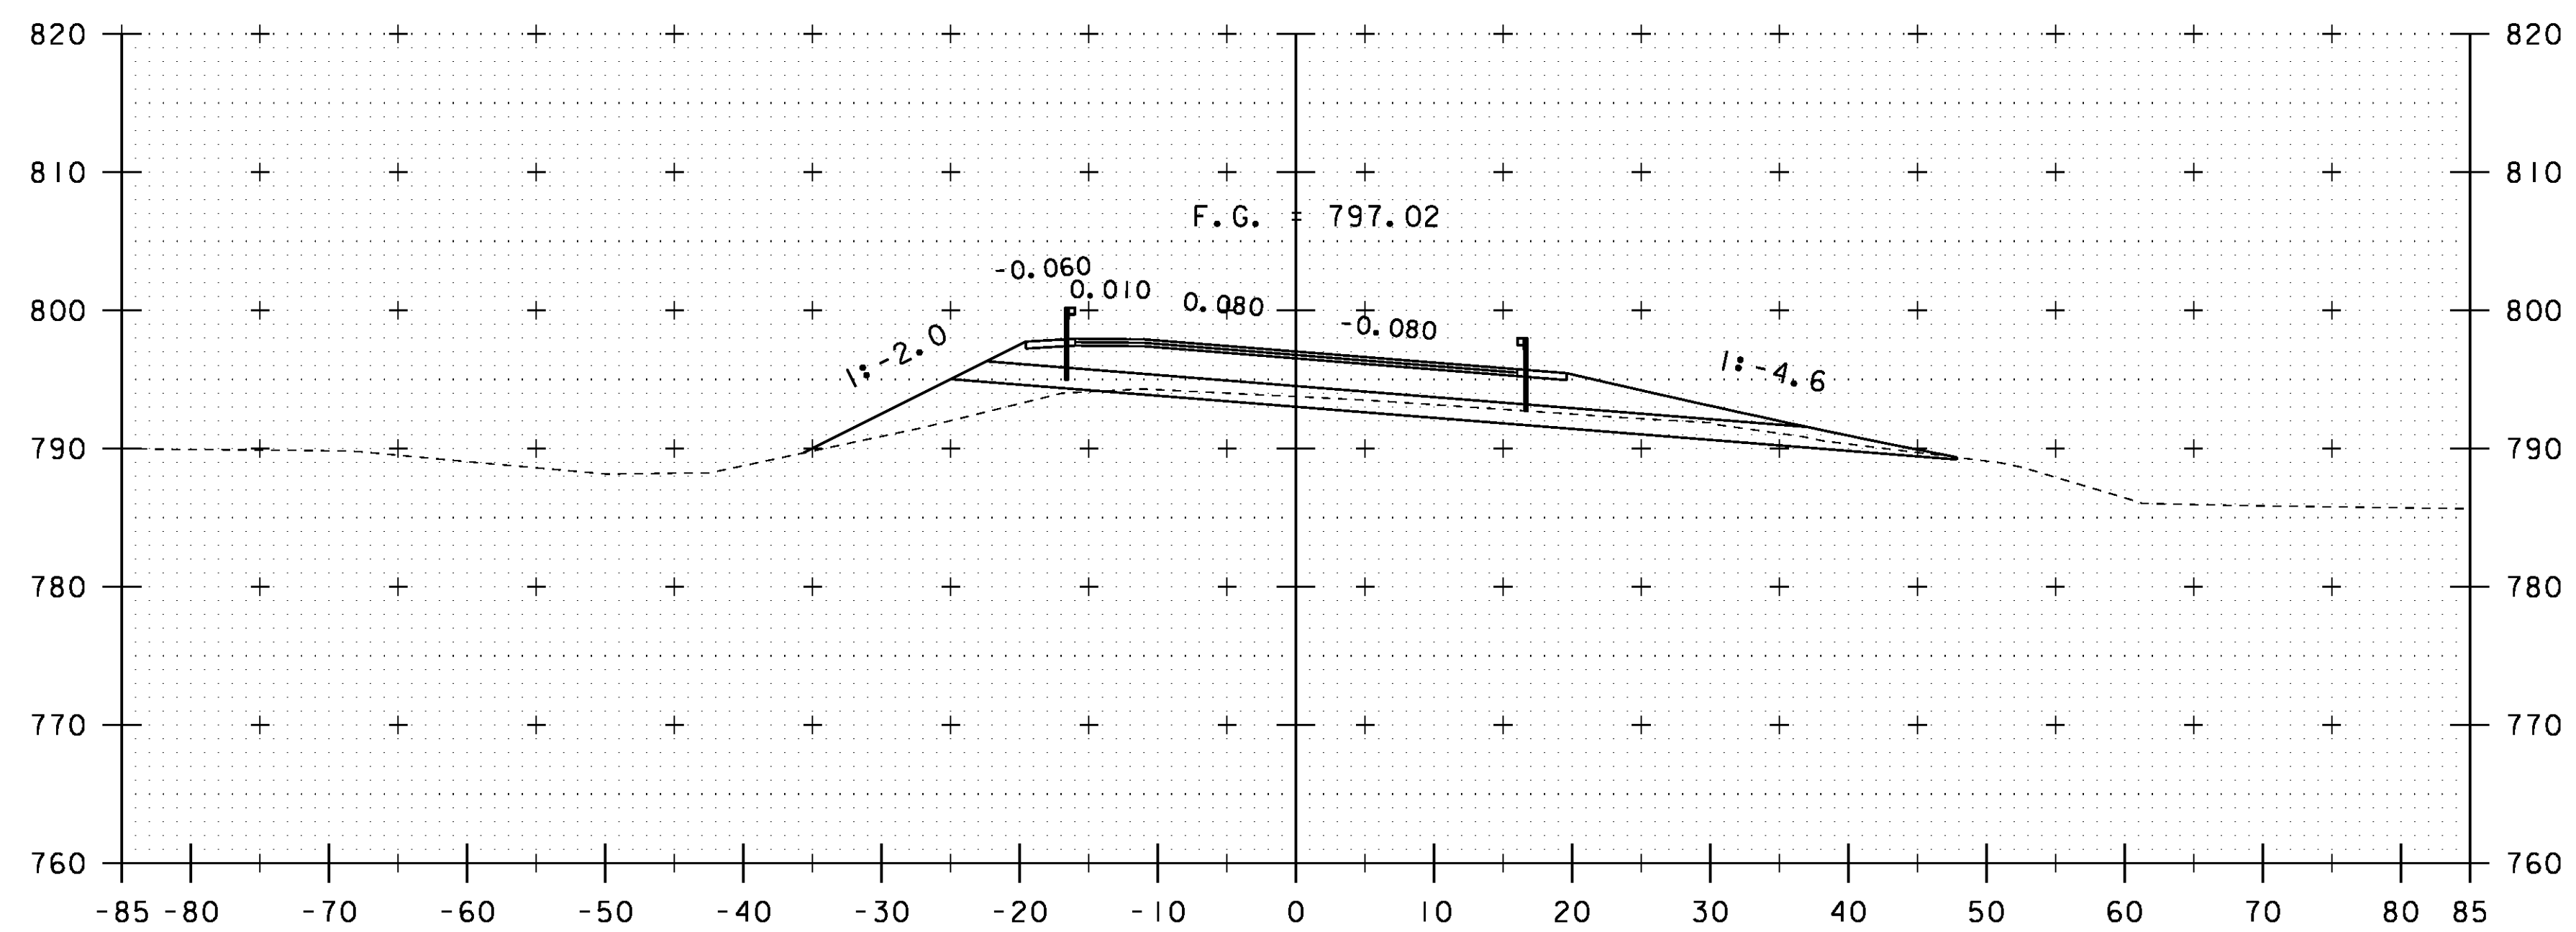

204+50

SCALE 1" = 10'-0"

STA. 204+50 TO STA. 205+00

PROJECT NAME: WARREN	PLOT DATE: 27-JUL-2012
PROJECT NUMBER: BR 013-4 (14)	DRAWN BY: G. ROKES
FILE NAME: s78f242xs.dgn	CHECKED BY: U. STANLEY
PROJECT LEADER: J. LACROIX	SHEET 66 OF 83
DESIGNED BY: U. STANLEY	