


208+00

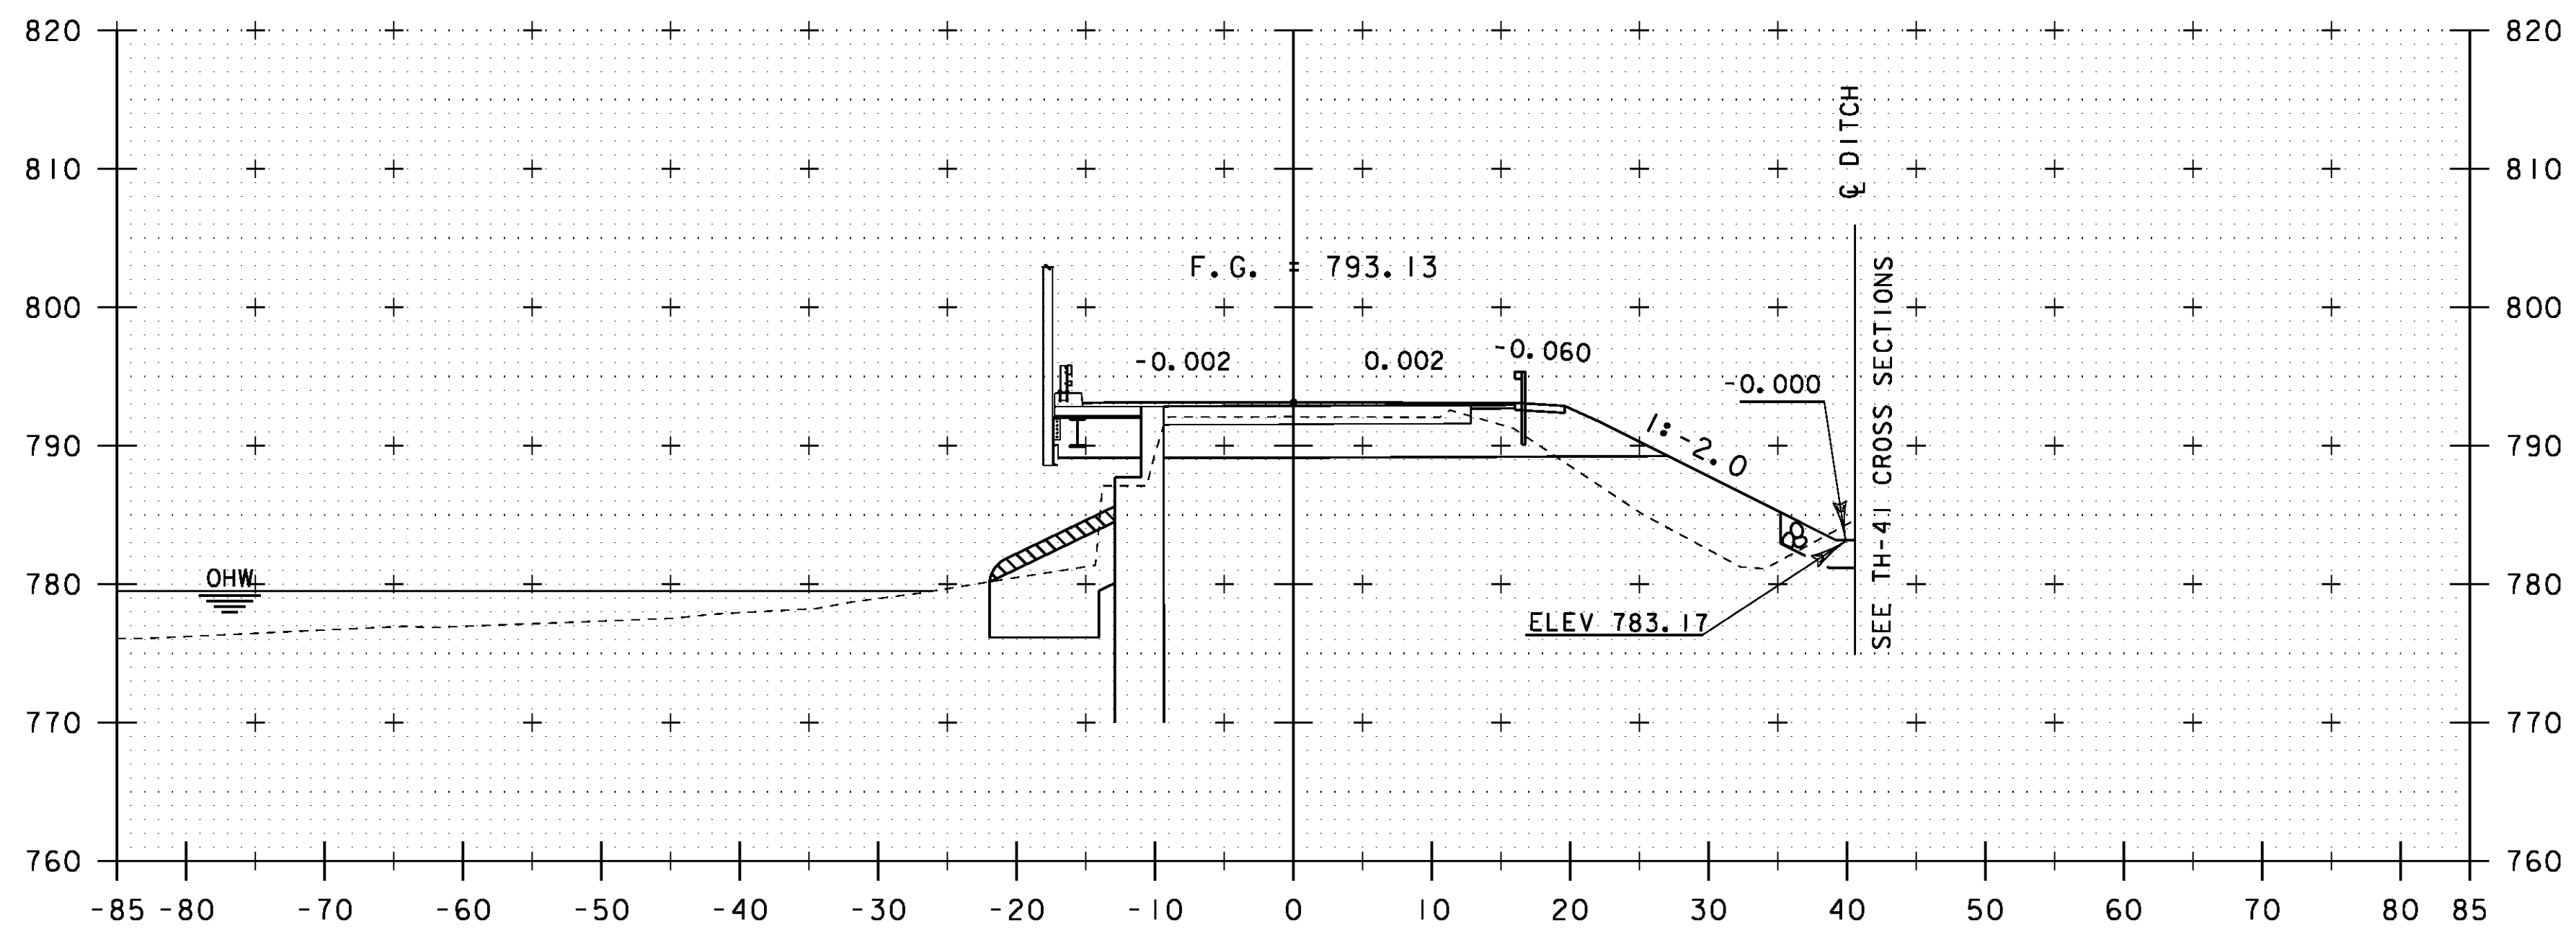

207+50  
END BRIDGE STA. 207+42.45

SCALE 1" = 10'-0"  
10 0 10

STA. 207+50 TO STA. 208+00

PROJECT NAME: WARREN	
PROJECT NUMBER: BRF 013-4 (14)	
FILE NAME: s78f242xs.dgn	PLOT DATE: 27-JUL-2012
PROJECT LEADER: J. LACROIX	DRAWN BY: G. ROKES
DESIGNED BY: U. STANLEY	CHECKED BY: U. STANLEY
VT 100 CROSS SECTIONS SHEET 9	SHEET 69 OF 83