


208+58 TH-9 (LEFT)

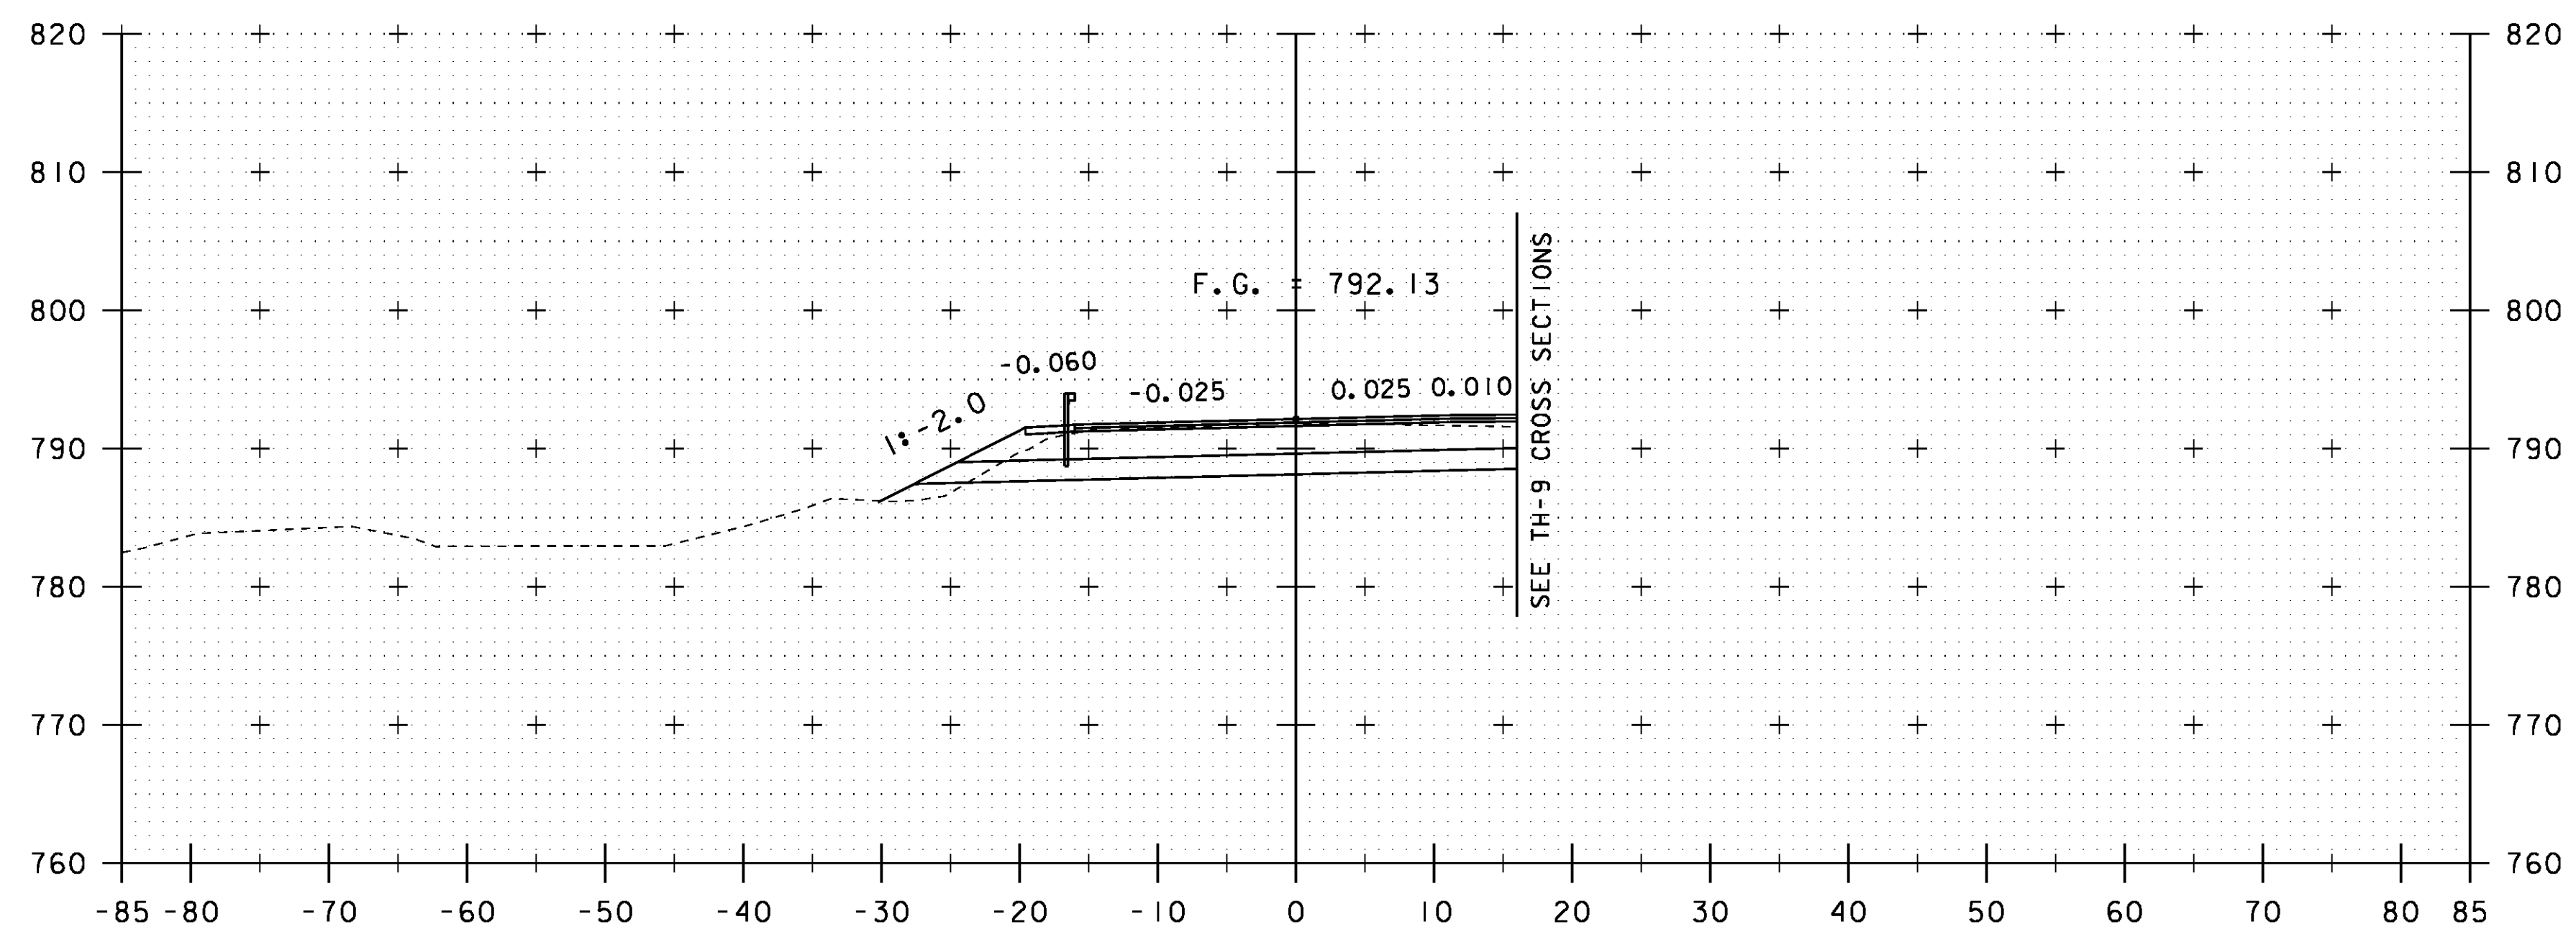

208+50

SCALE 1" = 10'-0"
10 0 10

STA. 208+50 TO STA. 208+58

PROJECT NAME: WARREN
PROJECT NUMBER: BRP 013-4 (14)

FILE NAME: s78f242xs.dgn
PROJECT LEADER: J. LACROIX
DESIGNED BY: U. STANLEY
VT 100 CROSS SECTIONS SHEET 10

PLOT DATE: 27-JUL-2012
DRAWN BY: G. ROKES
CHECKED BY: U. STANLEY
SHEET 70 OF 83