



209+50

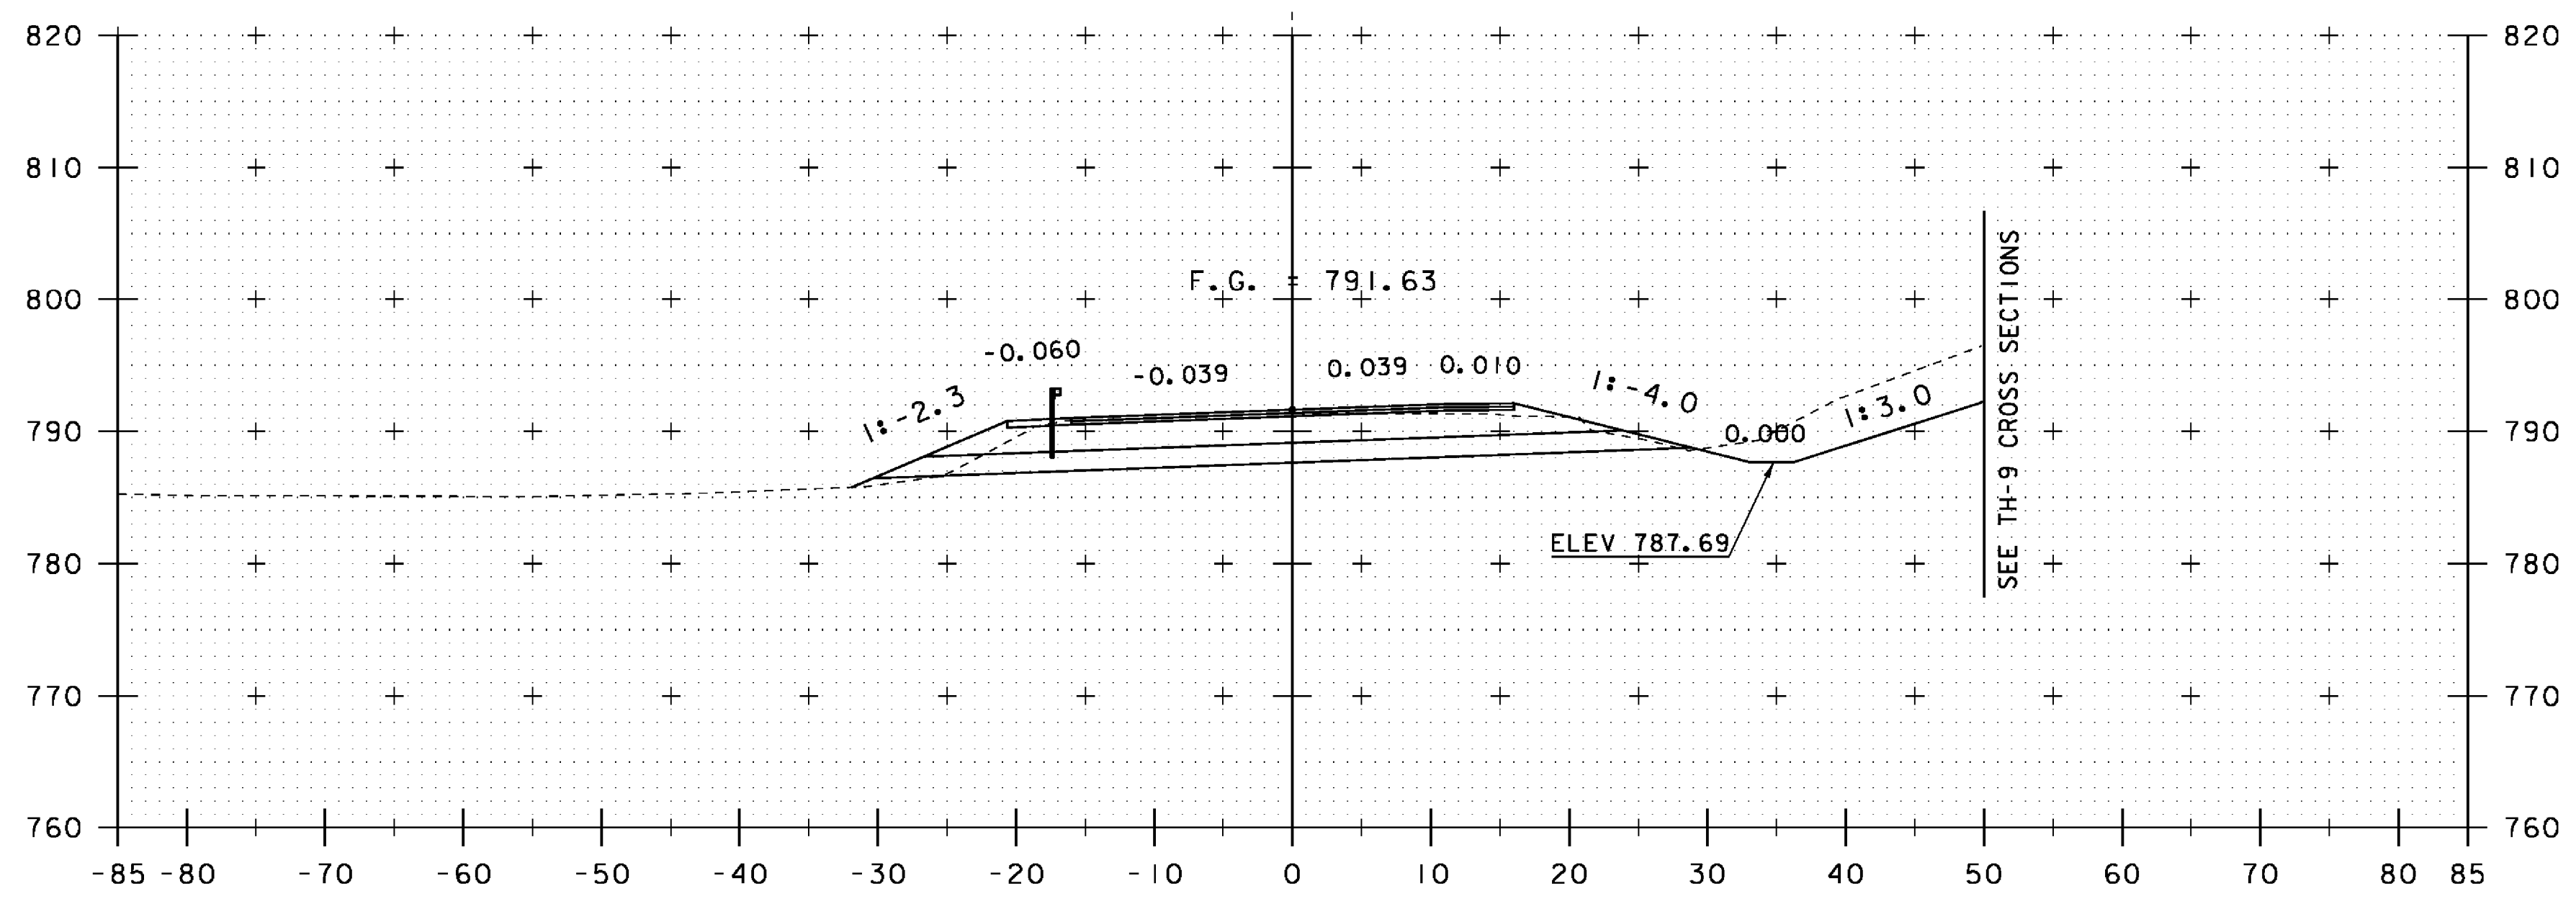

209+00

BEGIN - SOLID ROCK EXCAVATION

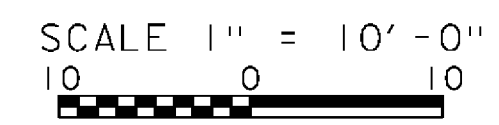

STA. 209+00 TO STA. 209+50

PROJECT NAME:	WARREN	PLOT DATE:	27-JUL-2012
PROJECT NUMBER:	BRF 013-4 (14)	DRAWN BY:	G. ROKES
FILE NAME:	s78f242xs.dgn	CHECKED BY:	U. STANLEY
PROJECT LEADER:	J. LACROIX	SHEET	71 OF 83
DESIGNED BY:	U. STANLEY		
VT 100 CROSS SECTIONS SHEET II			