



210+50

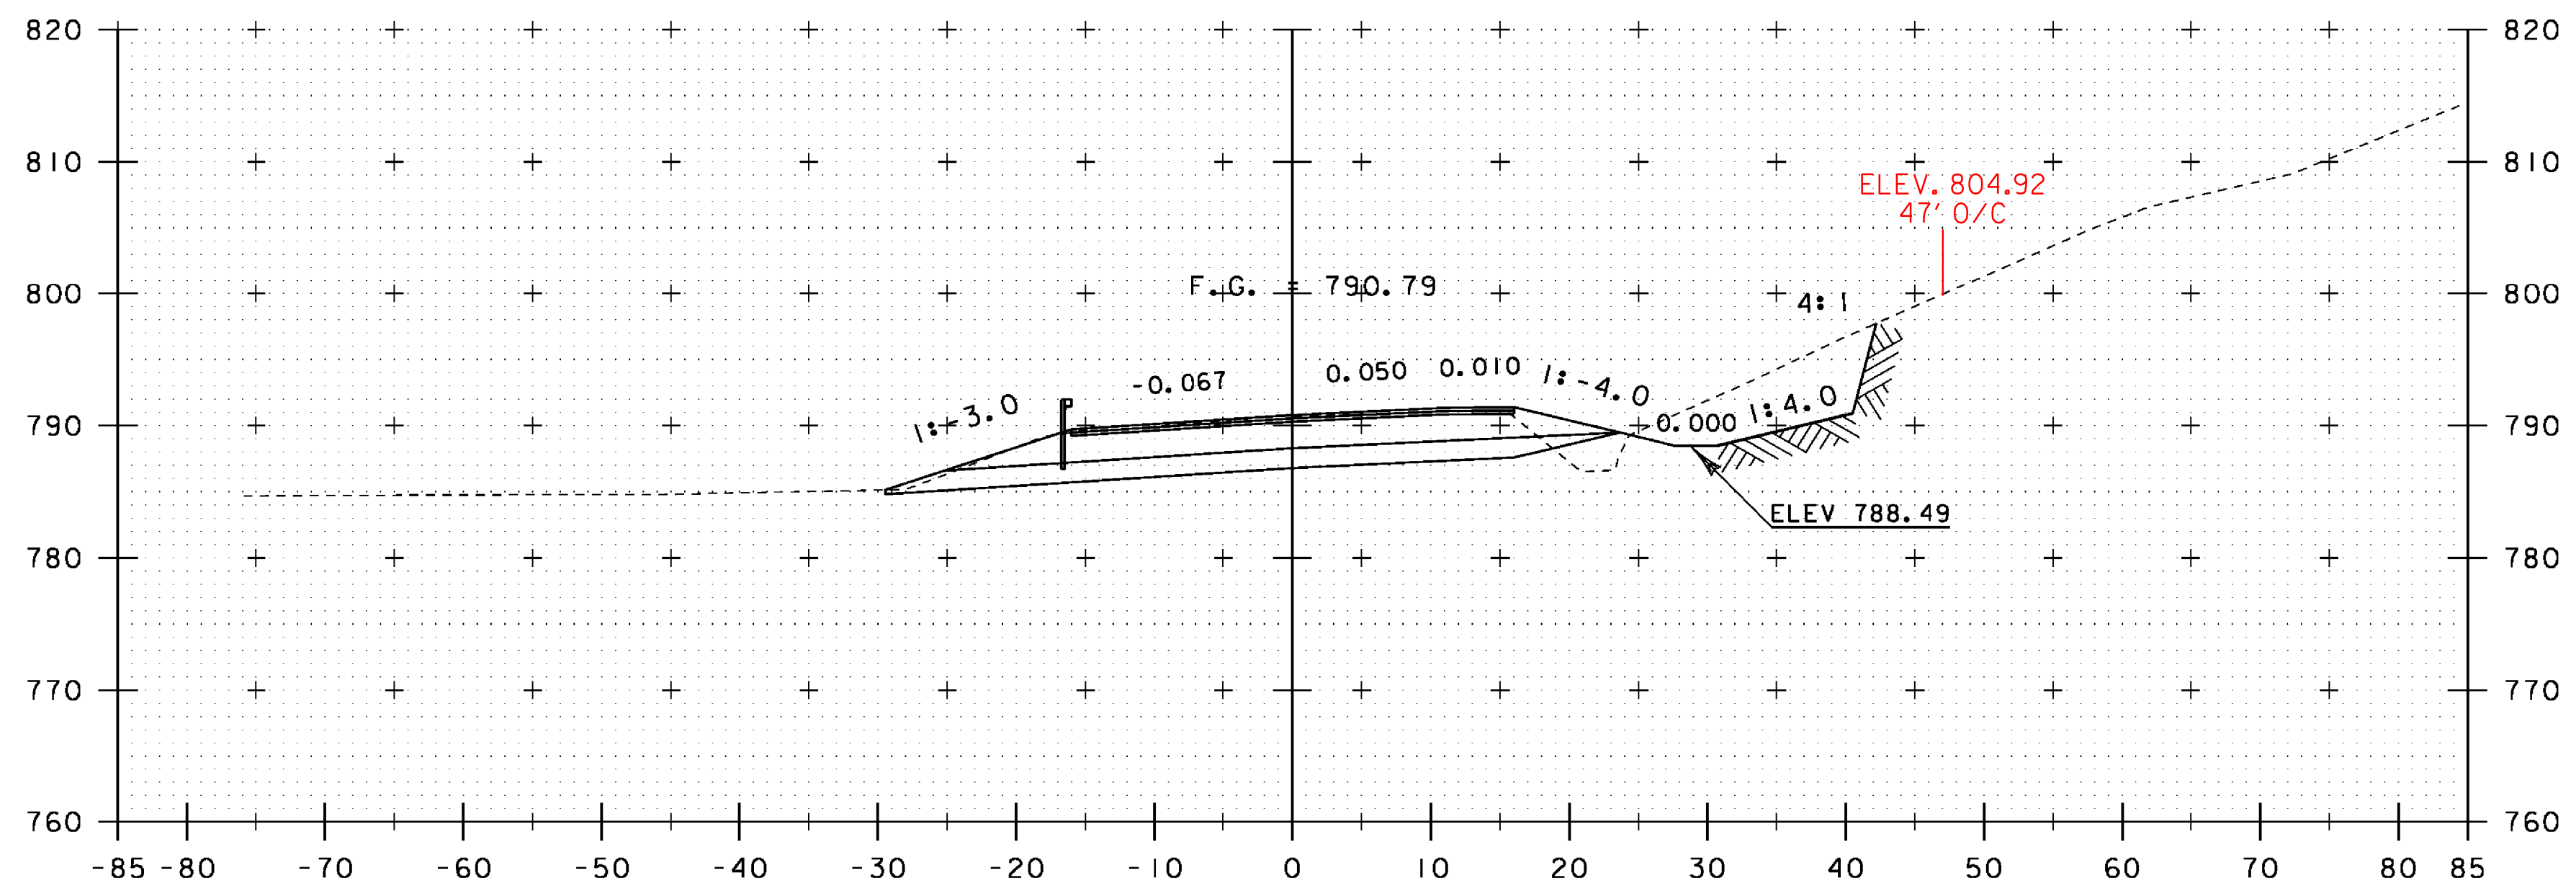

210+00

STA. 210+00.00 END PROJECT BEGIN APPROACH
 END - SOLID ROCK EXCAVATION

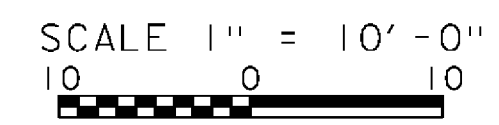

STA. 210+00 TO STA. 210+50

PROJECT NAME: WARREN	PLOT DATE: 27-JUL-2012
PROJECT NUMBER: BRF 013-4 (14)	DRAWN BY: G. ROKES
FILE NAME: s78f242xs.dgn	CHECKED BY: U. STANLEY
PROJECT LEADER: J. LACROIX	SHEET 72 OF 83
DESIGNED BY: U. STANLEY	
VT 100 CROSS SECTIONS SHEET 12	