


211+30

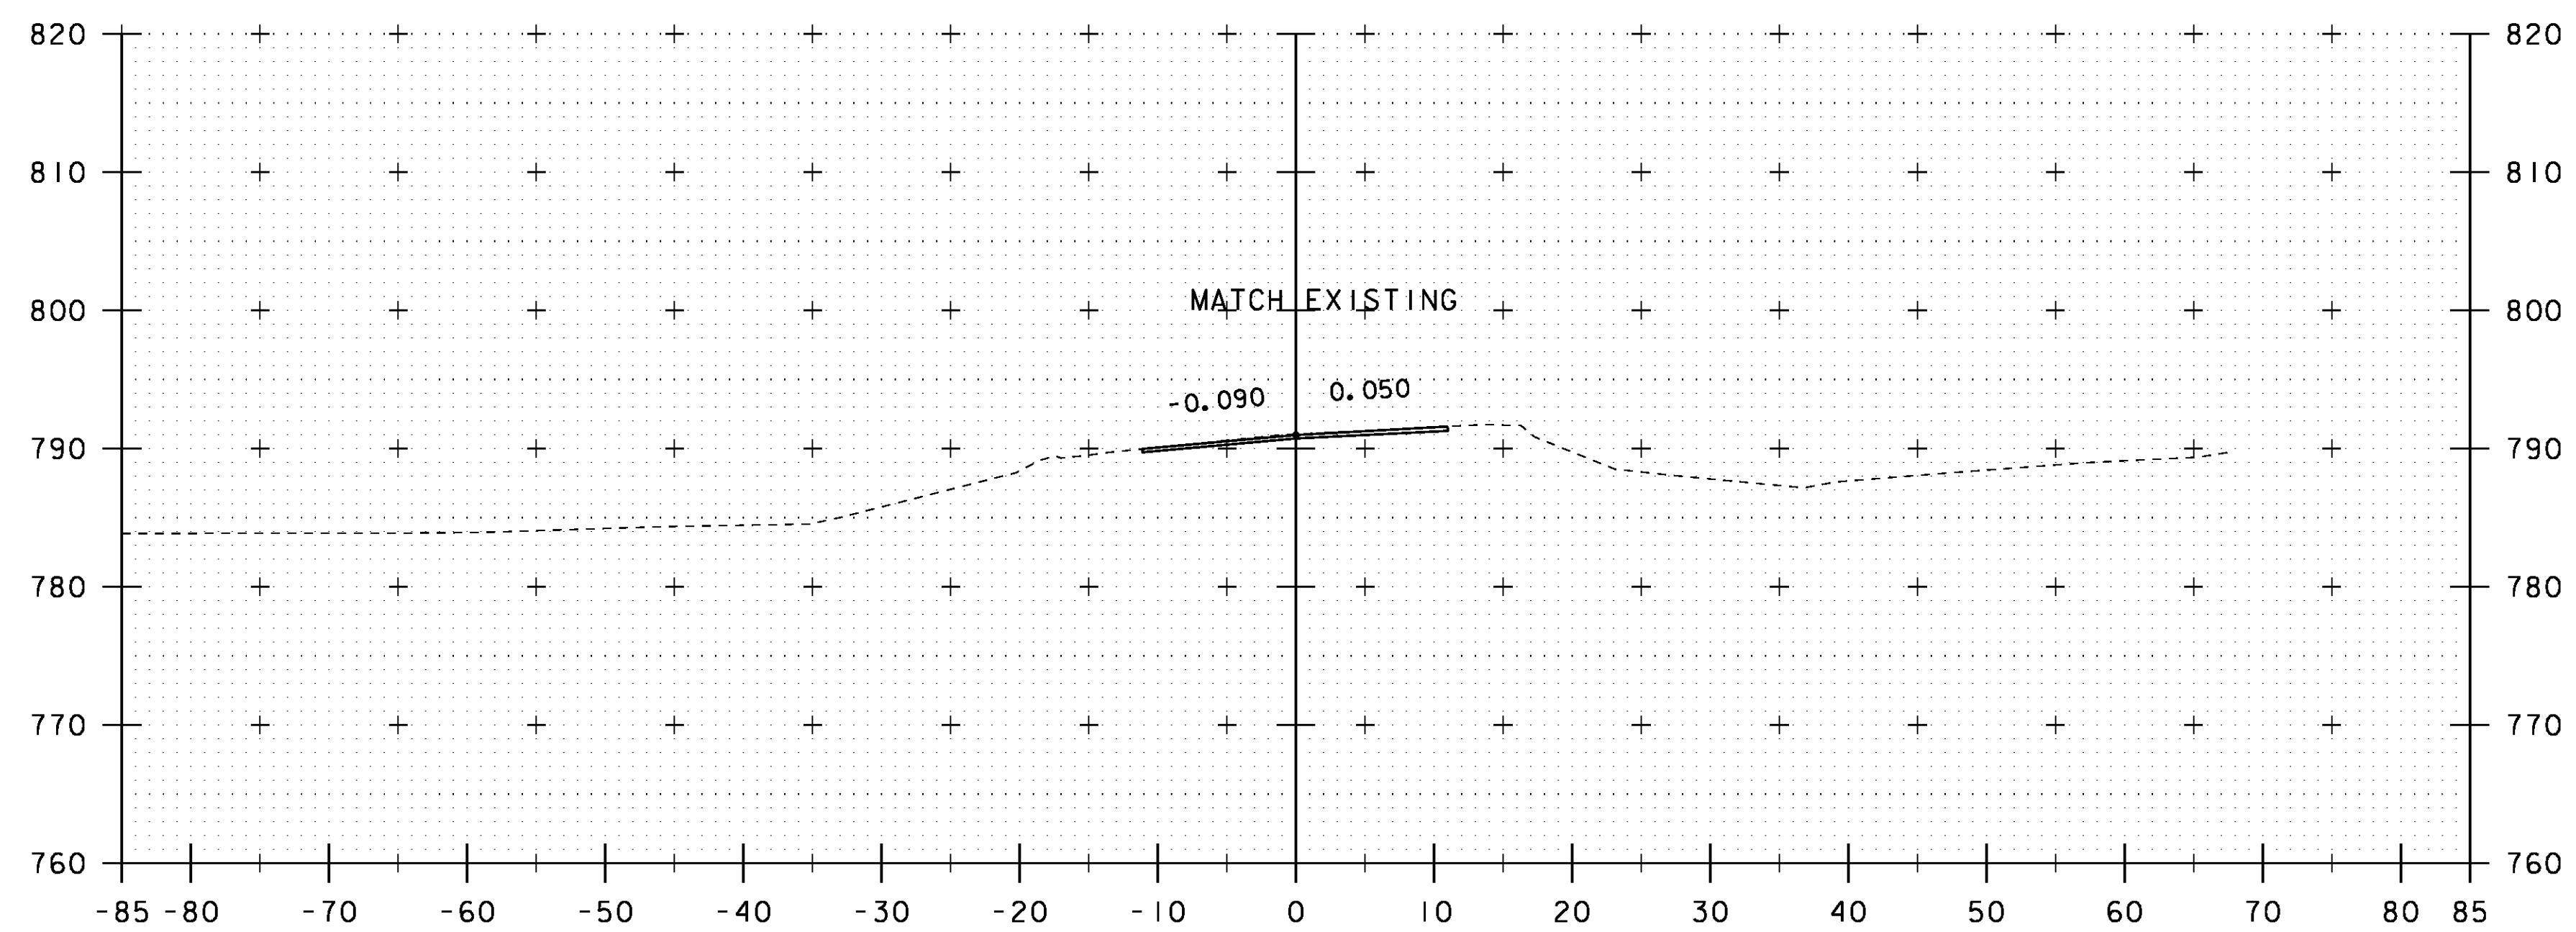

211+00
END APPROACH

SCALE 1" = 10'-0"
10 0 10

STA. 211+00 TO STA. 211+30

PROJECT NAME: WARREN
PROJECT NUMBER: BR 013-4 (14)

FILE NAME: s78f242xs.dgn	PLOT DATE: 27-JUL-2012
PROJECT LEADER: J. LACROIX	DRAWN BY: G. ROKES
DESIGNED BY: U. STANLEY	CHECKED BY: U. STANLEY
VT 100 CROSS SECTIONS SHEET 13	SHEET 73 OF 83