




300+37  
SKEWED PIPE SECTION

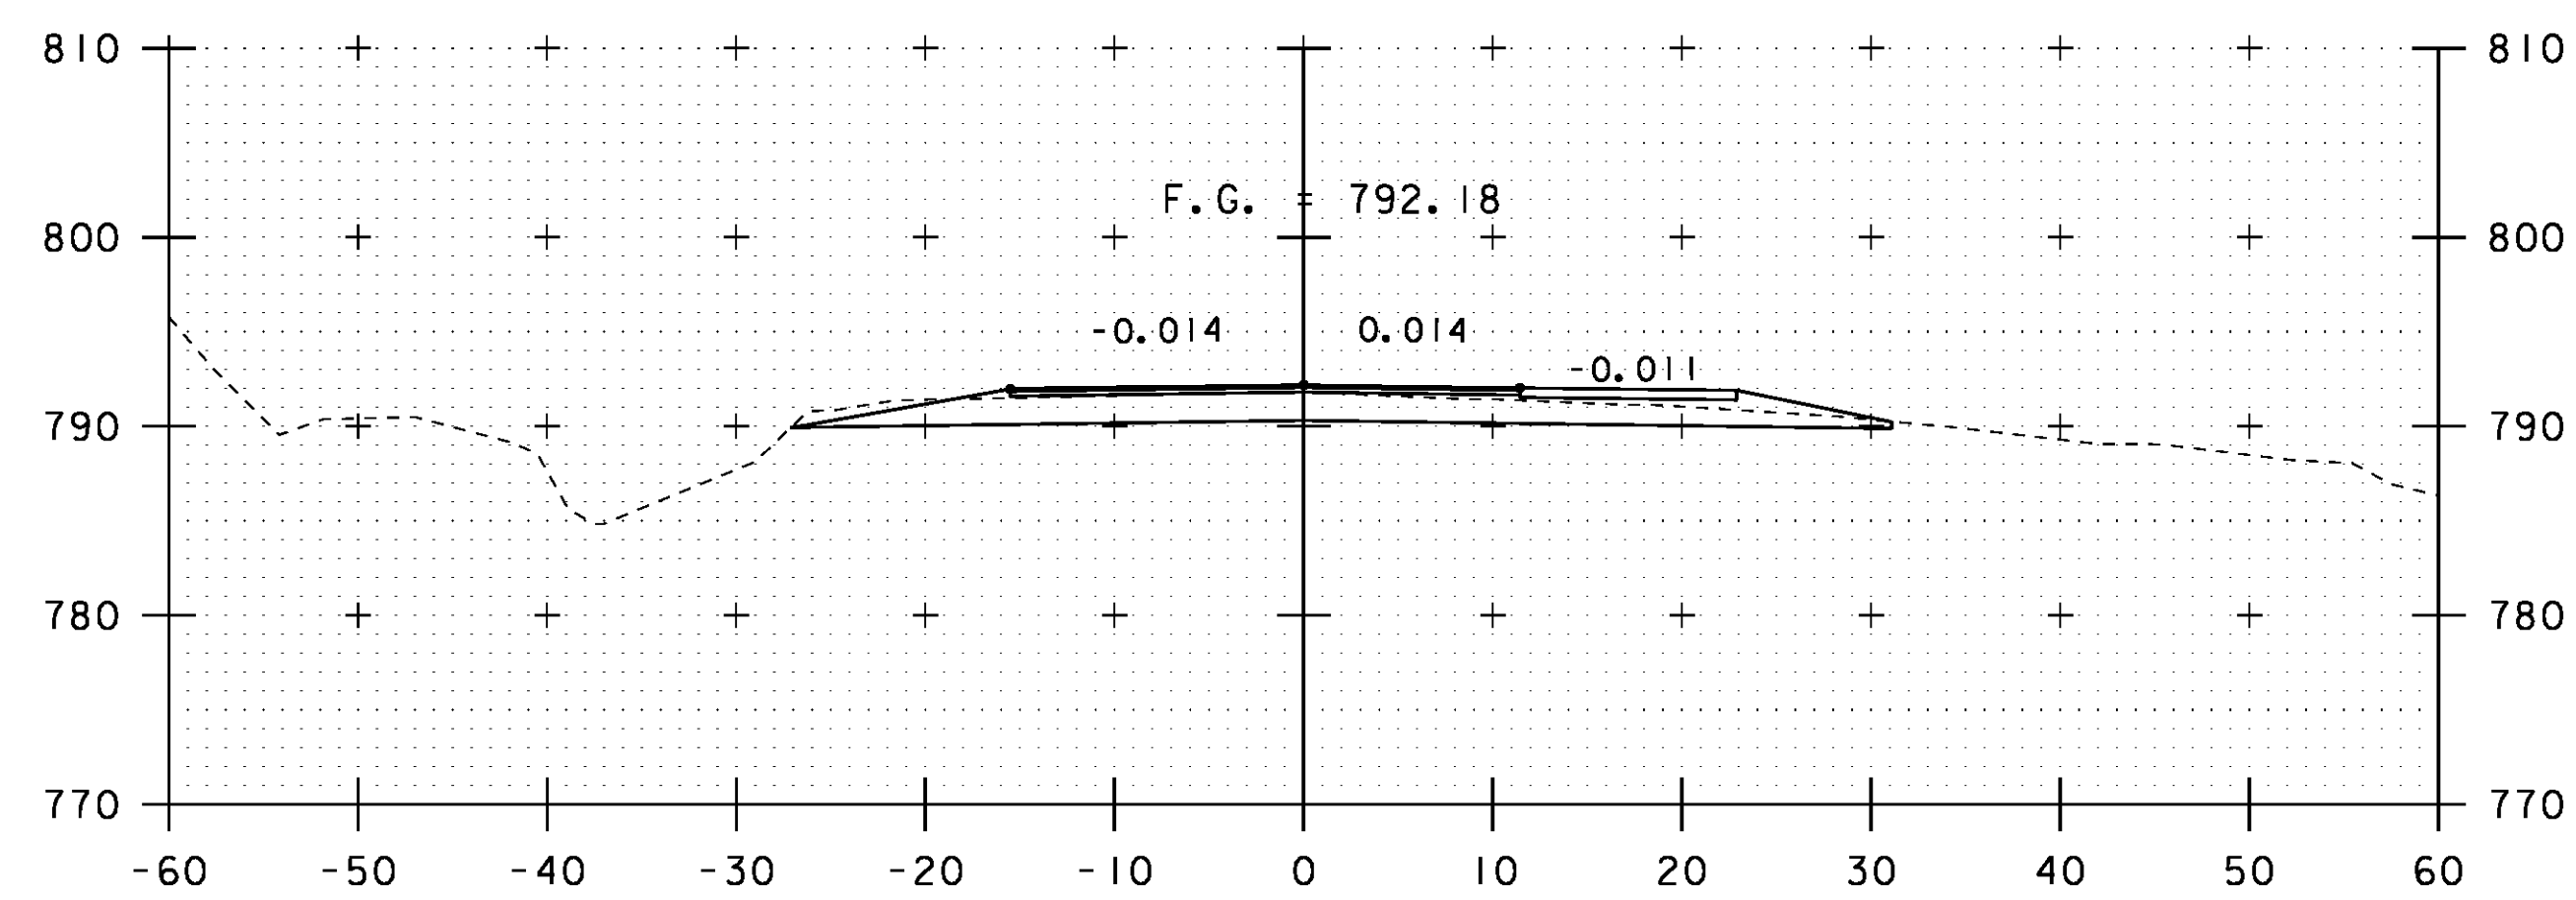


300+25

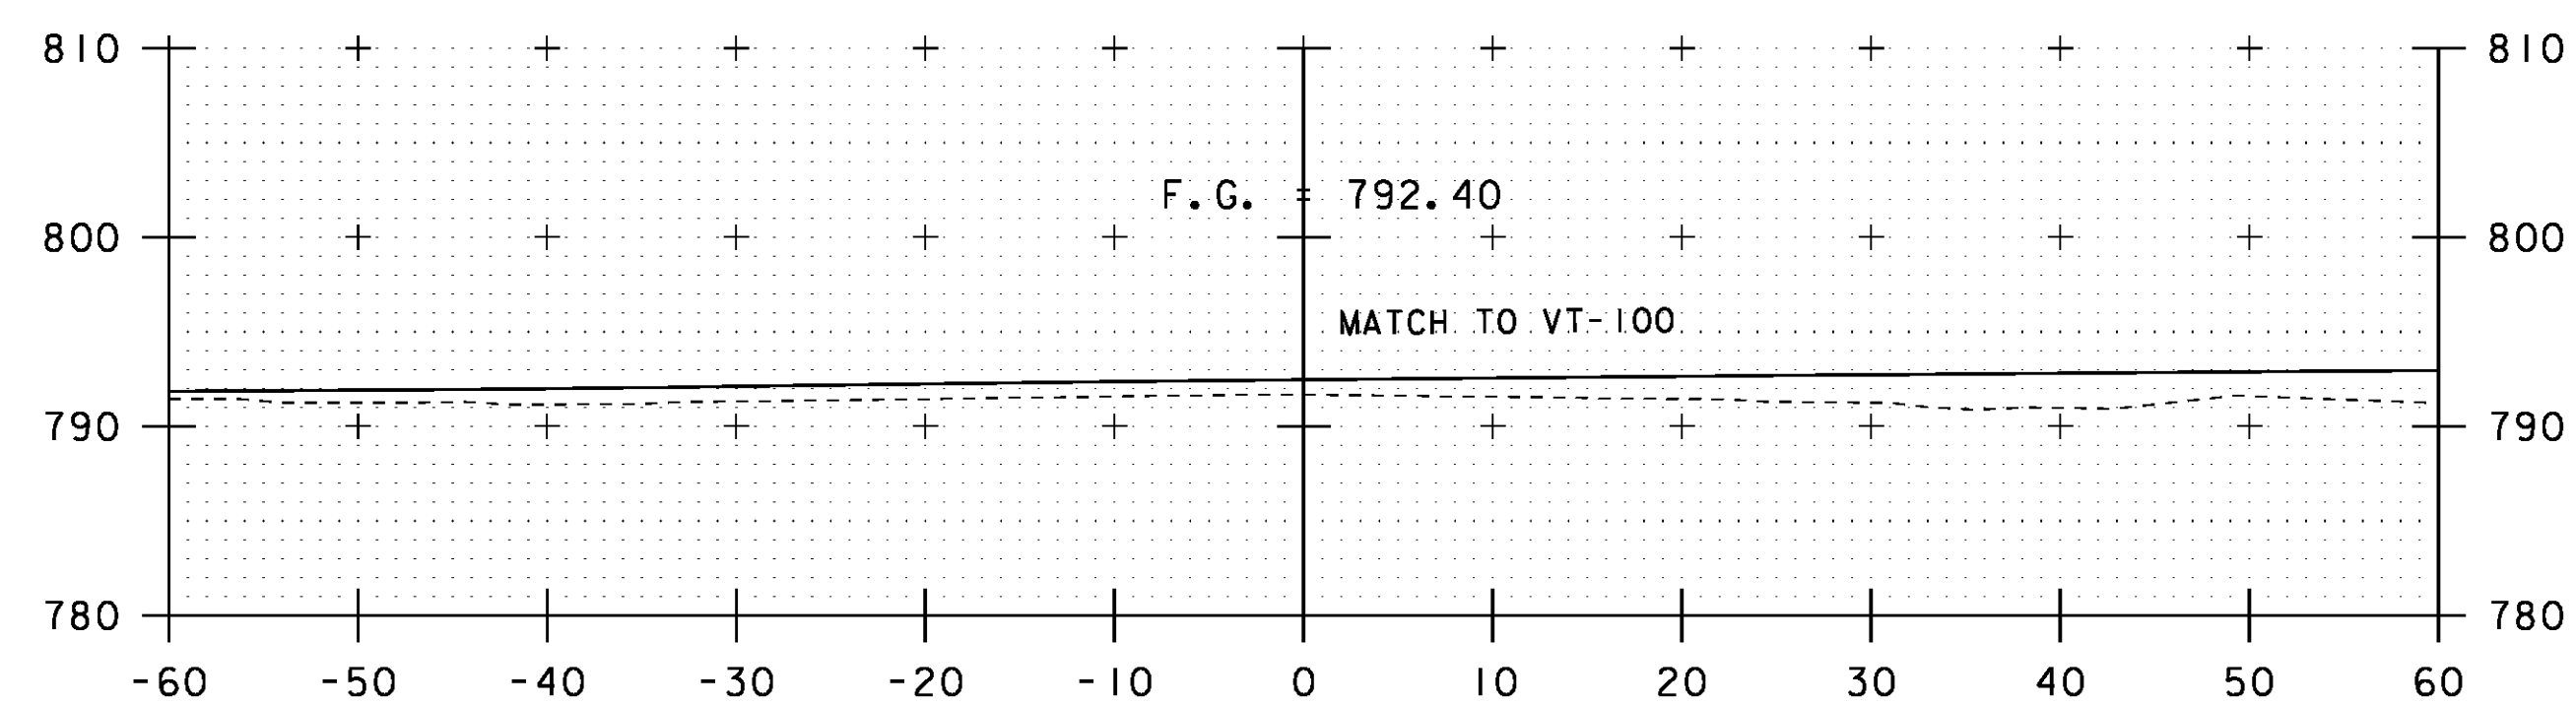

300+16  
SHOULDER OF VT-100

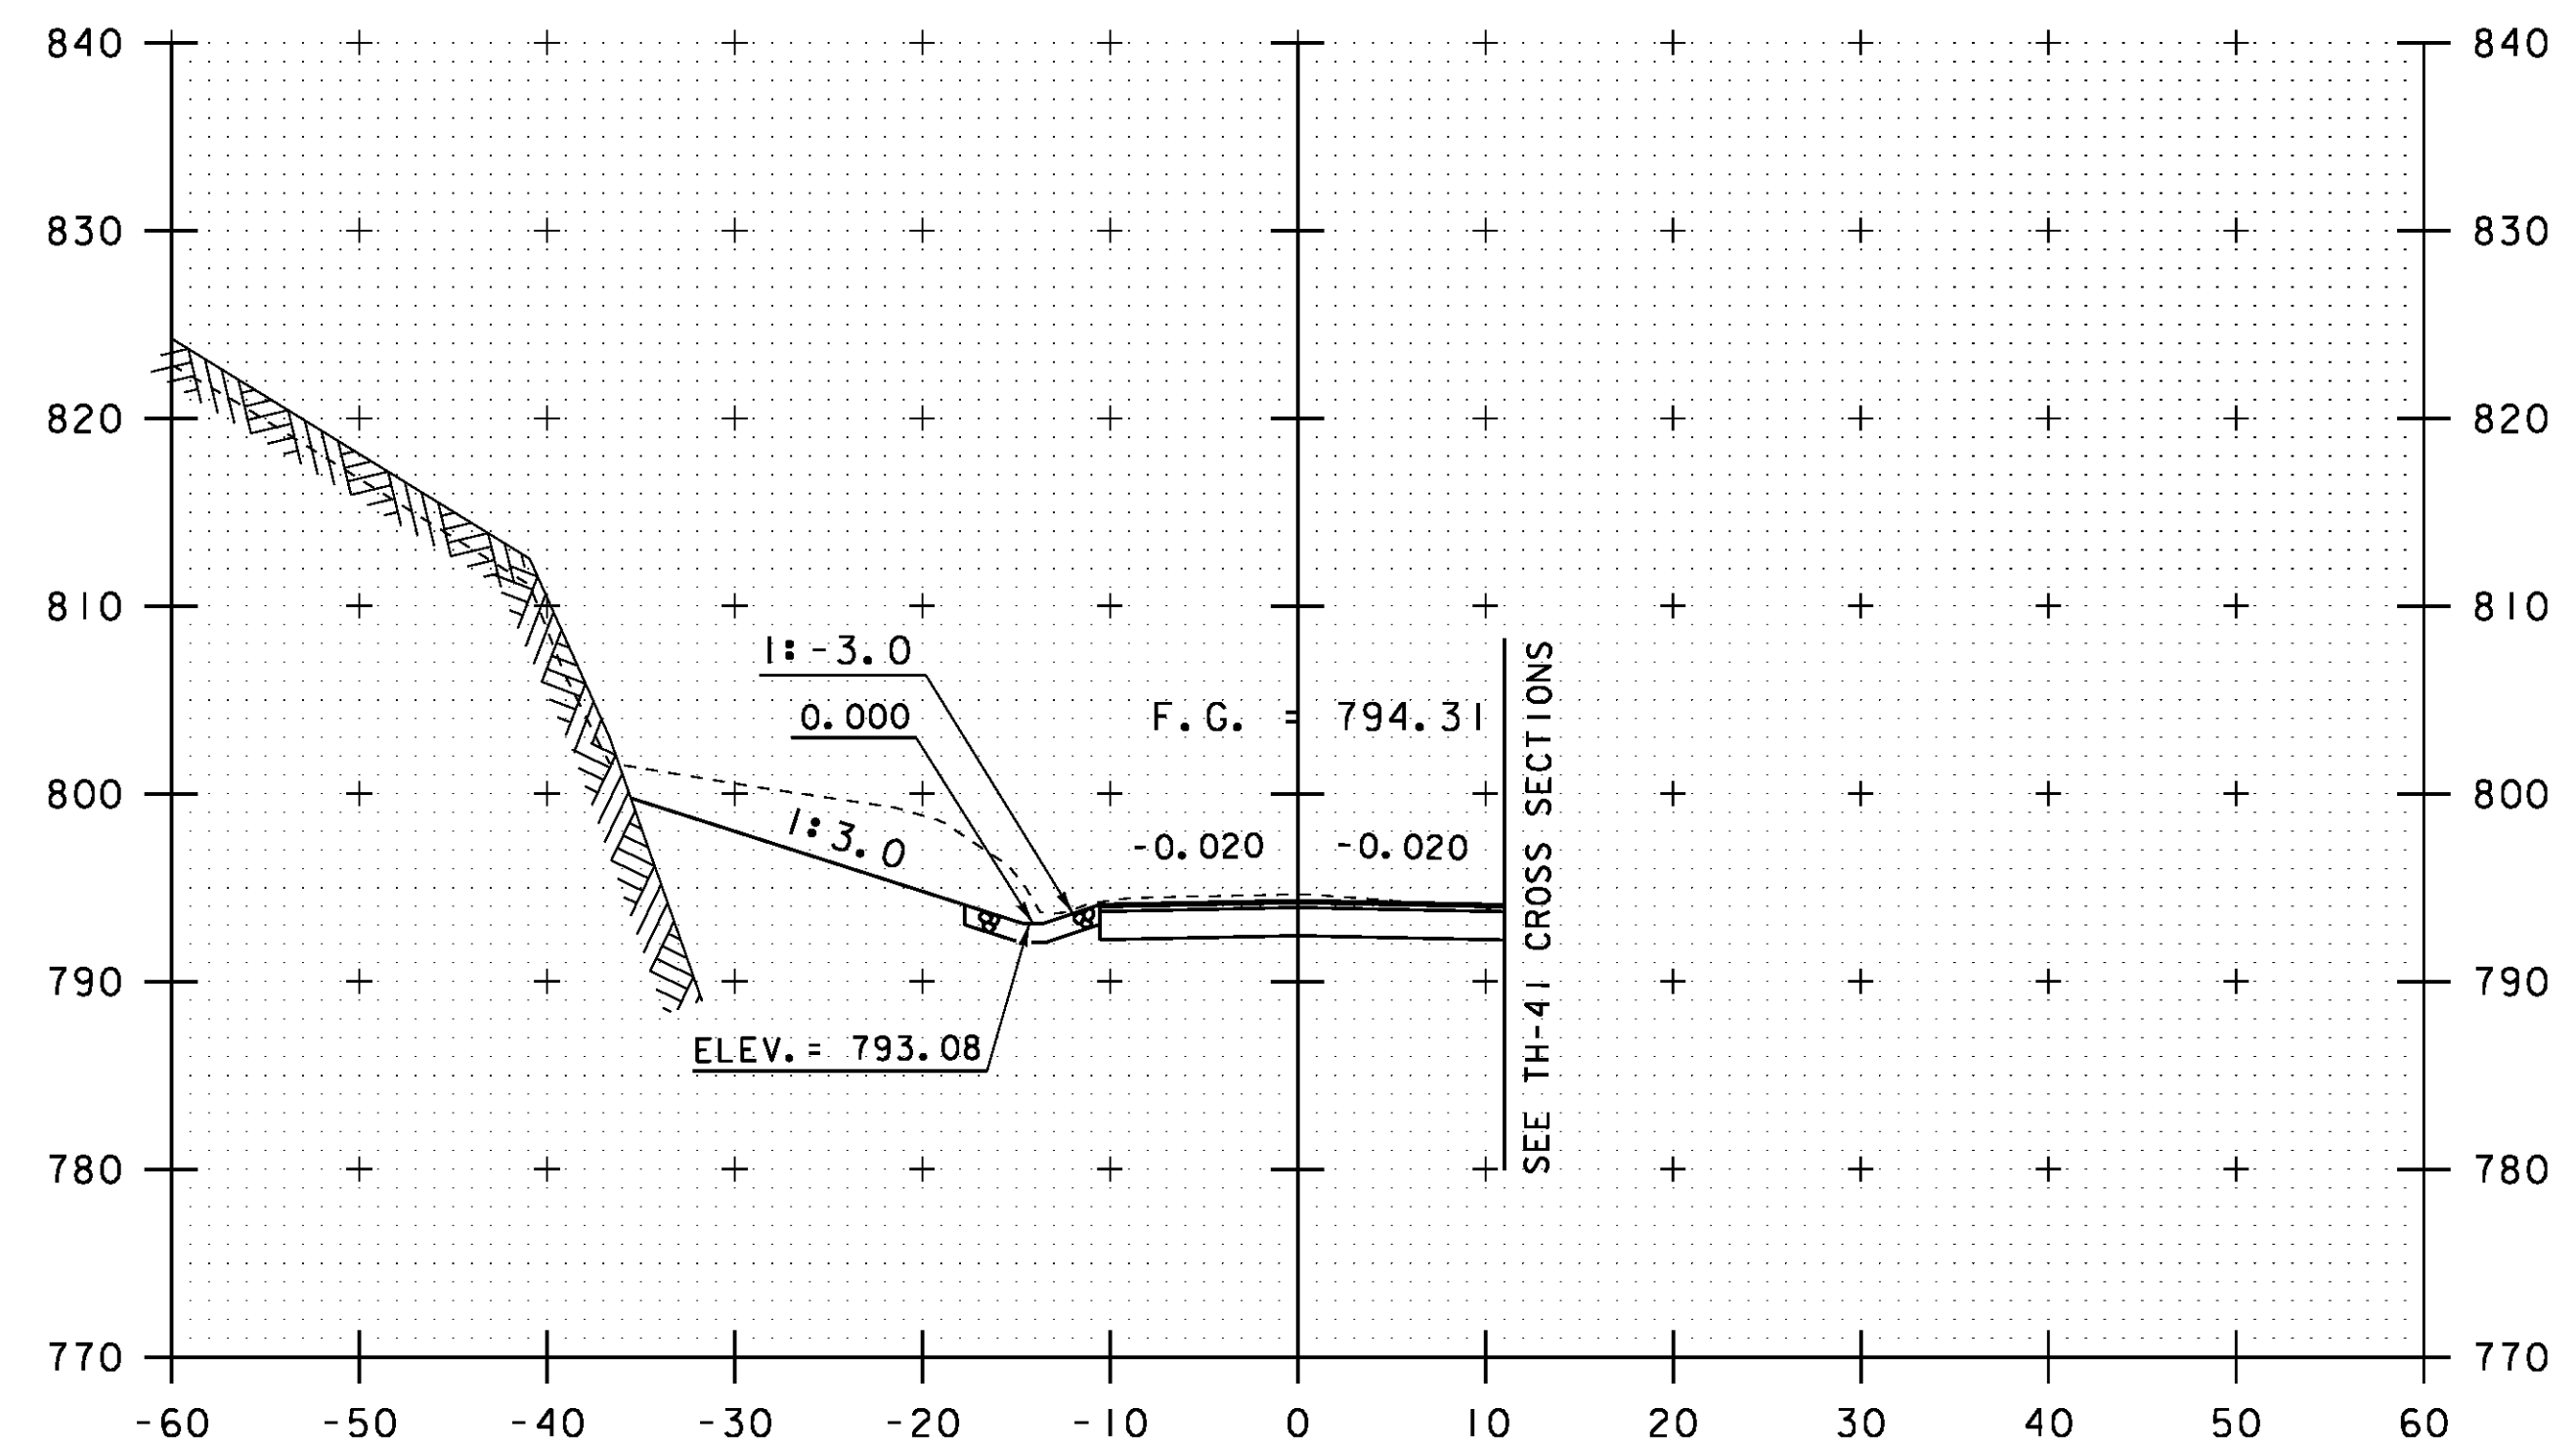

300+75

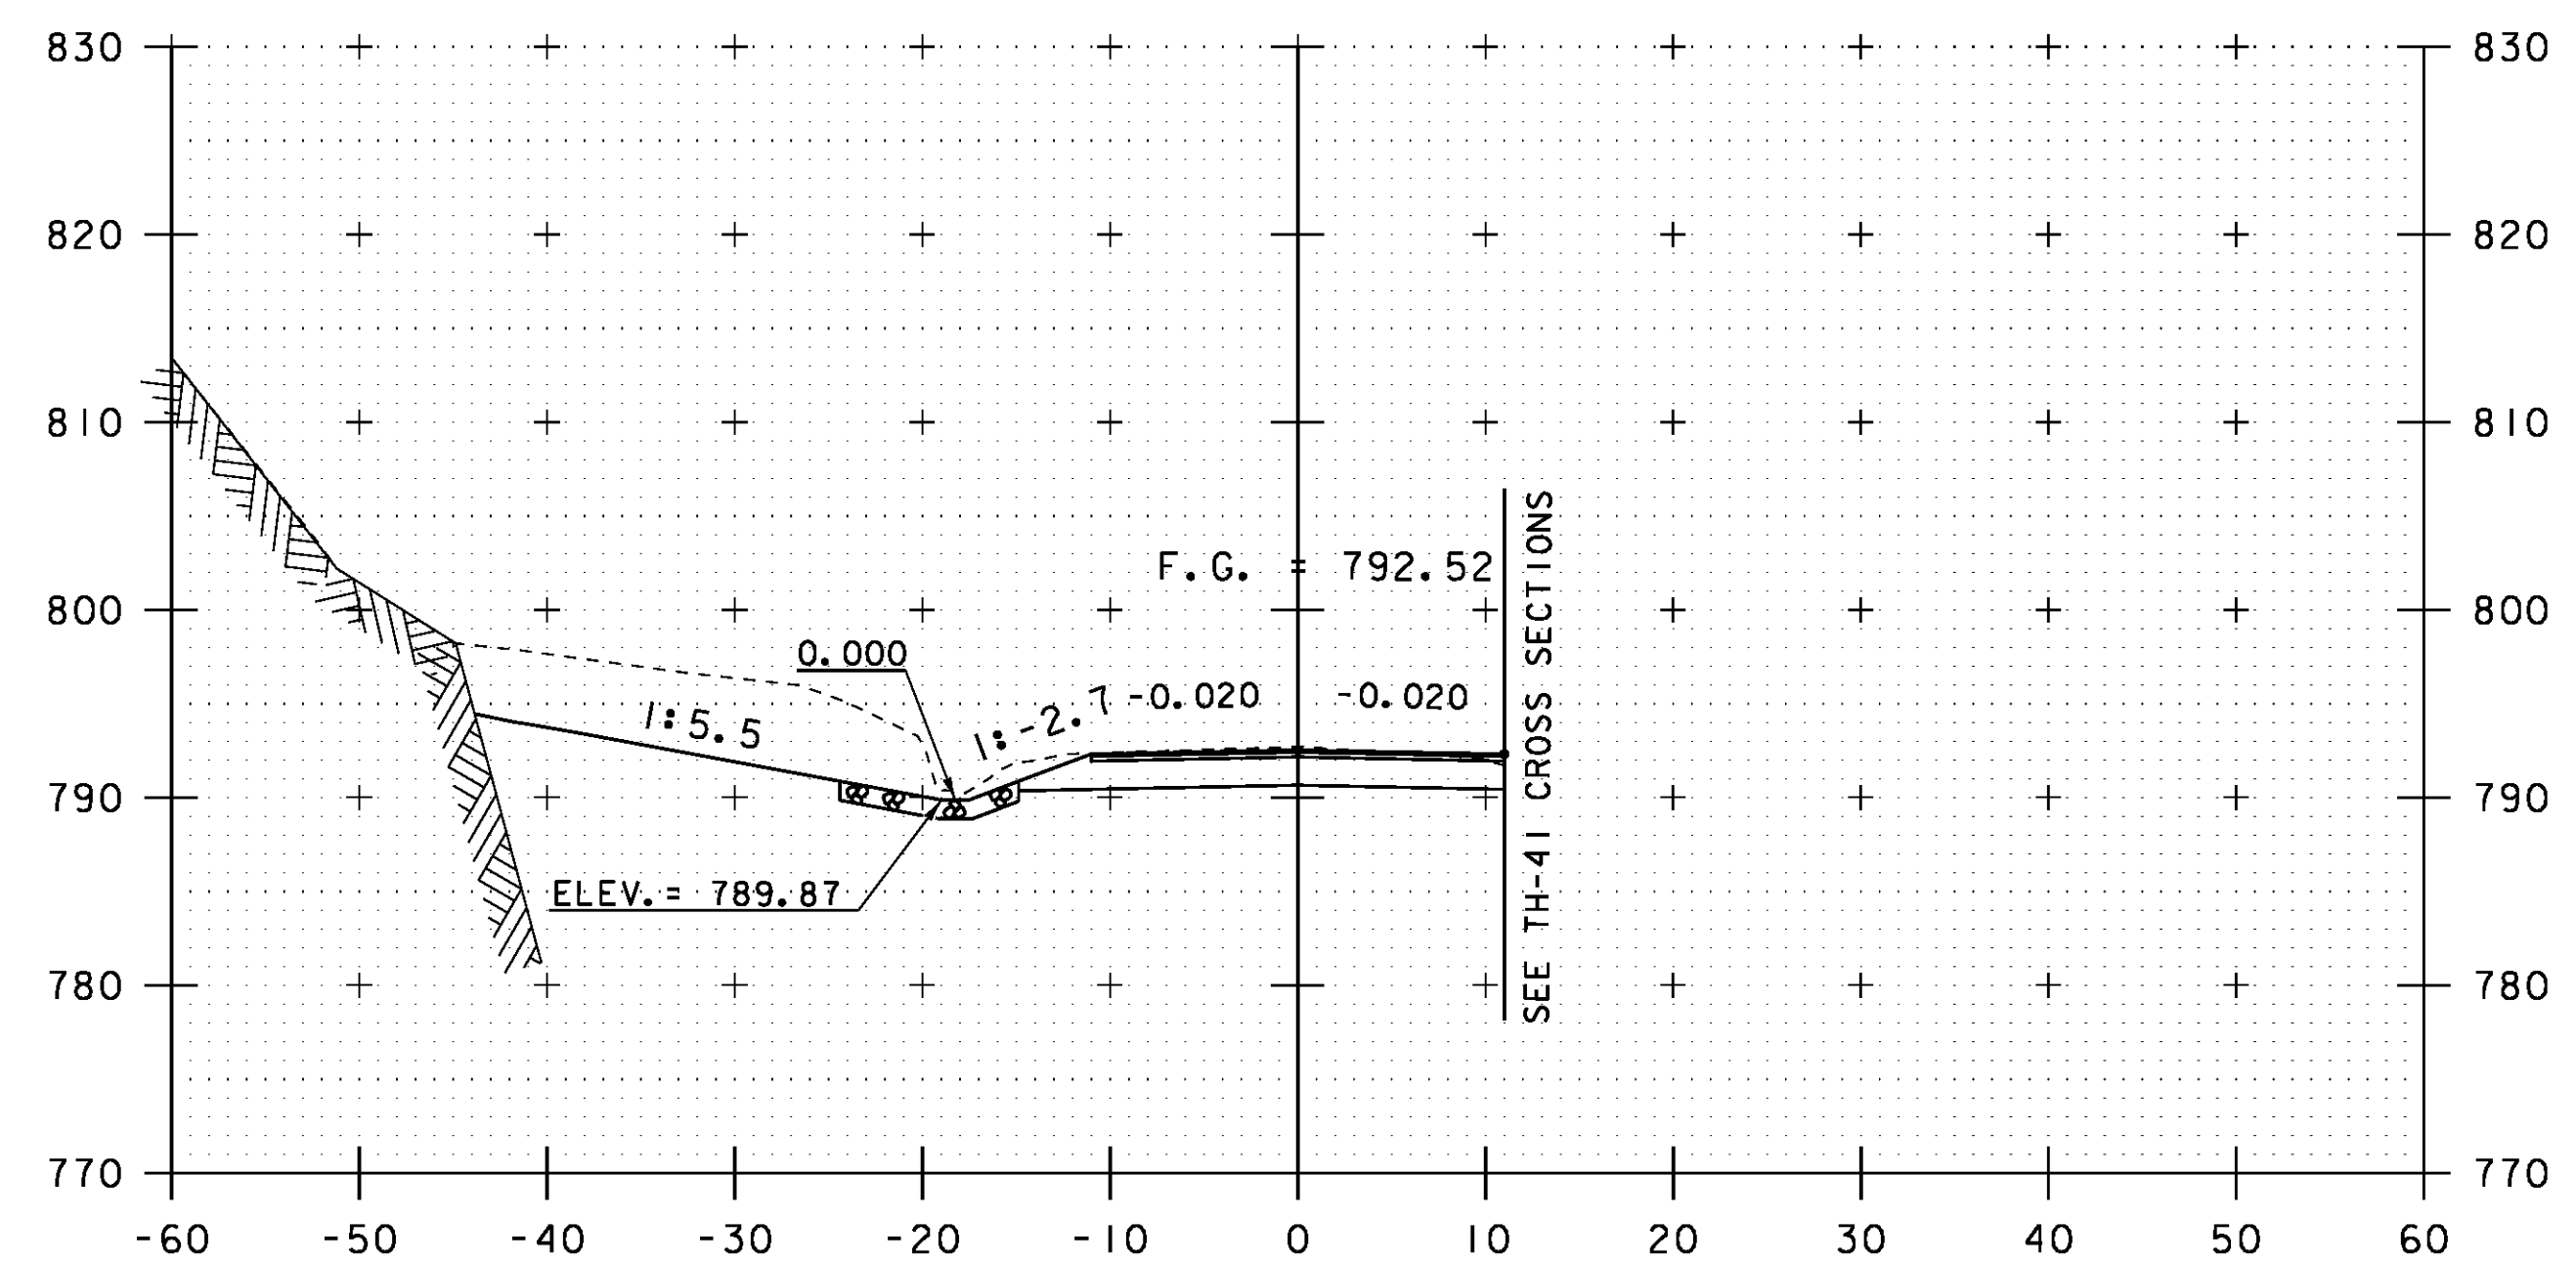

300+50

SCALE 1" = 10'-0"  
10 0 10

STA. 300+16 TO STA. 300+75

PROJECT NAME: WARREN  
PROJECT NUMBER: BRP 013-4(14)

FILE NAME: s78f242xs.dgn  
PROJECT LEADER: J. LACROIX  
DESIGNED BY: U. STANLEY  
TH 9 CROSS SECTION SHEET 1

PLOT DATE: 27-JUL-2012  
DRAWN BY: G. ROKES  
CHECKED BY: U. STANLEY  
SHEET 74 OF 83