


301+25

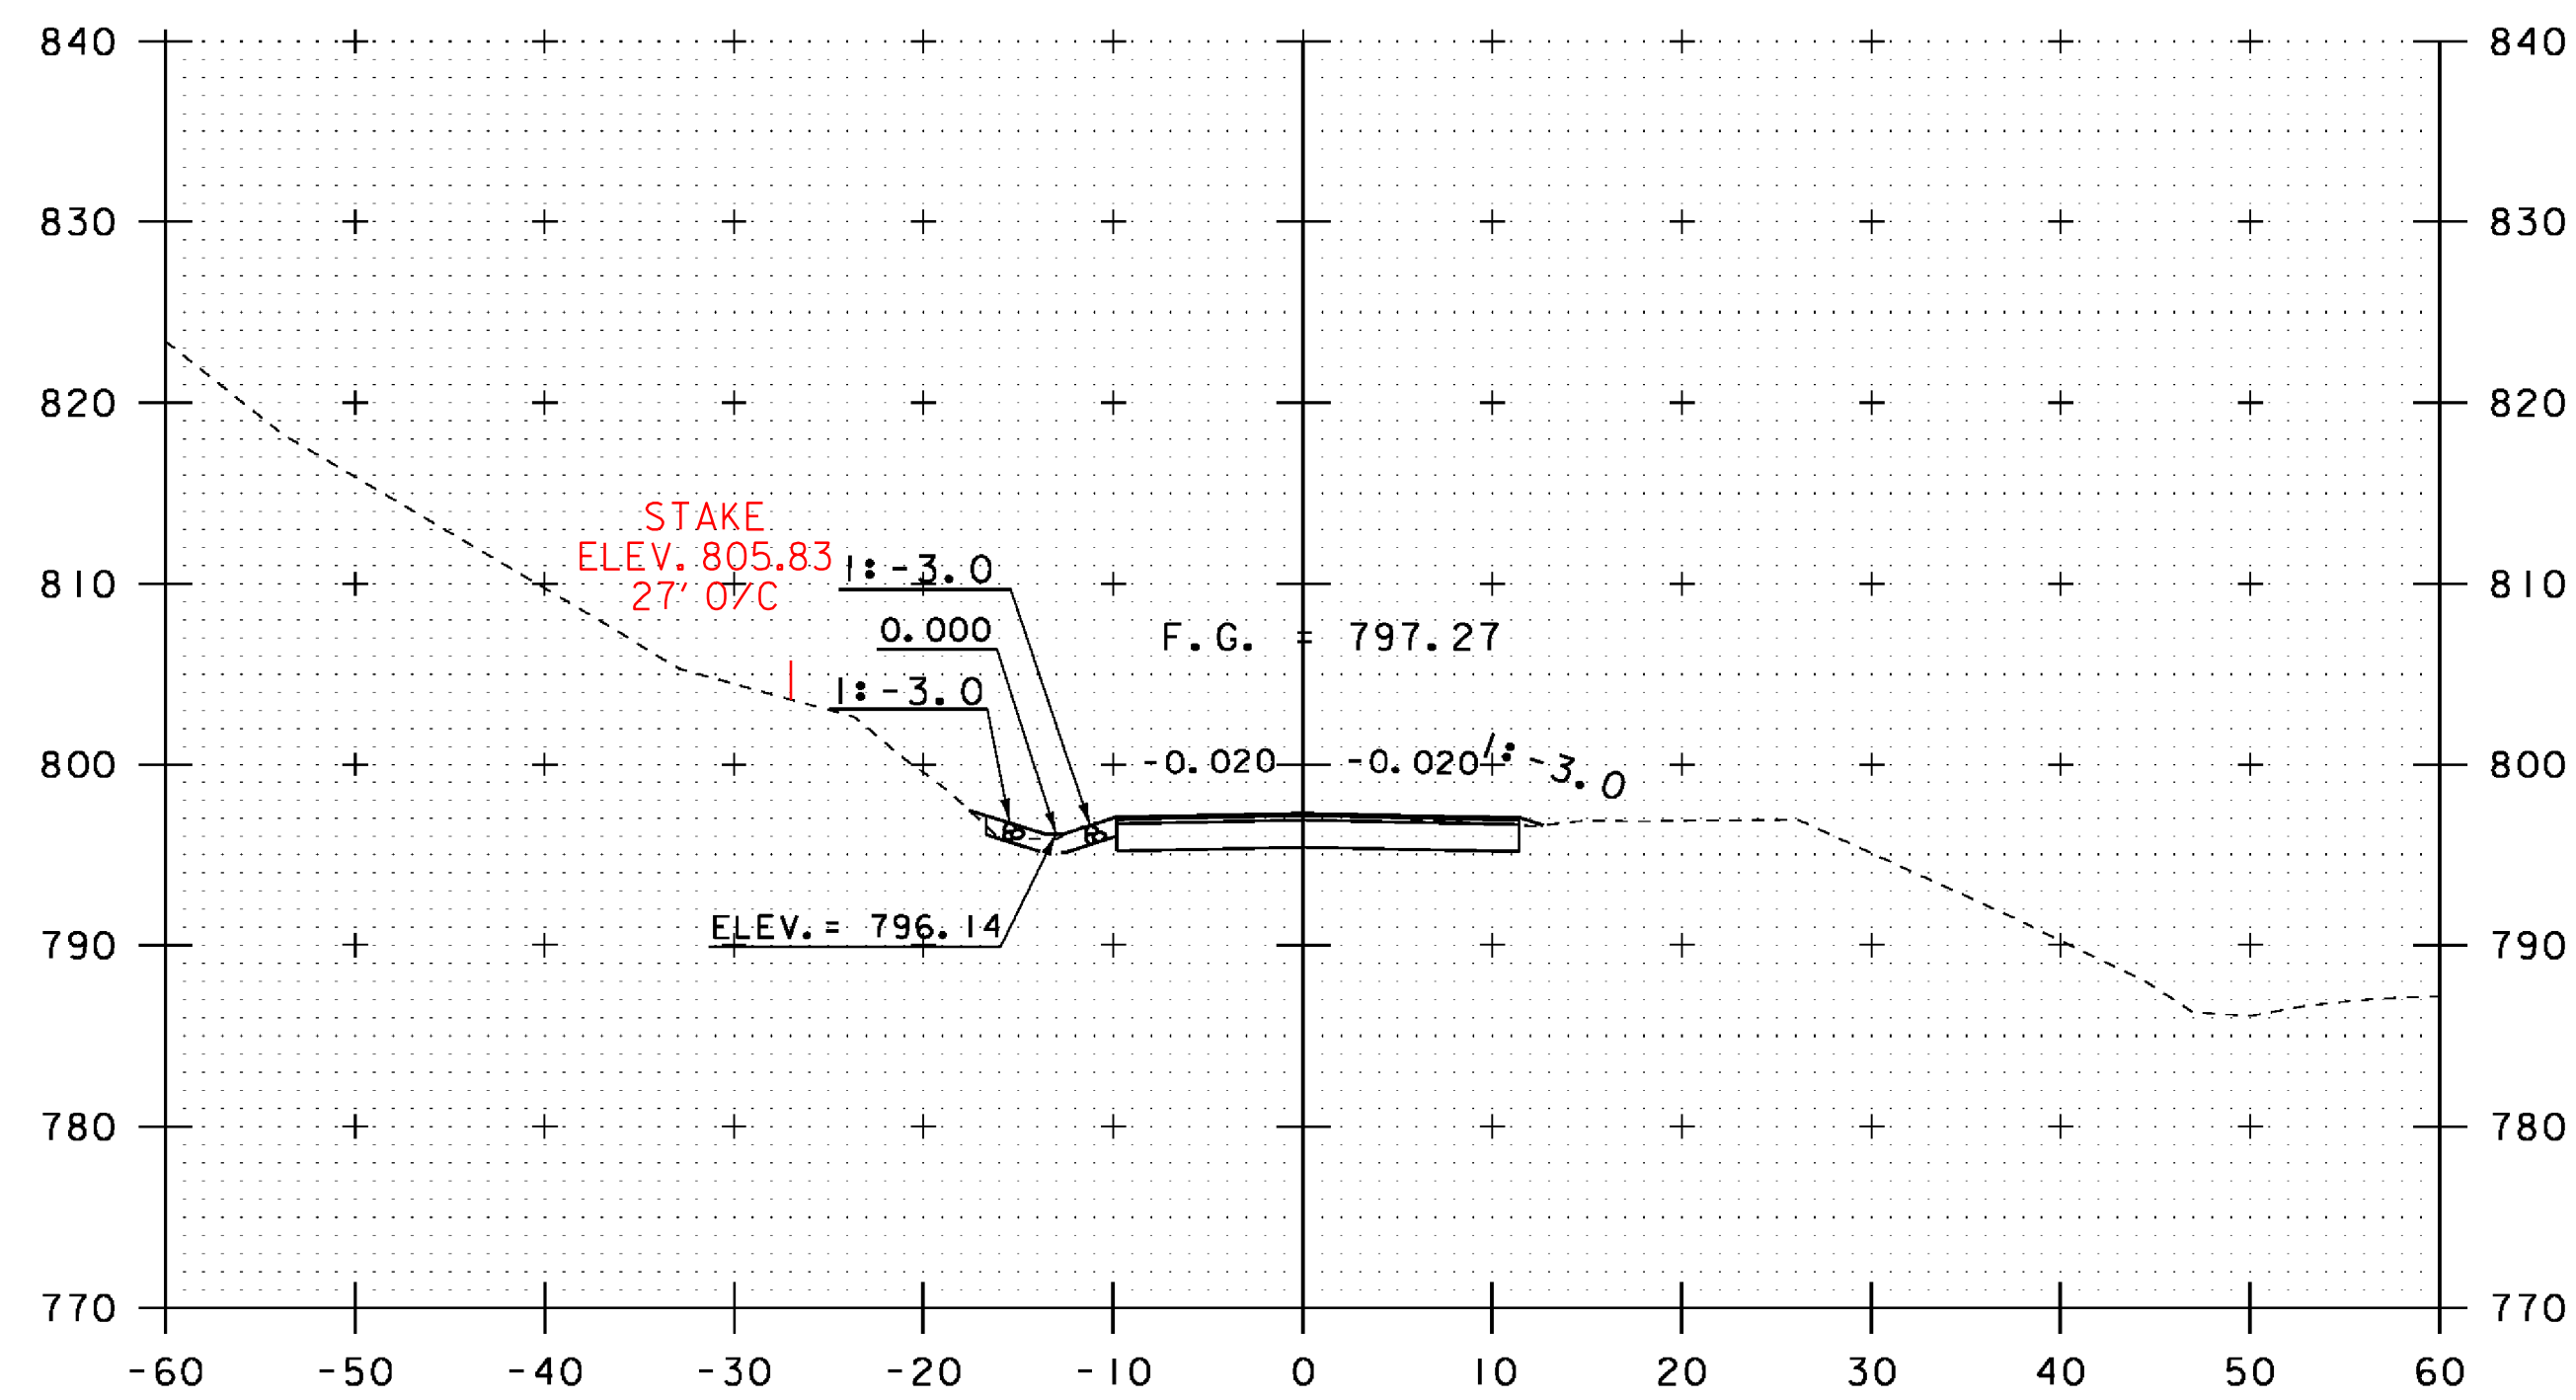

301+00

SCALE 1" = 10'-0"

STA. 301+00 TO STA. 300+25

PROJECT NAME: WARREN	PLOT DATE: 27-JUL-2012
PROJECT NUMBER: BRF 013-4(14)	DRAWN BY: G. ROKES
FILE NAME: s78f242xs.dgn	CHECKED BY: U. STANLEY
PROJECT LEADER: J. LACROIX	SHEET 75 OF 83
DESIGNED BY: U. STANLEY	
TH 9 CROSS SECTION SHEET 2	