




400+25

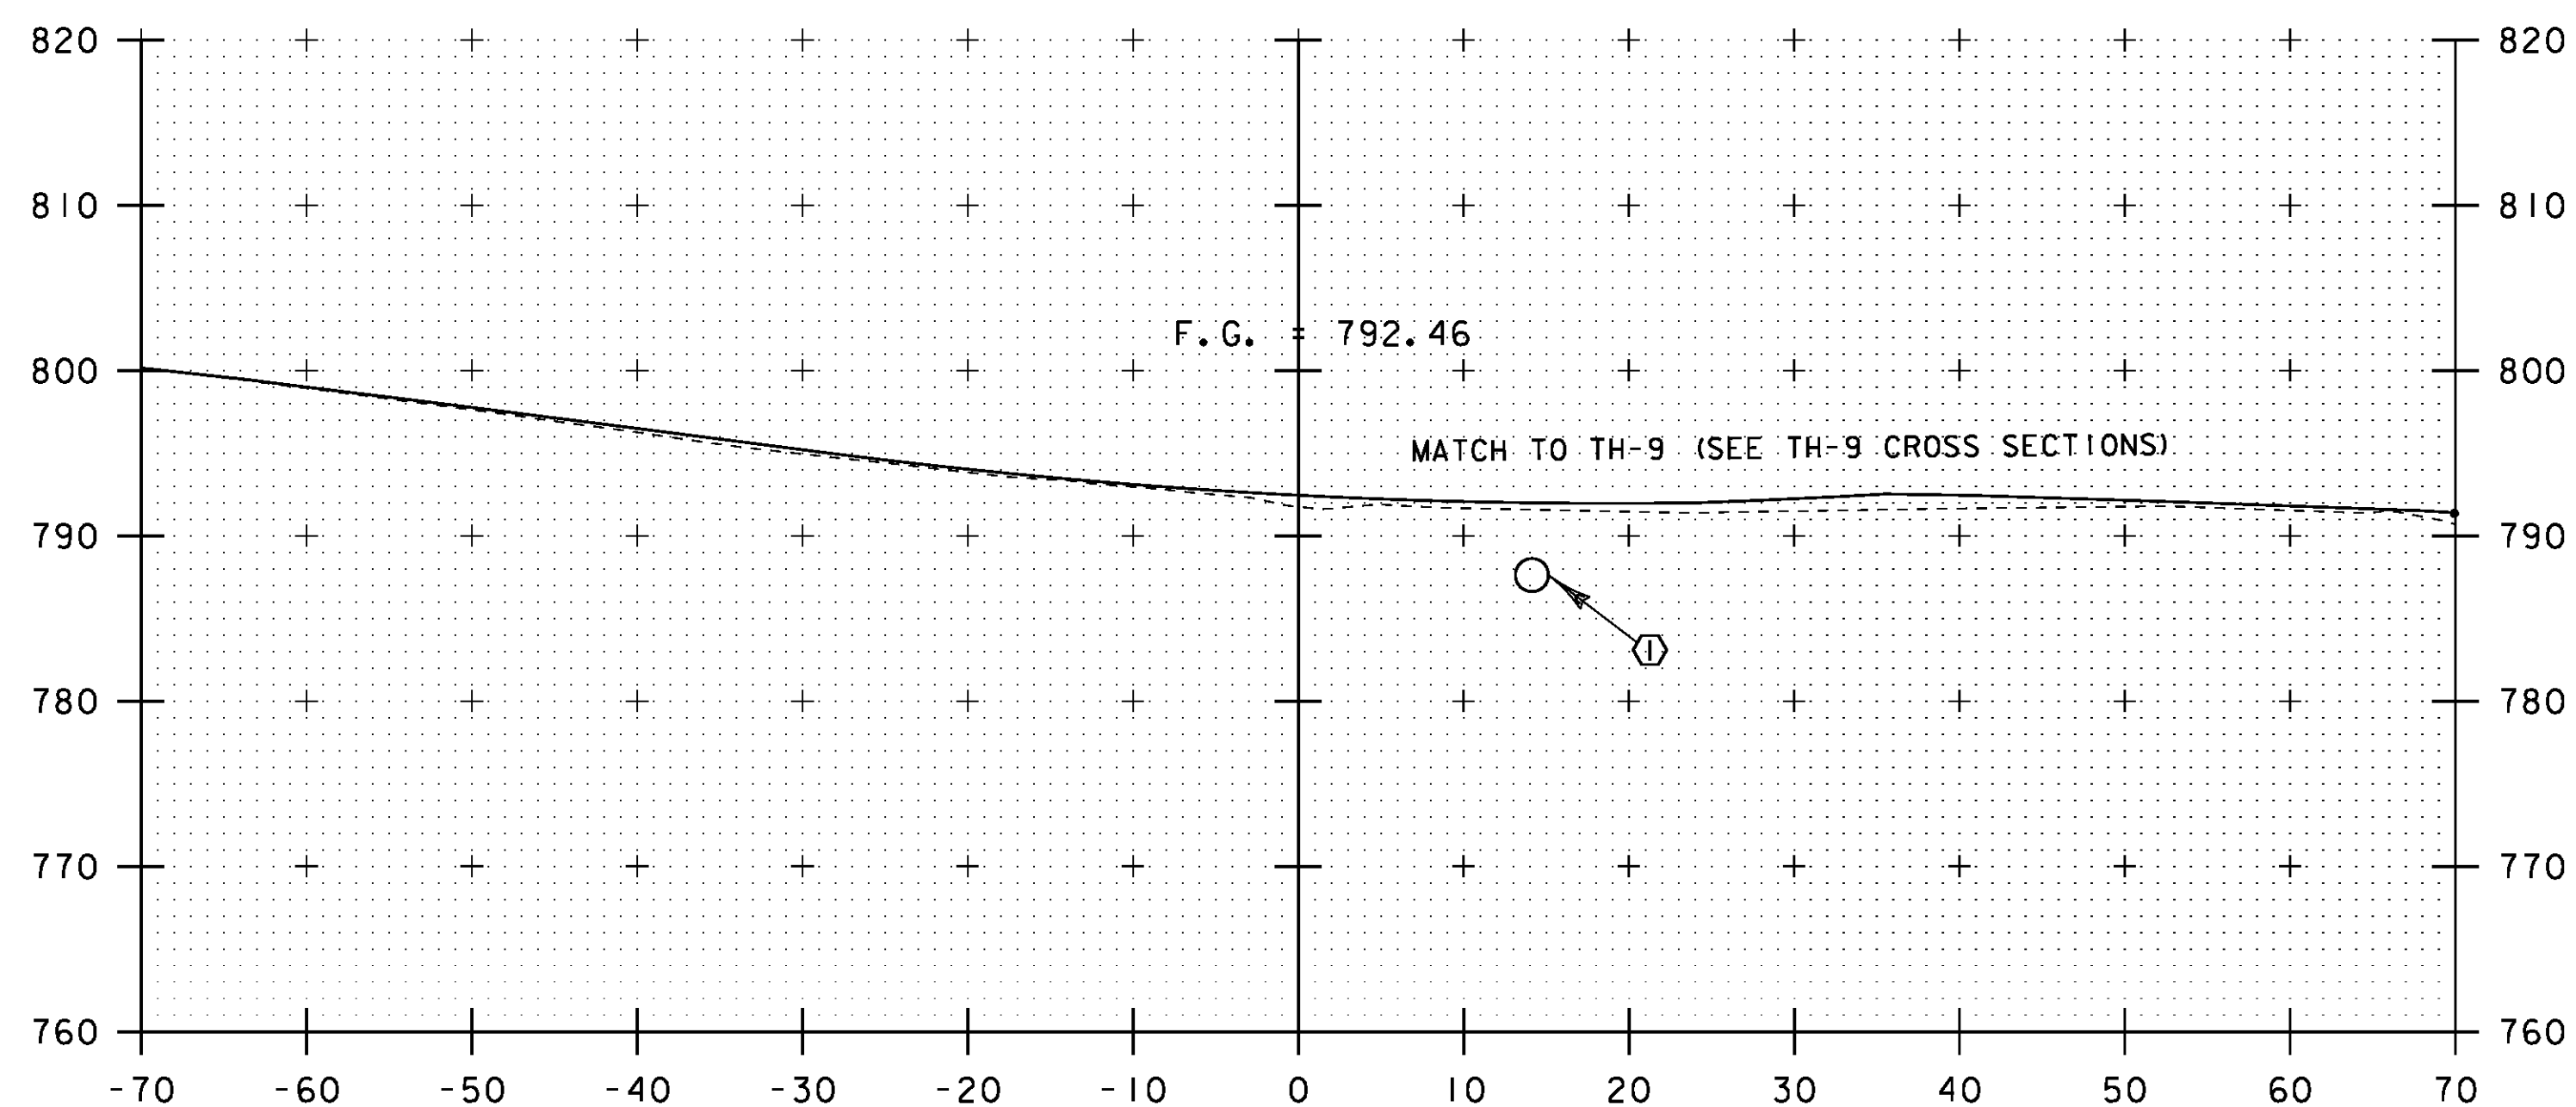


400+11

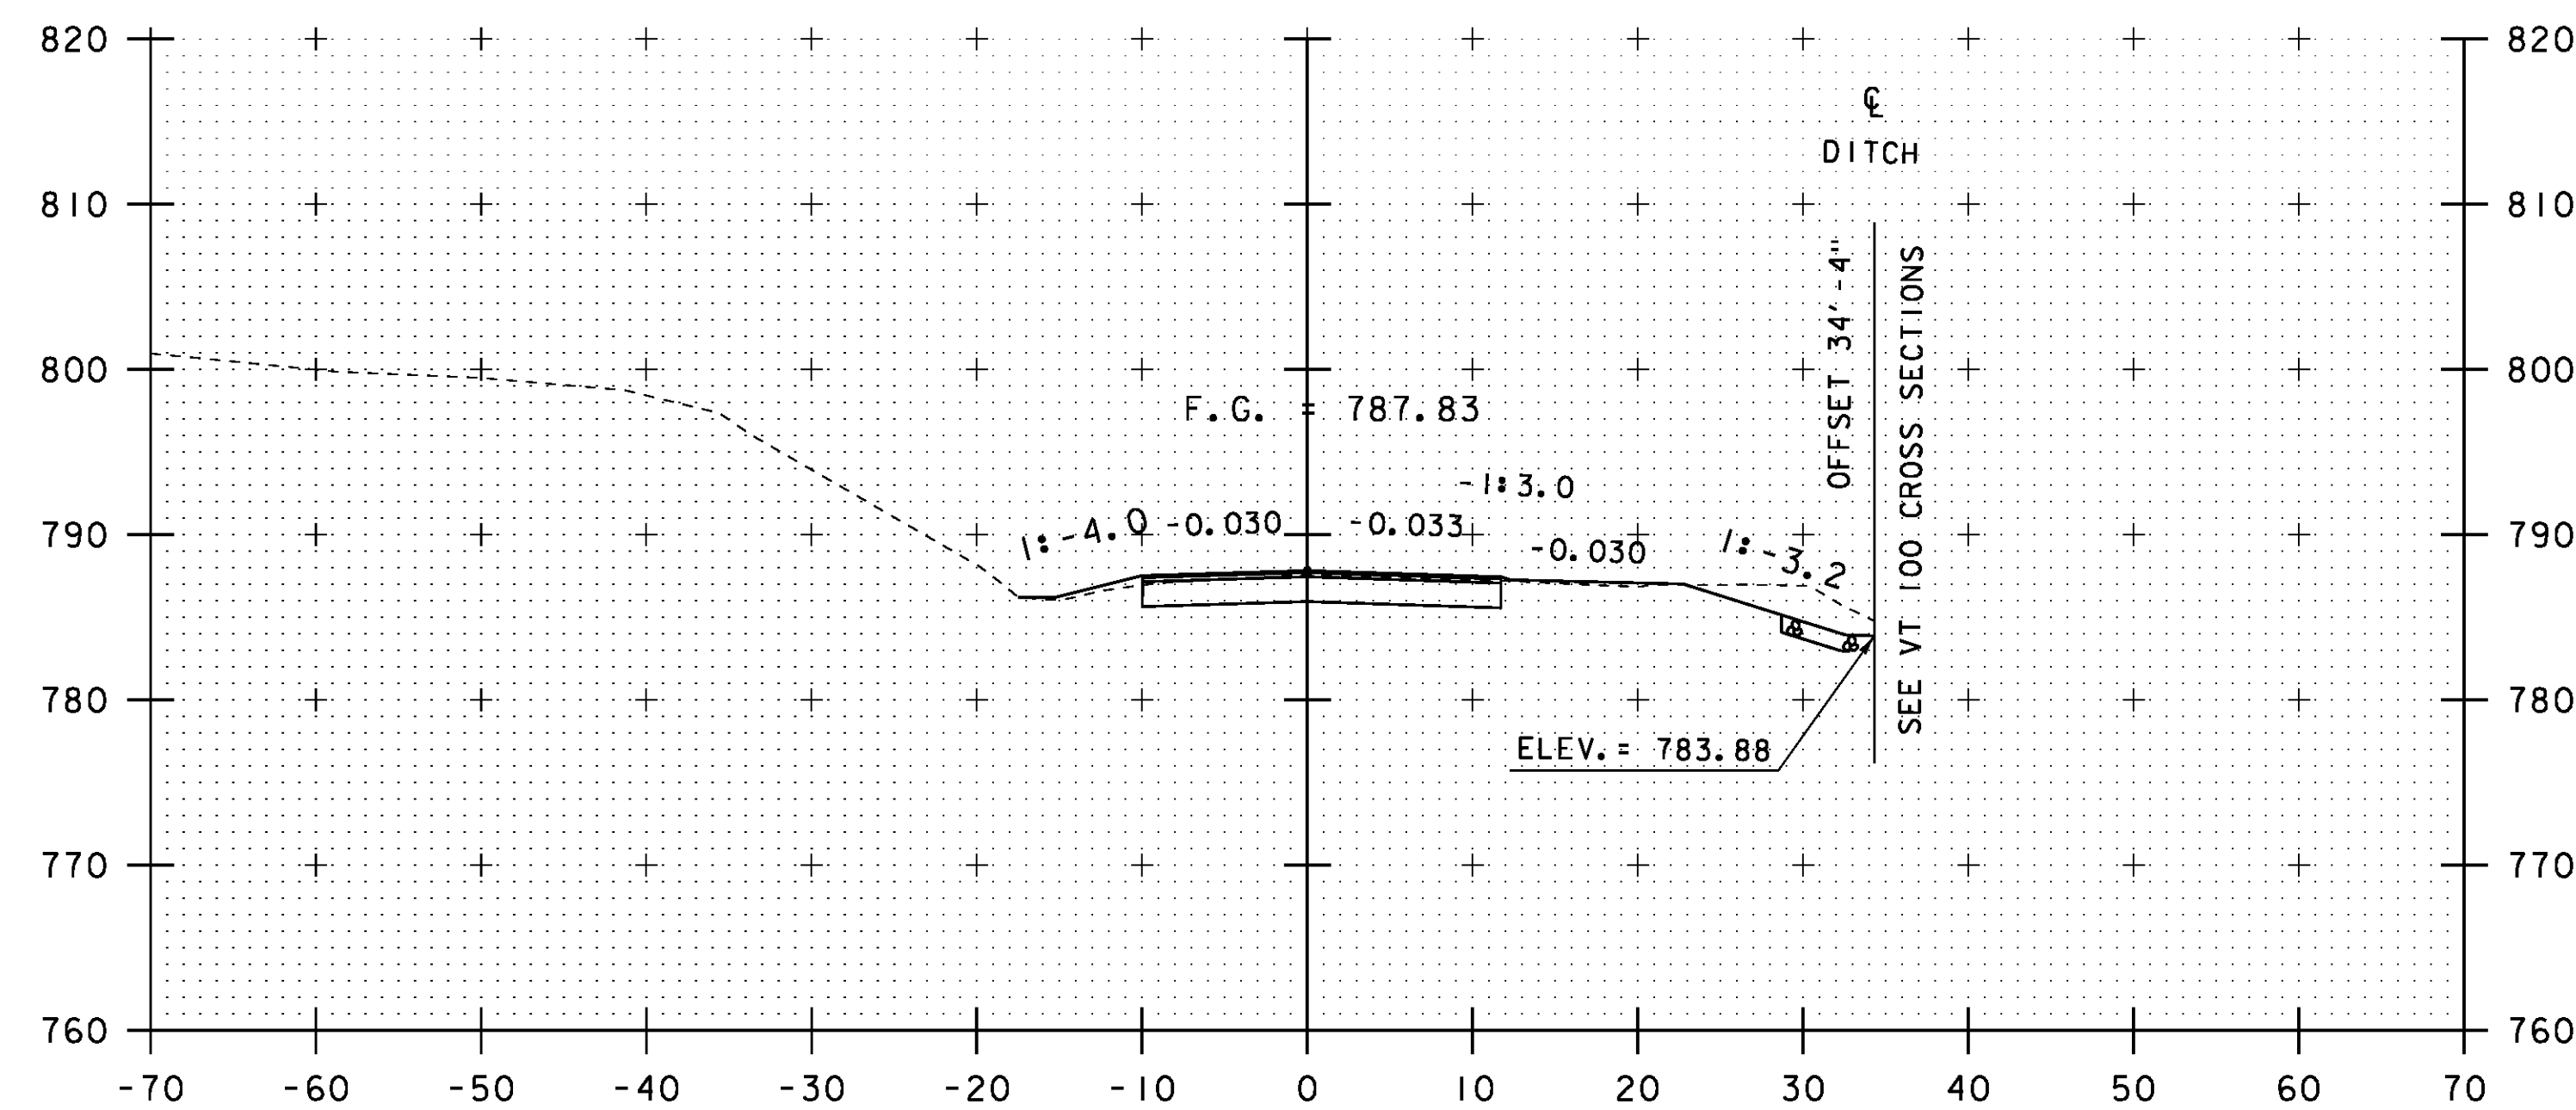

400+75

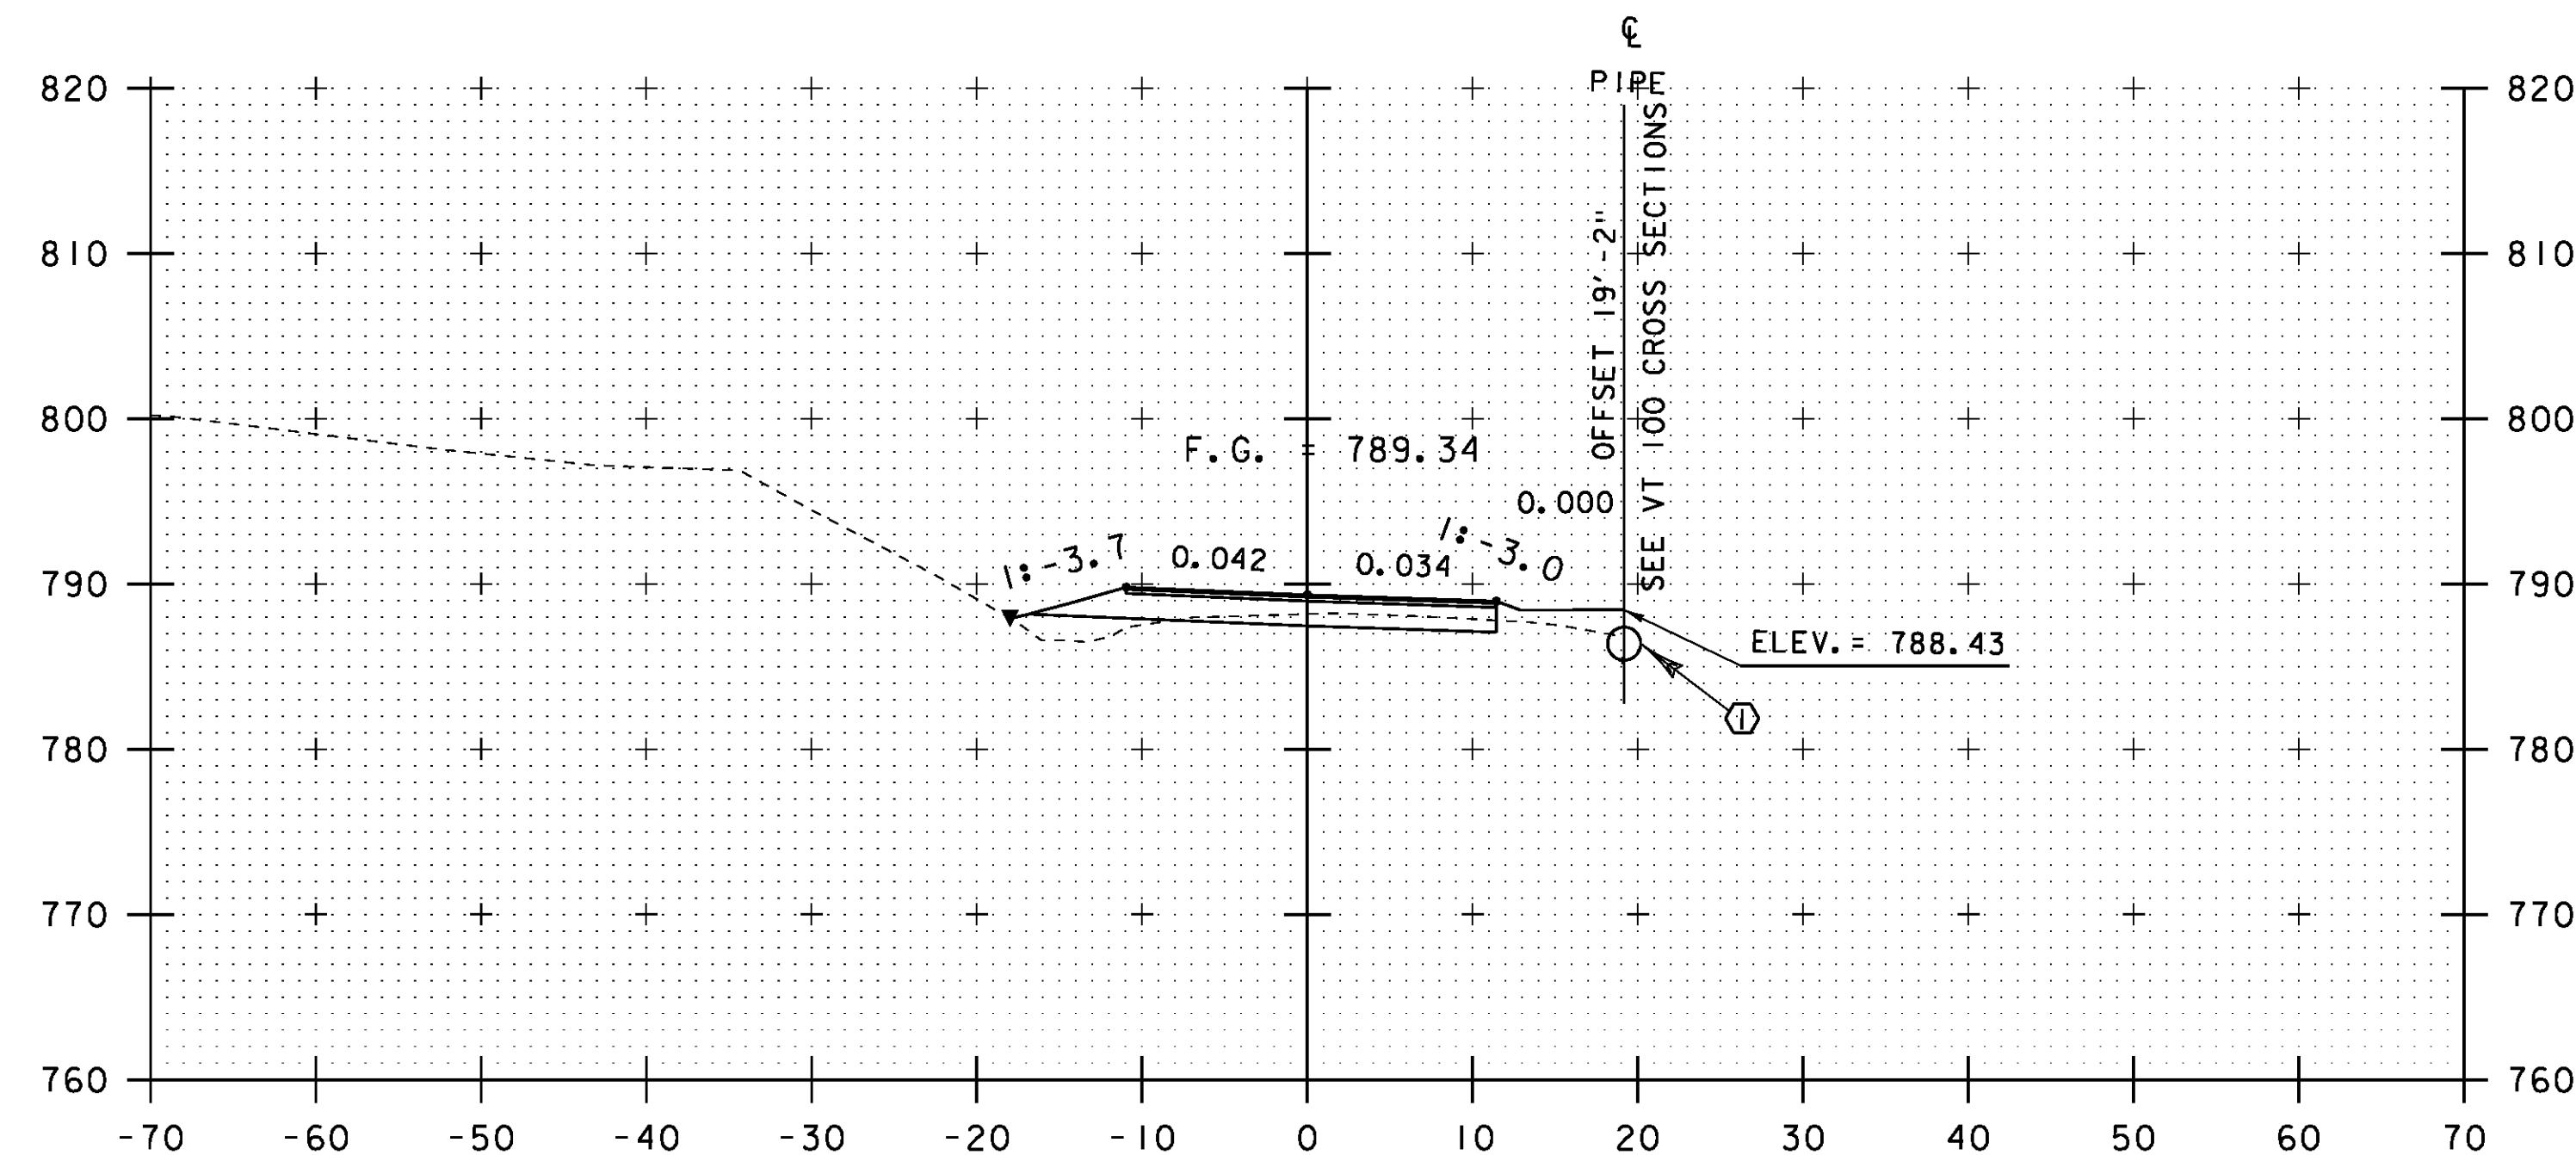

400+50

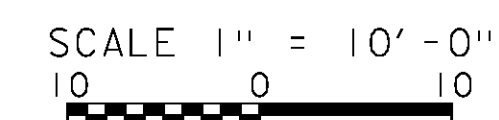

STA. 400+00 TO STA. 400+75

PROJECT NAME:	WARREN	PLOT DATE:	27-JUL-2012
PROJECT NUMBER:	BRF 013-4(14)	DRAWN BY:	G. ROKES
FILE NAME:	s78f242xs.dgn	CHECKED BY:	U. STANLEY
PROJECT LEADER:	J. LACROIX	SHEET	76 OF 83
DESIGNED BY:	U. STANLEY	TH 4/CROSS SECTION SHEET 1	