


603+75

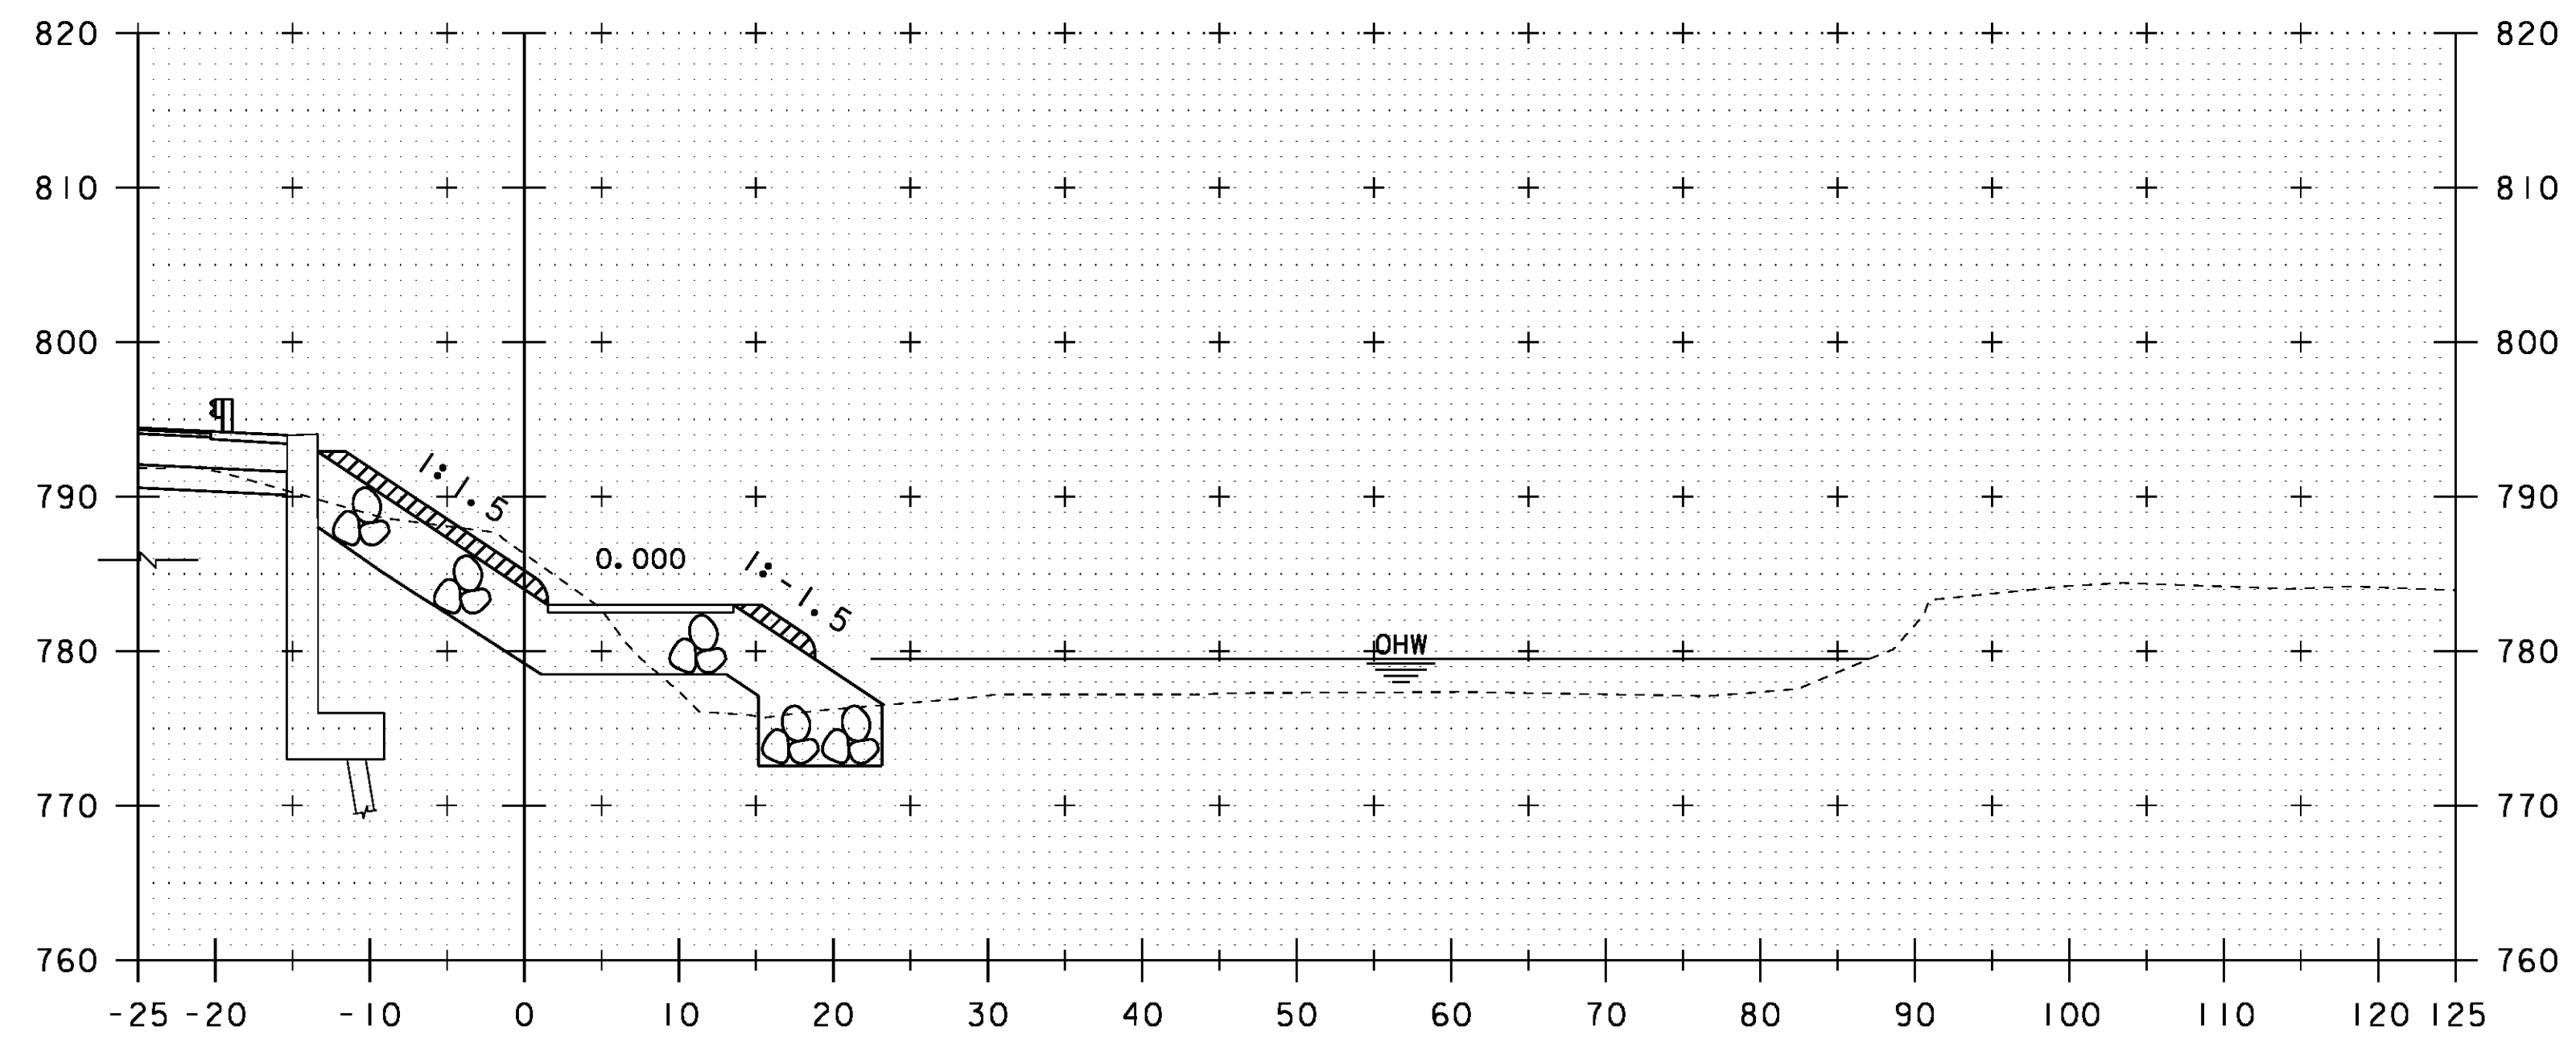

603+50

SCALE 1" = 10' - 0"  
 10 0 10

STA. 603+50 TO STA. 603+75

PROJECT NAME: WARREN	PLLOT DATE: 27-JUL-2012
PROJECT NUMBER: BRF 013-4(14)	DRAWN BY: G. ROKES
FILE NAME: s78f242xs.dgn	CHECKED BY: U. STANLEY
PROJECT LEADER: J. LACROIX	SHEET 79 OF 83
DESIGNED BY: U. STANLEY	
CHANNEL CROSS SECTION SHEET 2	