



604+25

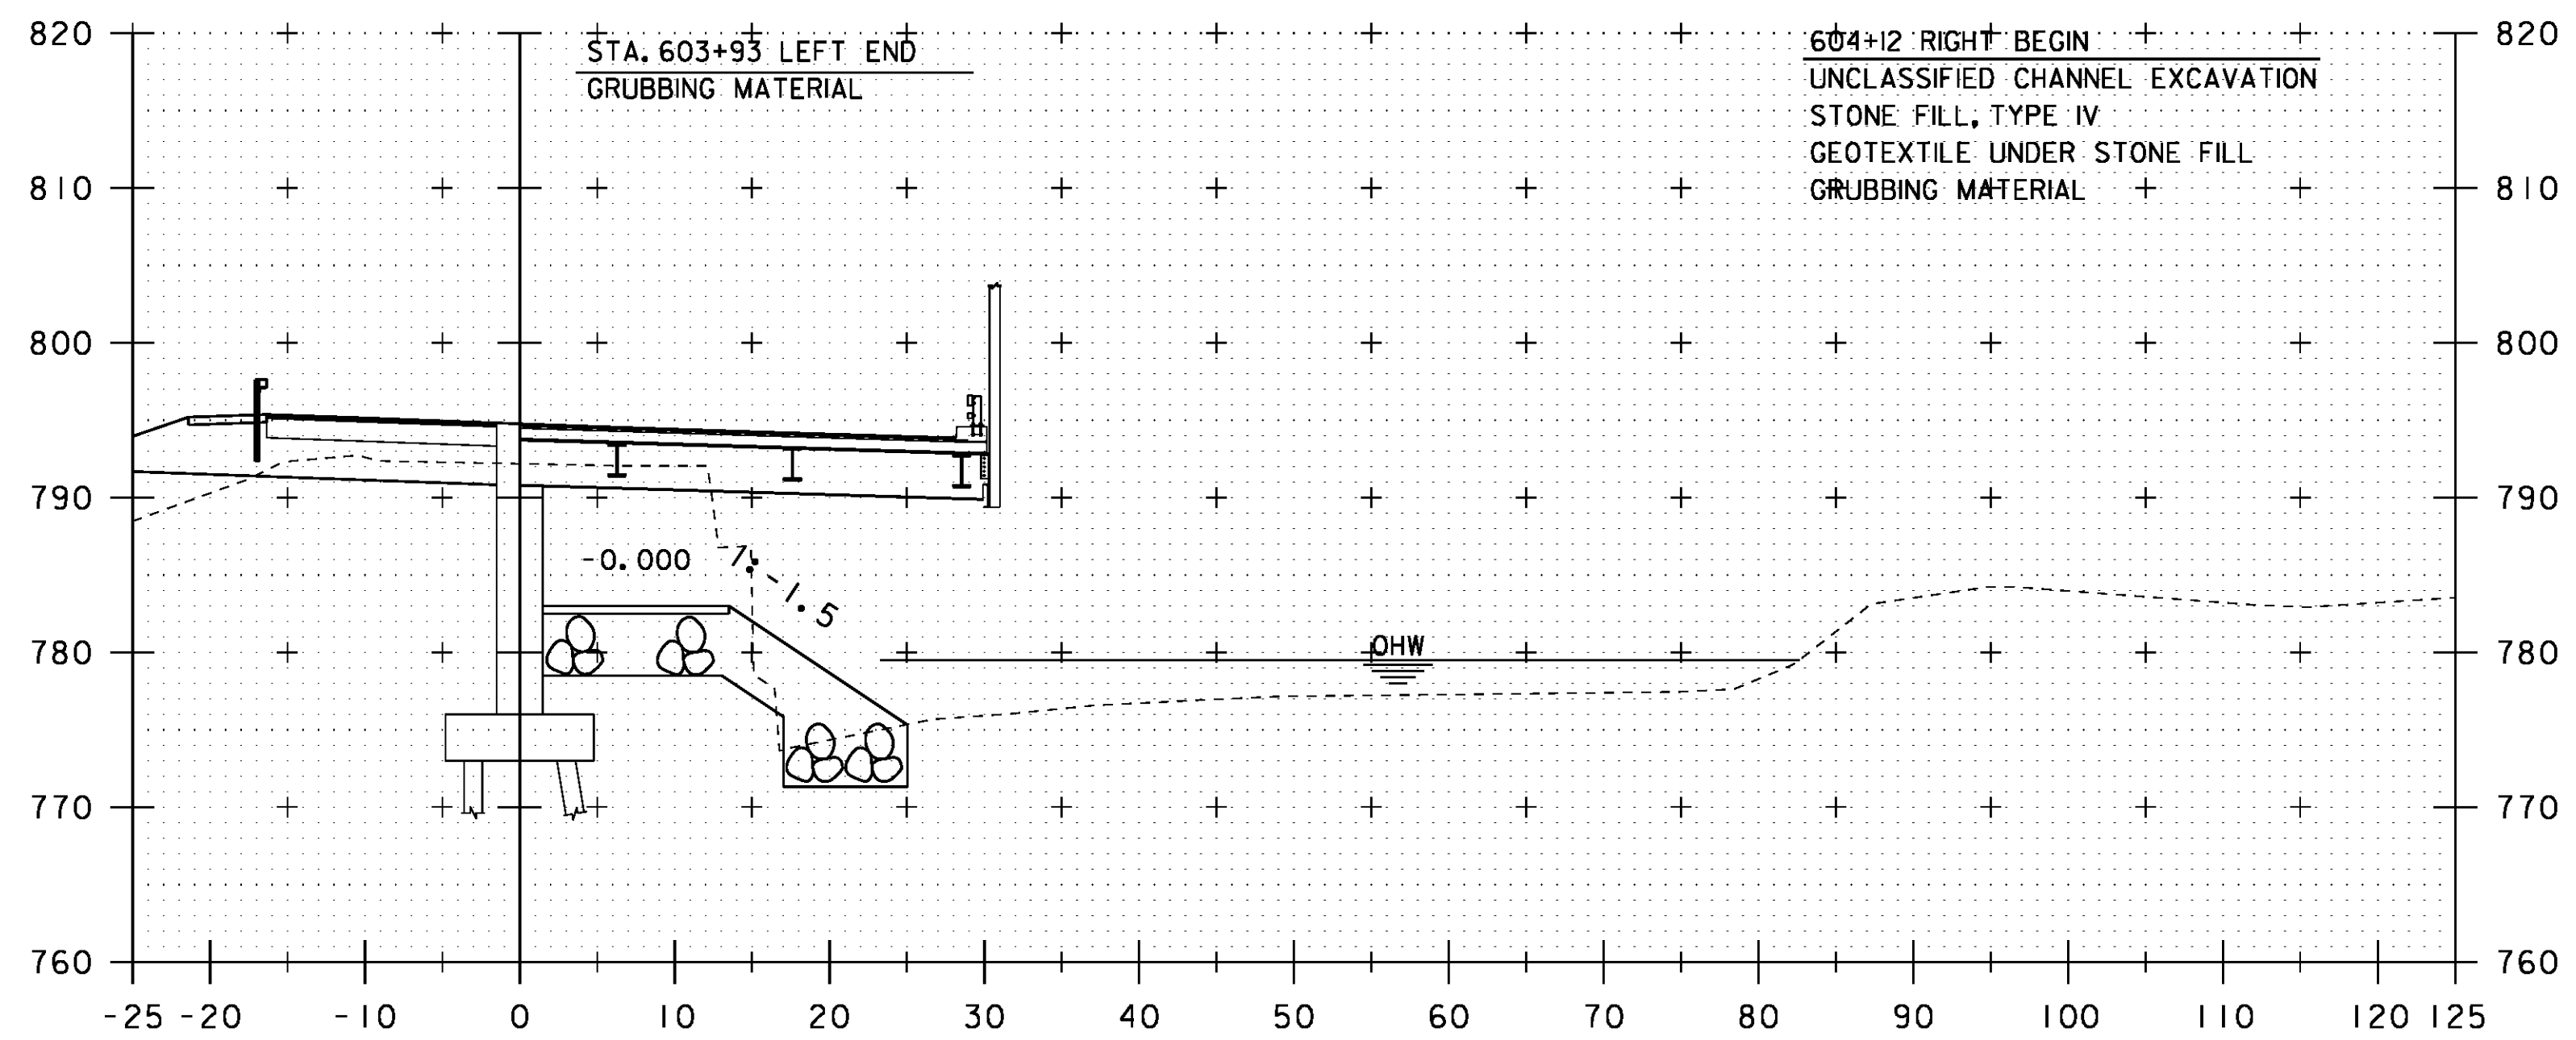

604+00

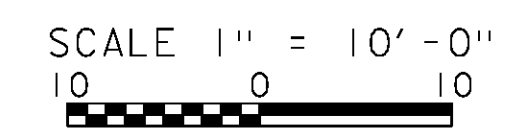

STA. 604+00 TO STA. 604+25

PROJECT NAME: WARREN	FILE NAME: s78f242xs.dgn	PLOT DATE: 27-JUL-2012
PROJECT NUMBER: BRF 013-4(14)	PROJECT LEADER: J. LACROIX	DRAWN BY: G. ROKES
	DESIGNED BY: U. STANLEY	CHECKED BY: U. STANLEY
	CHANNEL CROSS SECTION SHEET 3	SHEET 80 OF 83