


604+75

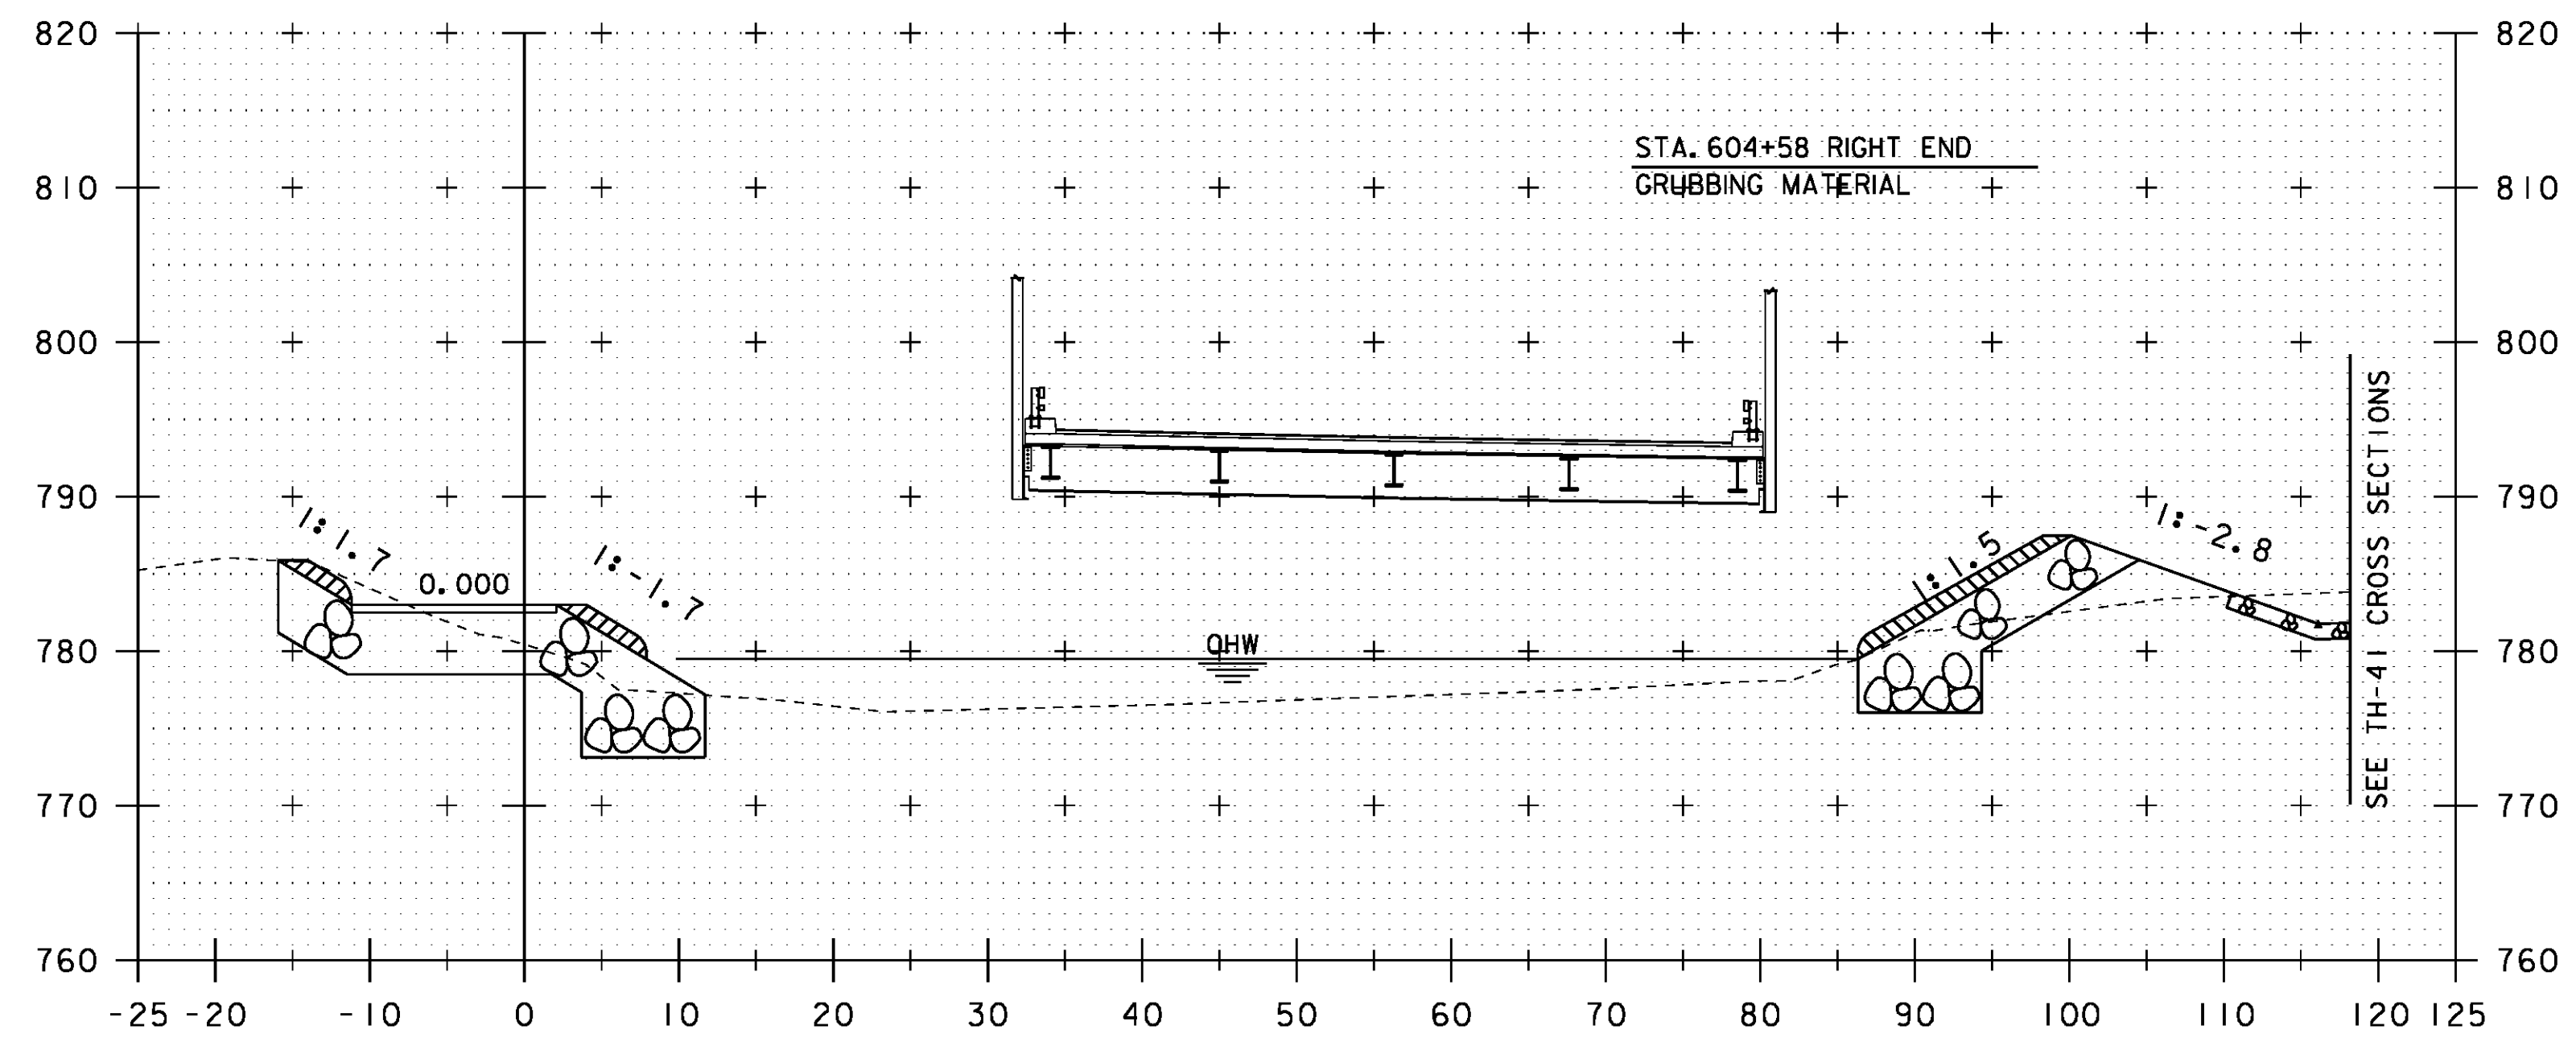

604+50

SCALE 1" = 10'-0"  
 10 0 10

STA. 604+50 TO STA. 604+75

PROJECT NAME: WARREN	PLLOT DATE: 27-JUL-2012
PROJECT NUMBER: BRF 013-4(14)	DRAWN BY: G. ROKES
FILE NAME: s78f242xs.dgn	CHECKED BY: U. STANLEY
PROJECT LEADER: J. LACROIX	SHEET 81 OF 83
DESIGNED BY: U. STANLEY	CHANNEL CROSS SECTION SHEET 4