


605+25

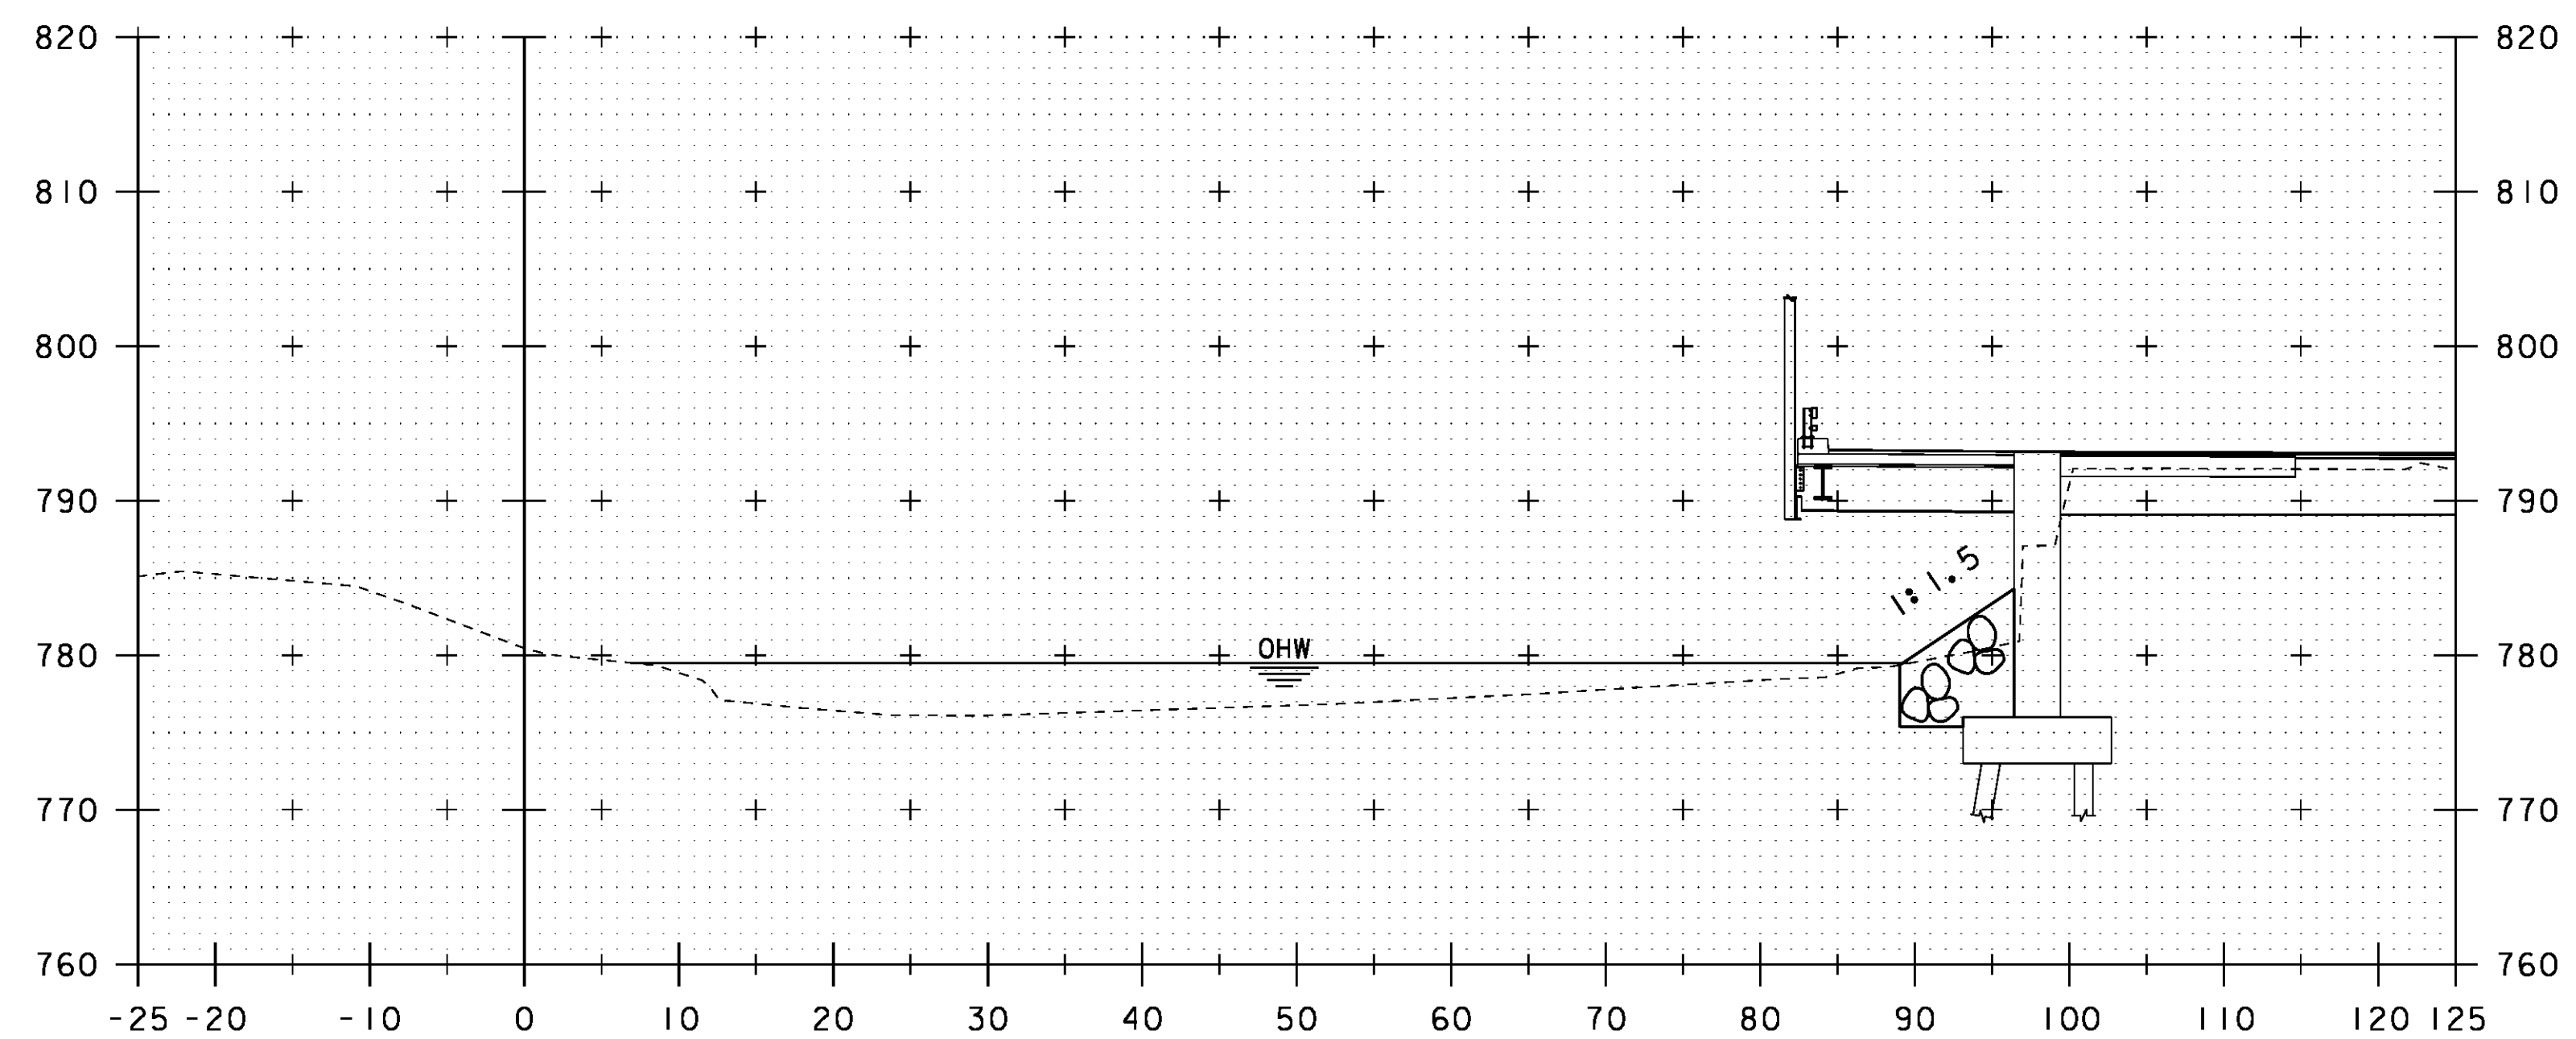

605+00

SCALE 1" = 10'-0"
 10 0 10

STA. 605+00 TO STA. 605+25

PROJECT NAME: WARREN	PLLOT DATE: 27-JUL-2012
PROJECT NUMBER: BRF 013-4(14)	DRAWN BY: G. ROKES
FILE NAME: s78f242xs.dgn	CHECKED BY: U. STANLEY
PROJECT LEADER: J. LACROIX	SHEET 82 OF 83
DESIGNED BY: U. STANLEY	CHANNEL CROSS SECTION SHEET 5