



DATE PLOTTED: June 24, 2013

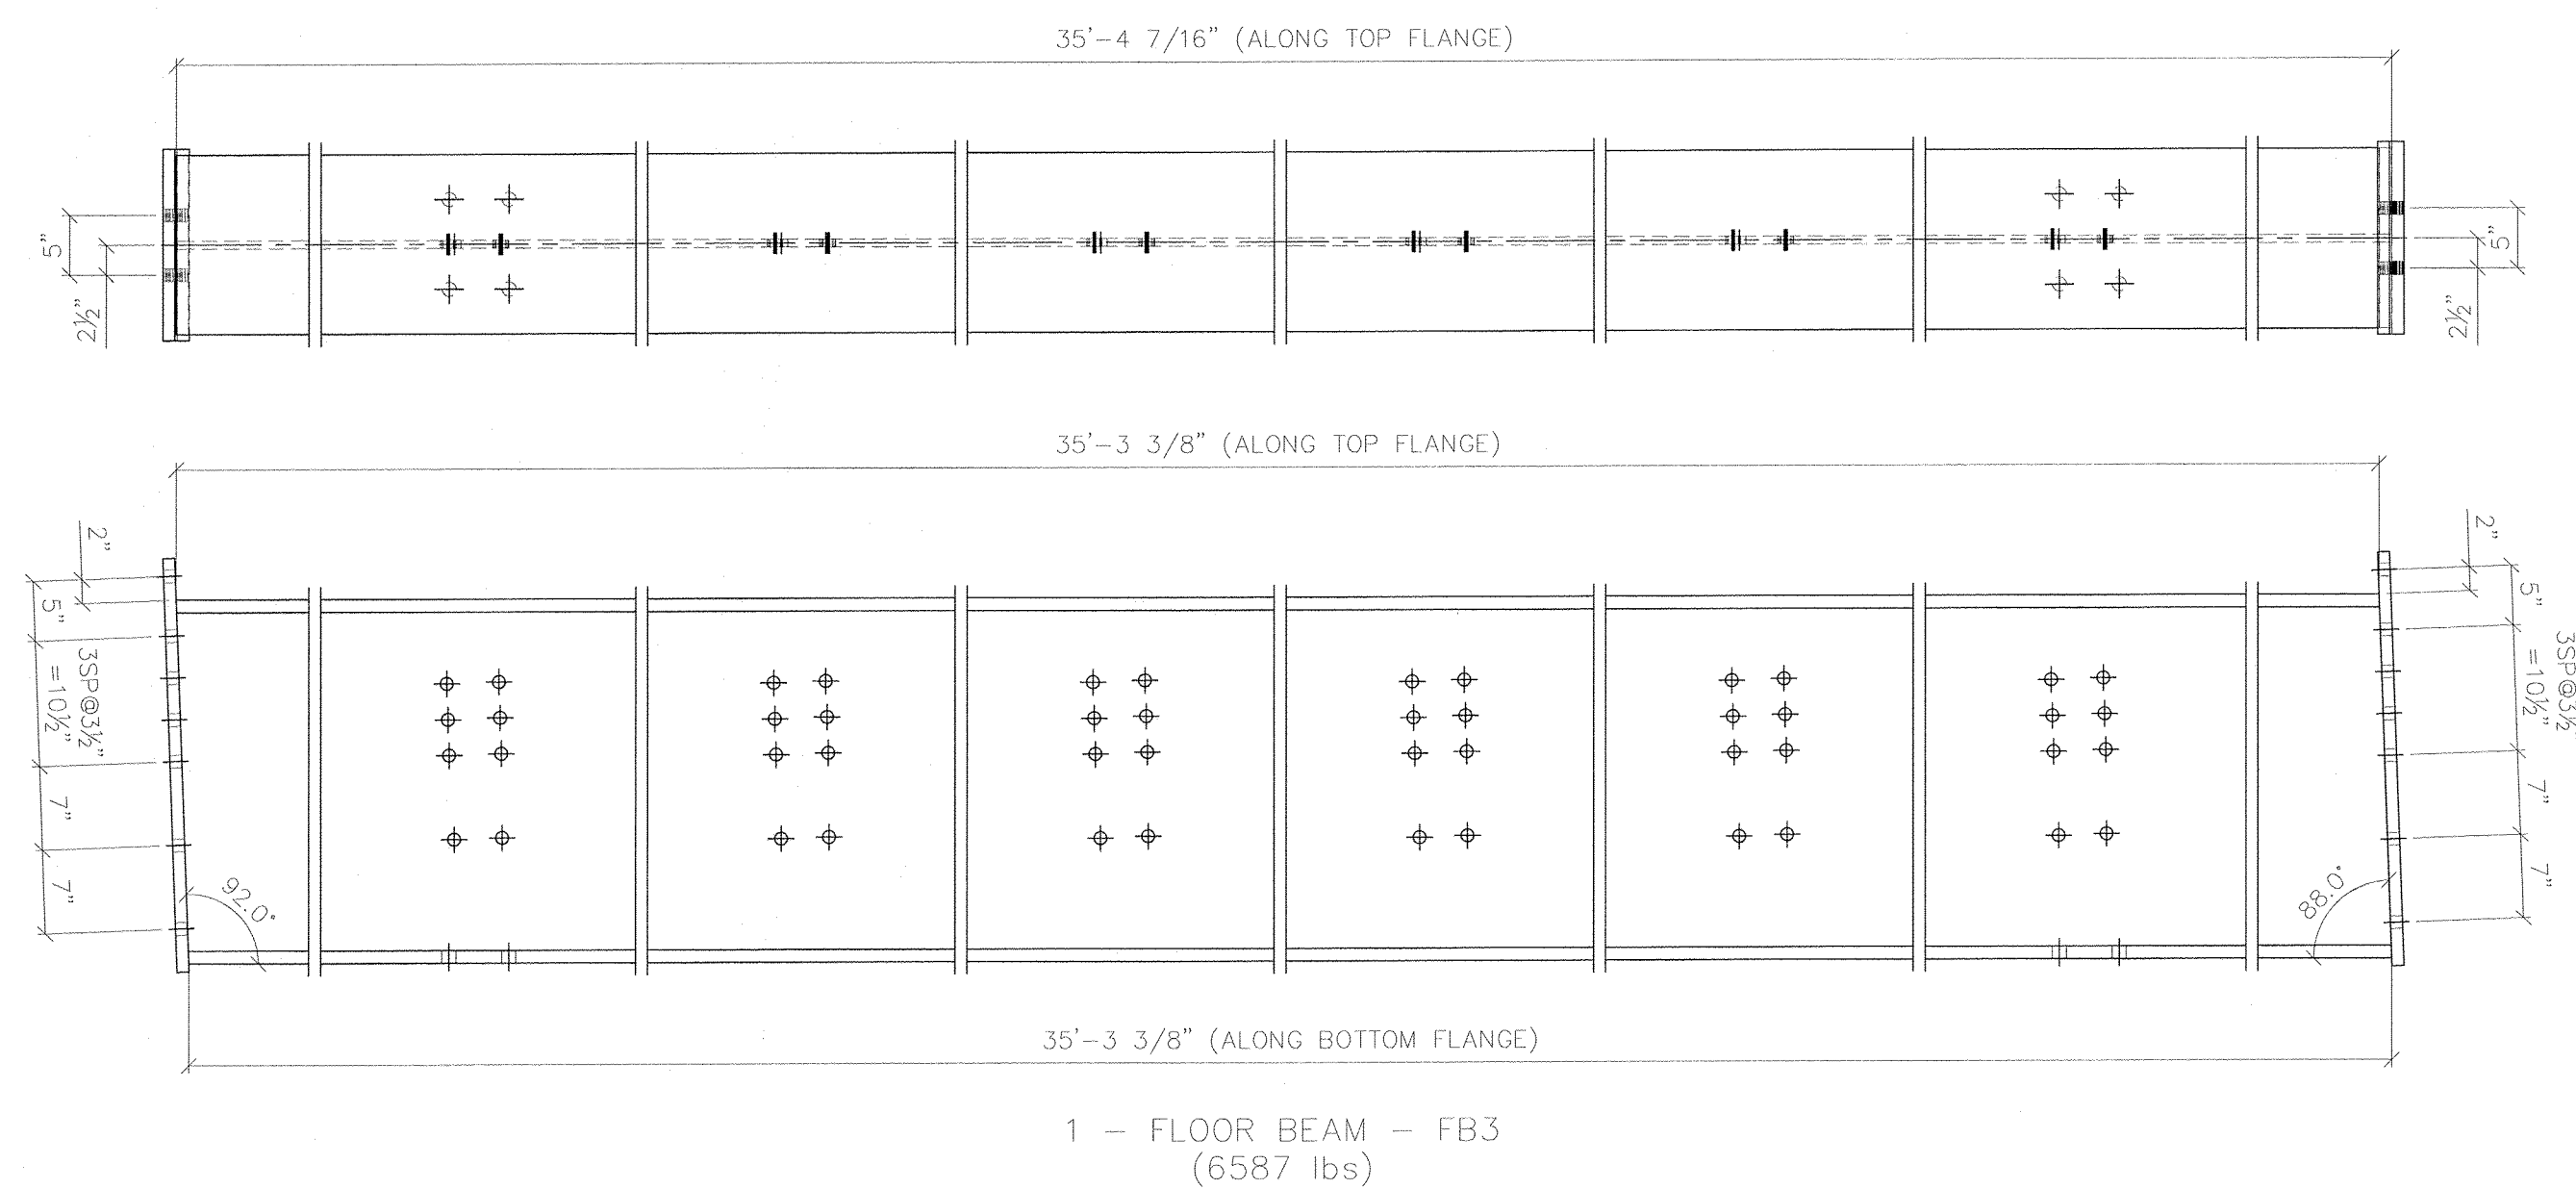

1 - FLOOR BEAM - FB3
(6587 lbs)

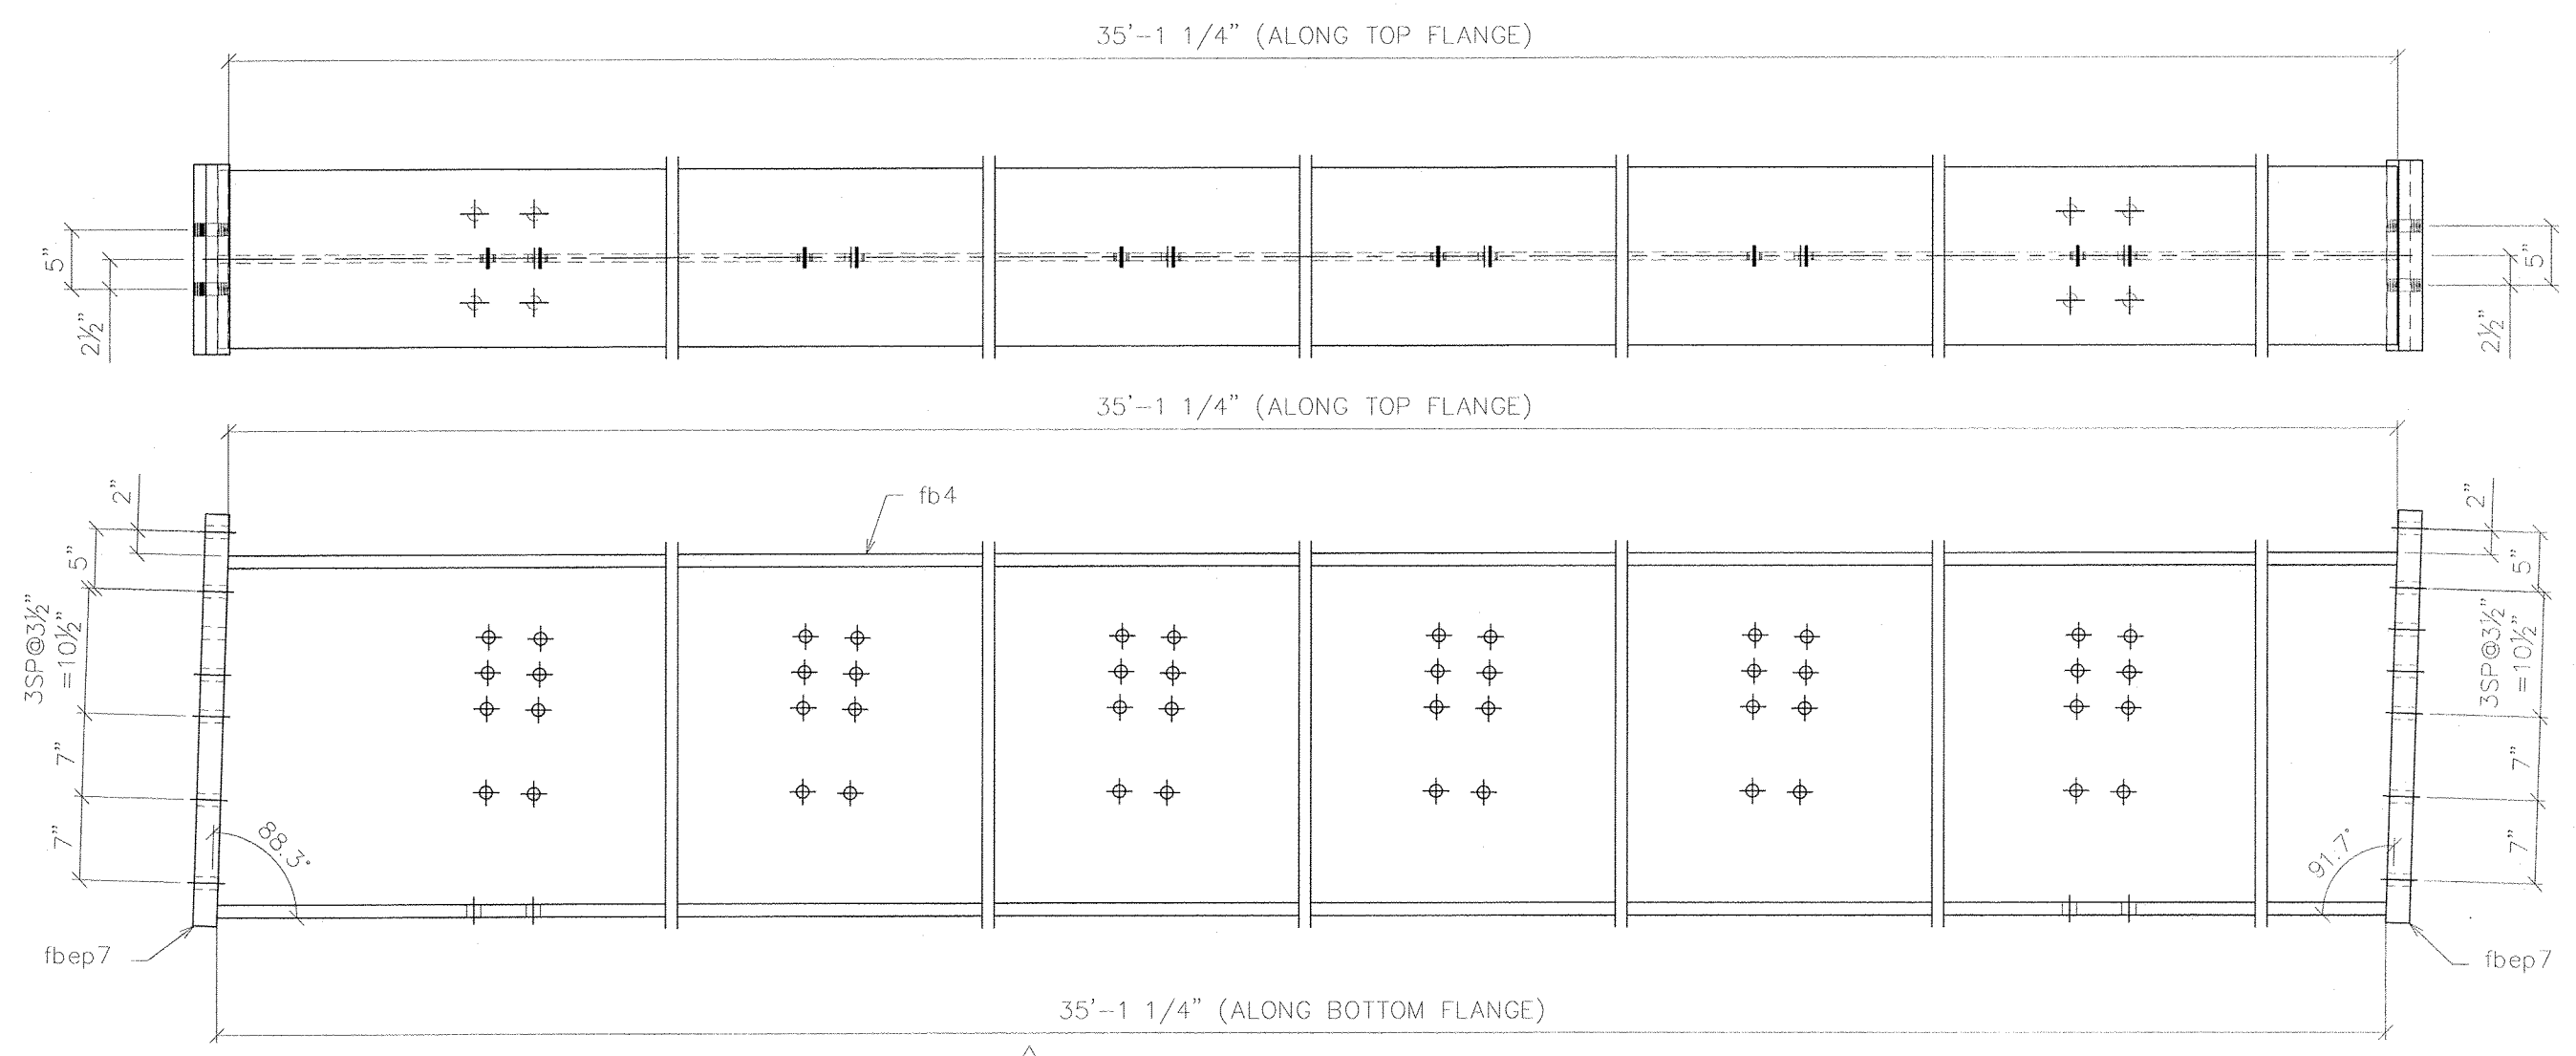

1 - FLOOR BEAM - FB4
(6586 lbs)

RECORD DWGS
AS FABRICATED
6/24/13

S:\05\VERMONT\1622-Gab\Tubes-1385 x 35\Warren_VT over Mt. River\Drawings\1622_AS-BUILT_6-24-13.dwg

SYMBOLS & ABBREVIATIONS

ES: EACH SIDE	NS: NEAR SIDE
EQ: EQUAL	FS: FAR SIDE
CL: CENTERLINE	WP: WORK POINT
CHK: CHECK	GA: GAUGE
REF: REFERENCE	ID: INSIDE DIAMETER
OD: OUT TO OUT	OD: OUTSIDE DIAMETER
CHK: CHECK	BRG: BEARING
C/C: CENTER TO CENTER	TYP: TYPICAL
F/F: FACE TO FACE	UNG: UNLESS NOTED OTHERWISE
Ø: DIAMETER	ABUT: ABUTMENT
R: RADIUS	T&B: TOP & BOTTOM

DIST. BY:
FAB. BY:



SUBMITTAL LOG	DATE	NO.	DATE	REVISIONS	BY
INITIAL SUBMITTAL	12/18/12	1	5/15/13	FLOOR BEAM END PLATES WAS 1" THK	TLB
RESUBMITTAL NO. 2	2/6/13	2	5/15/13	ADDED 2" DIA. RAT HOLES IN fb1 & fb9	TLB
CUSTOMER APPROVAL	2/13/13	3	5/15/13	CHANGED WELD WAS 3/8" ALL AROUND	TLB
SHOP REVIEW	-	4	5/15/13	CHANGED BOLT PATTERN	TLB
PRE FAB MTG	-	5	5/15/13	WAS 2" EDGE DISTANCE	TLB
APPROVED FOR FAB	2/28/13	6	6/3/13	DIMENSIONAL ERRORS	TLB

00000001.jpg

TOWN OF WARREN, VT
COUNTY OF WASHINGTON
BRIDGE NO.173 REPLACEMENT
WARREN, VT

ITEM NO.:
PROJECT NO.: BRF 013-4 (14)
REFERENCE NO.:
BRIDGE NO.: 173
STRUCTURAL FILE NO.:

DESIGN: SAF	DRAW: TLB	REVIEW: SAF/RLI	CHECK: CJG	DATE: 6/24/13
SHOP DETAILS		SHOP ASSEMBLY		JOB# 8a
			USB JOB# 51622	58