


DATE PLOTTED June 24, 2013

S:\05\INVENTORY\1622-dwg\Tues-1385 x 35-Warren,VT over Mad River\Drawings\1622 AS-BUILT 6-24-13.dwg

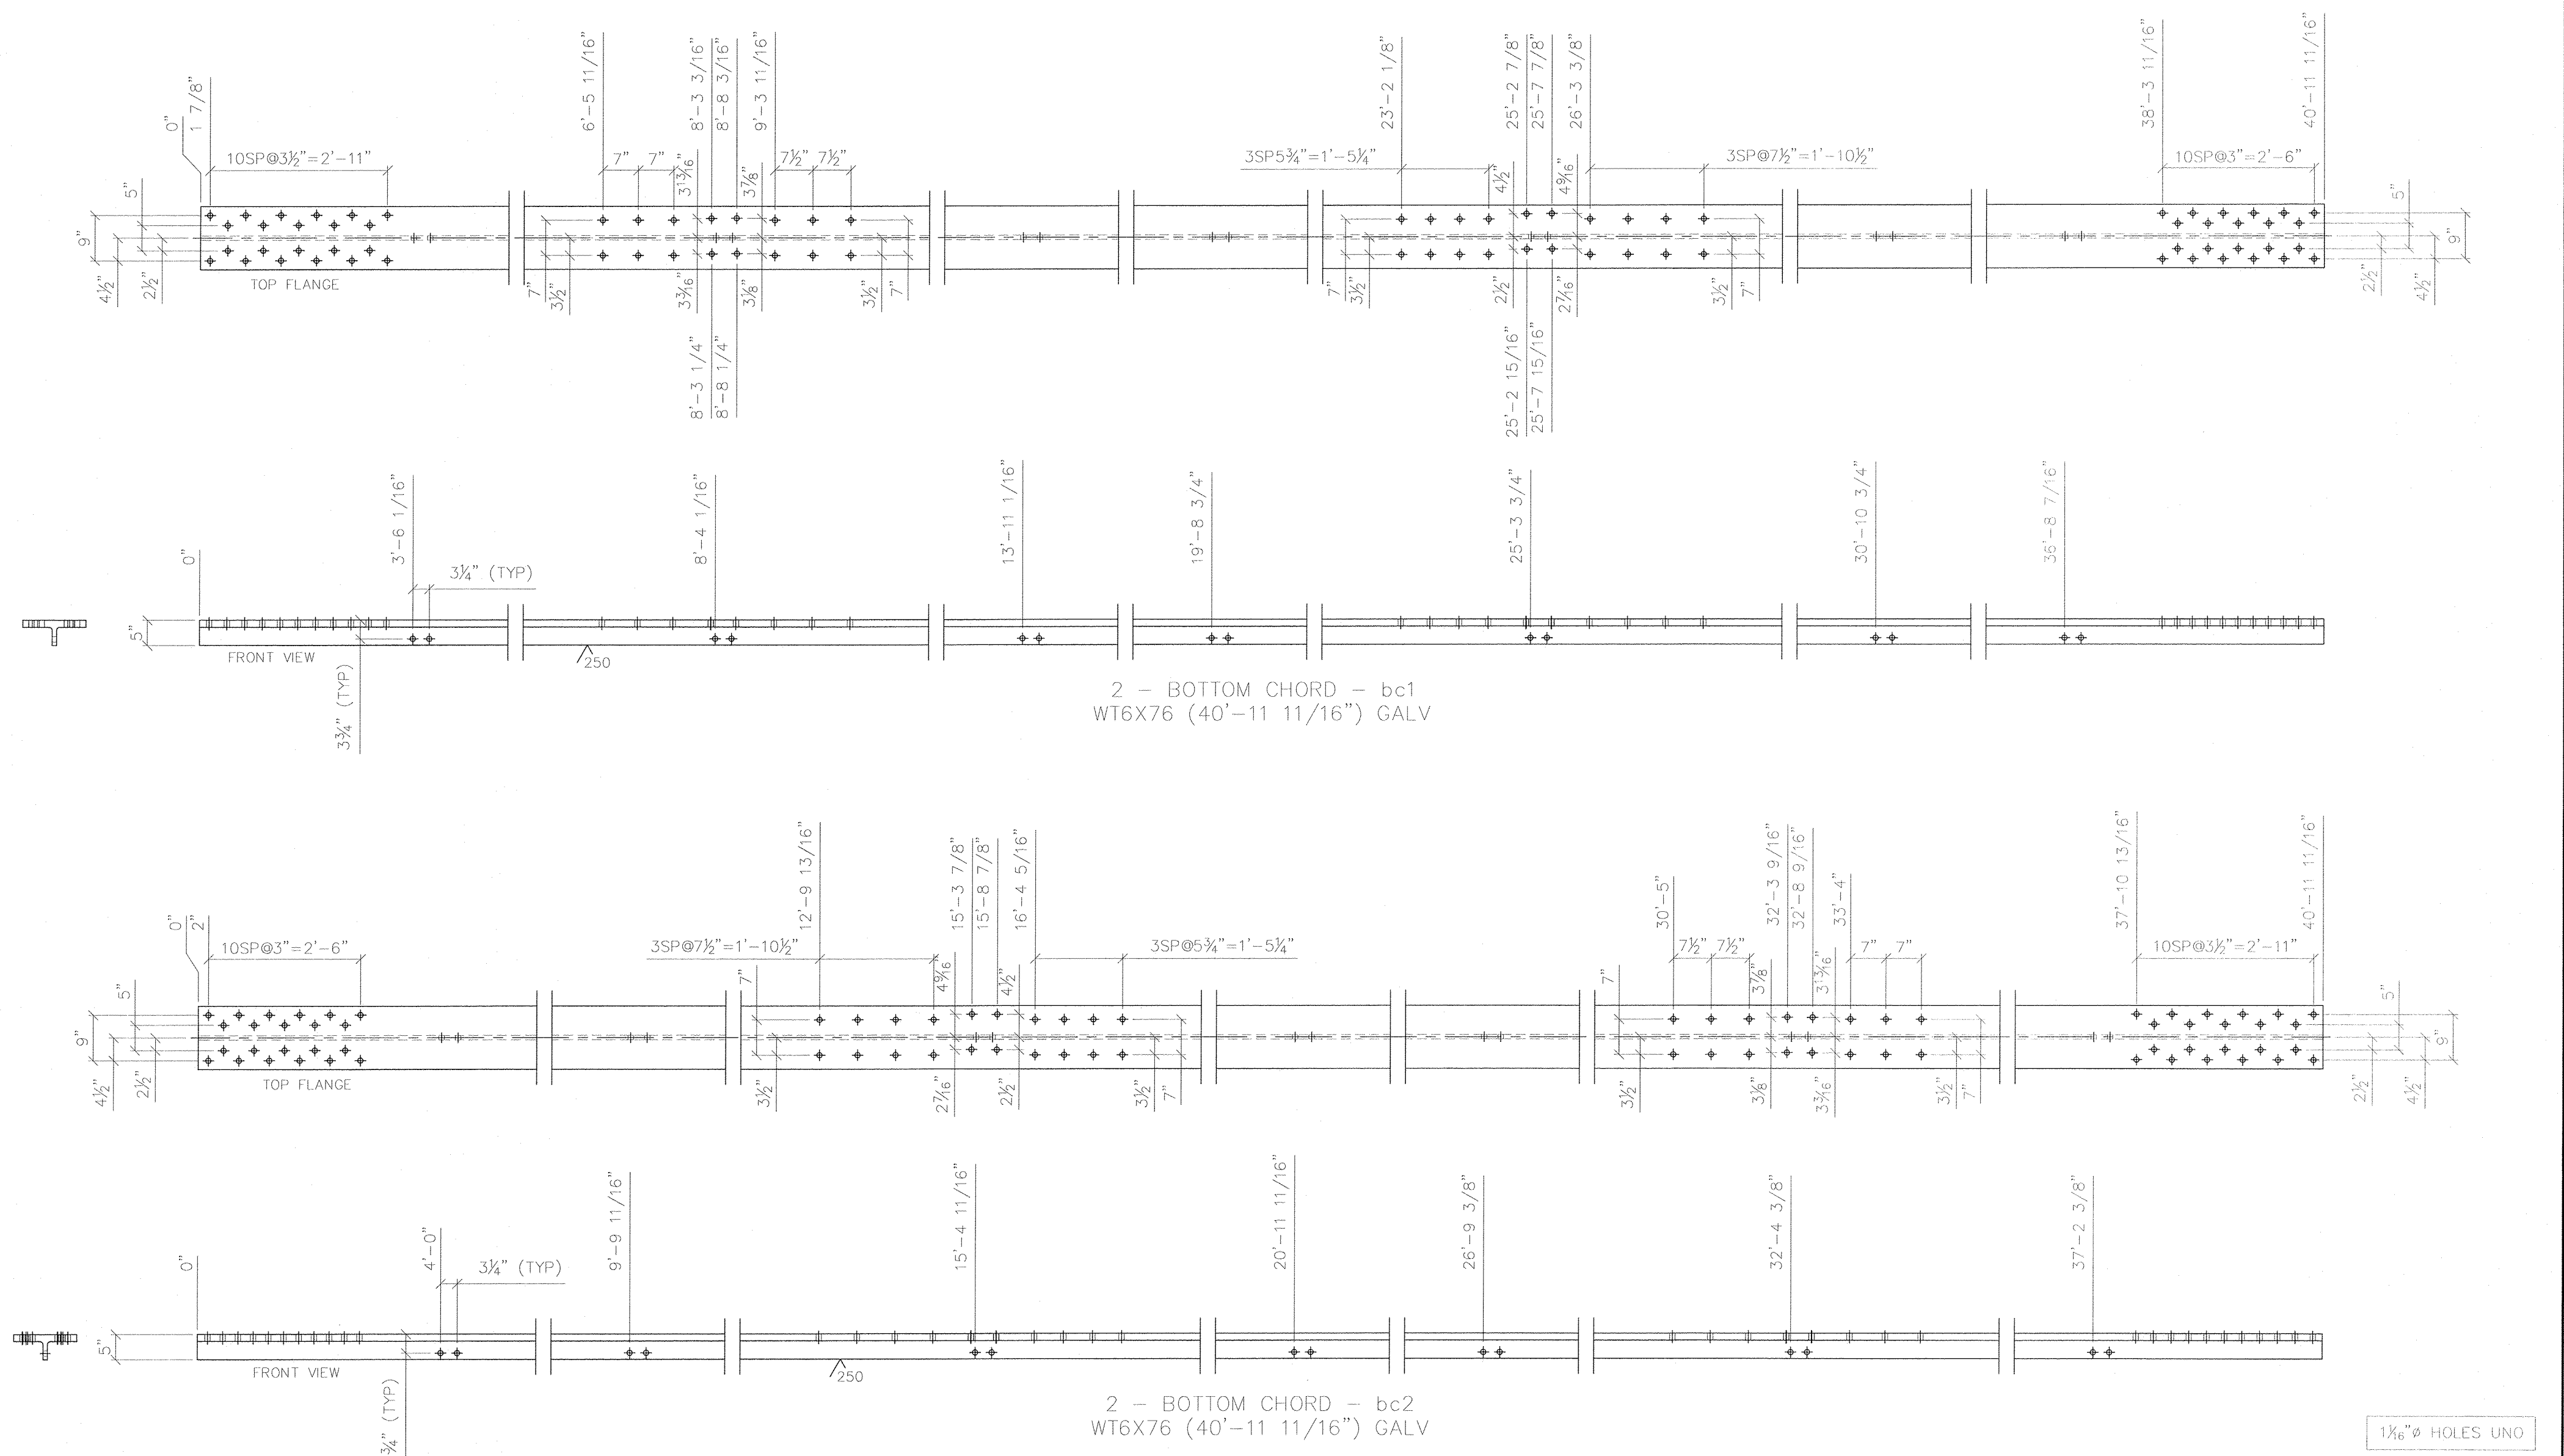

1/8" Ø HOLES UNO

RECORD DWGS
AS FABRICATED
6/24/13

SYMBOLS & ABBREVIATIONS

ES: EACH SIDE	NS: NEAR SIDE
EQ: EQUAL	FS: FAR SIDE
C: CENTERLINE	WP: WORK POINT
REF: REFERENCE	GA: GAUGE
CHK: CHECK	ID: INSIDE DIAMETER
O/O: OUT TO OUT	OD: OUTSIDE DIAMETER
C/C: CENTER TO CENTER	BRG: BEARING
F/F: FACE TO FACE	TYP: TYPICAL
D: DIAMETER	UNO: UNLESS NOTED OTHERWISE
R: RADIUS	ASB: ASSEMBLY
	T&B: TOP & BOTTOM

DIST. BY:
FAB. BY:



SUBMITTAL LOG	DATE	NO.	DATE	REVISIONS:	BY:
INITIAL SUBMITTAL	12/18/12	1	5/15/13	FLOOR BEAM END PLATES WAS 1" THK	TLB
RESUBMITTAL NO. 2	2/5/13	2	5/15/13	ADDED 2" DIA. RAT HOLES IN I61 & I69	TLB
CUSTOMER APPROVAL	2/13/13	3	5/15/13	CHANGED WELD WAS 9/16" ALL AROUND	TLB
SHOP REVIEW	-	4	5/15/13	CHANGED BOLT PATTERN	TLB
PRE FAB MTG	-	5	5/15/13	WAS 2" EDGE DISTANCE	TLB
APPROVED FOR FAB	2/28/13	6	6/3/13	DIMENSIONAL ERRORS	TLB

00000001.jpg

TOWN OF WARREN, VT
COUNTY OF WASHINGTON
BRIDGE NO. 173 REPLACEMENT
WARREN, VT

DESIGN: SAF	DRAW: TLB	REVIEW: SAF/RL/L	CHECK: C/JG	SHEET 9
ITEM NO.: PROJECT NO.: BRF 013-4 (14)			REFERENCE NO.: BRIDGE NO.: 173	TOTAL 58
STRUCTURAL FILE NO.:			USB JOB# 51622	

SHOP DETAILS PROFILES