


DATE PLOTTED: June 24, 2013

S:\DESIGN\VERMONT\1622-Galv\Tubs-1389 x 35\Warren, VT over Mad River Drawings\1622 AS-BUILT 6-24-13.dwg

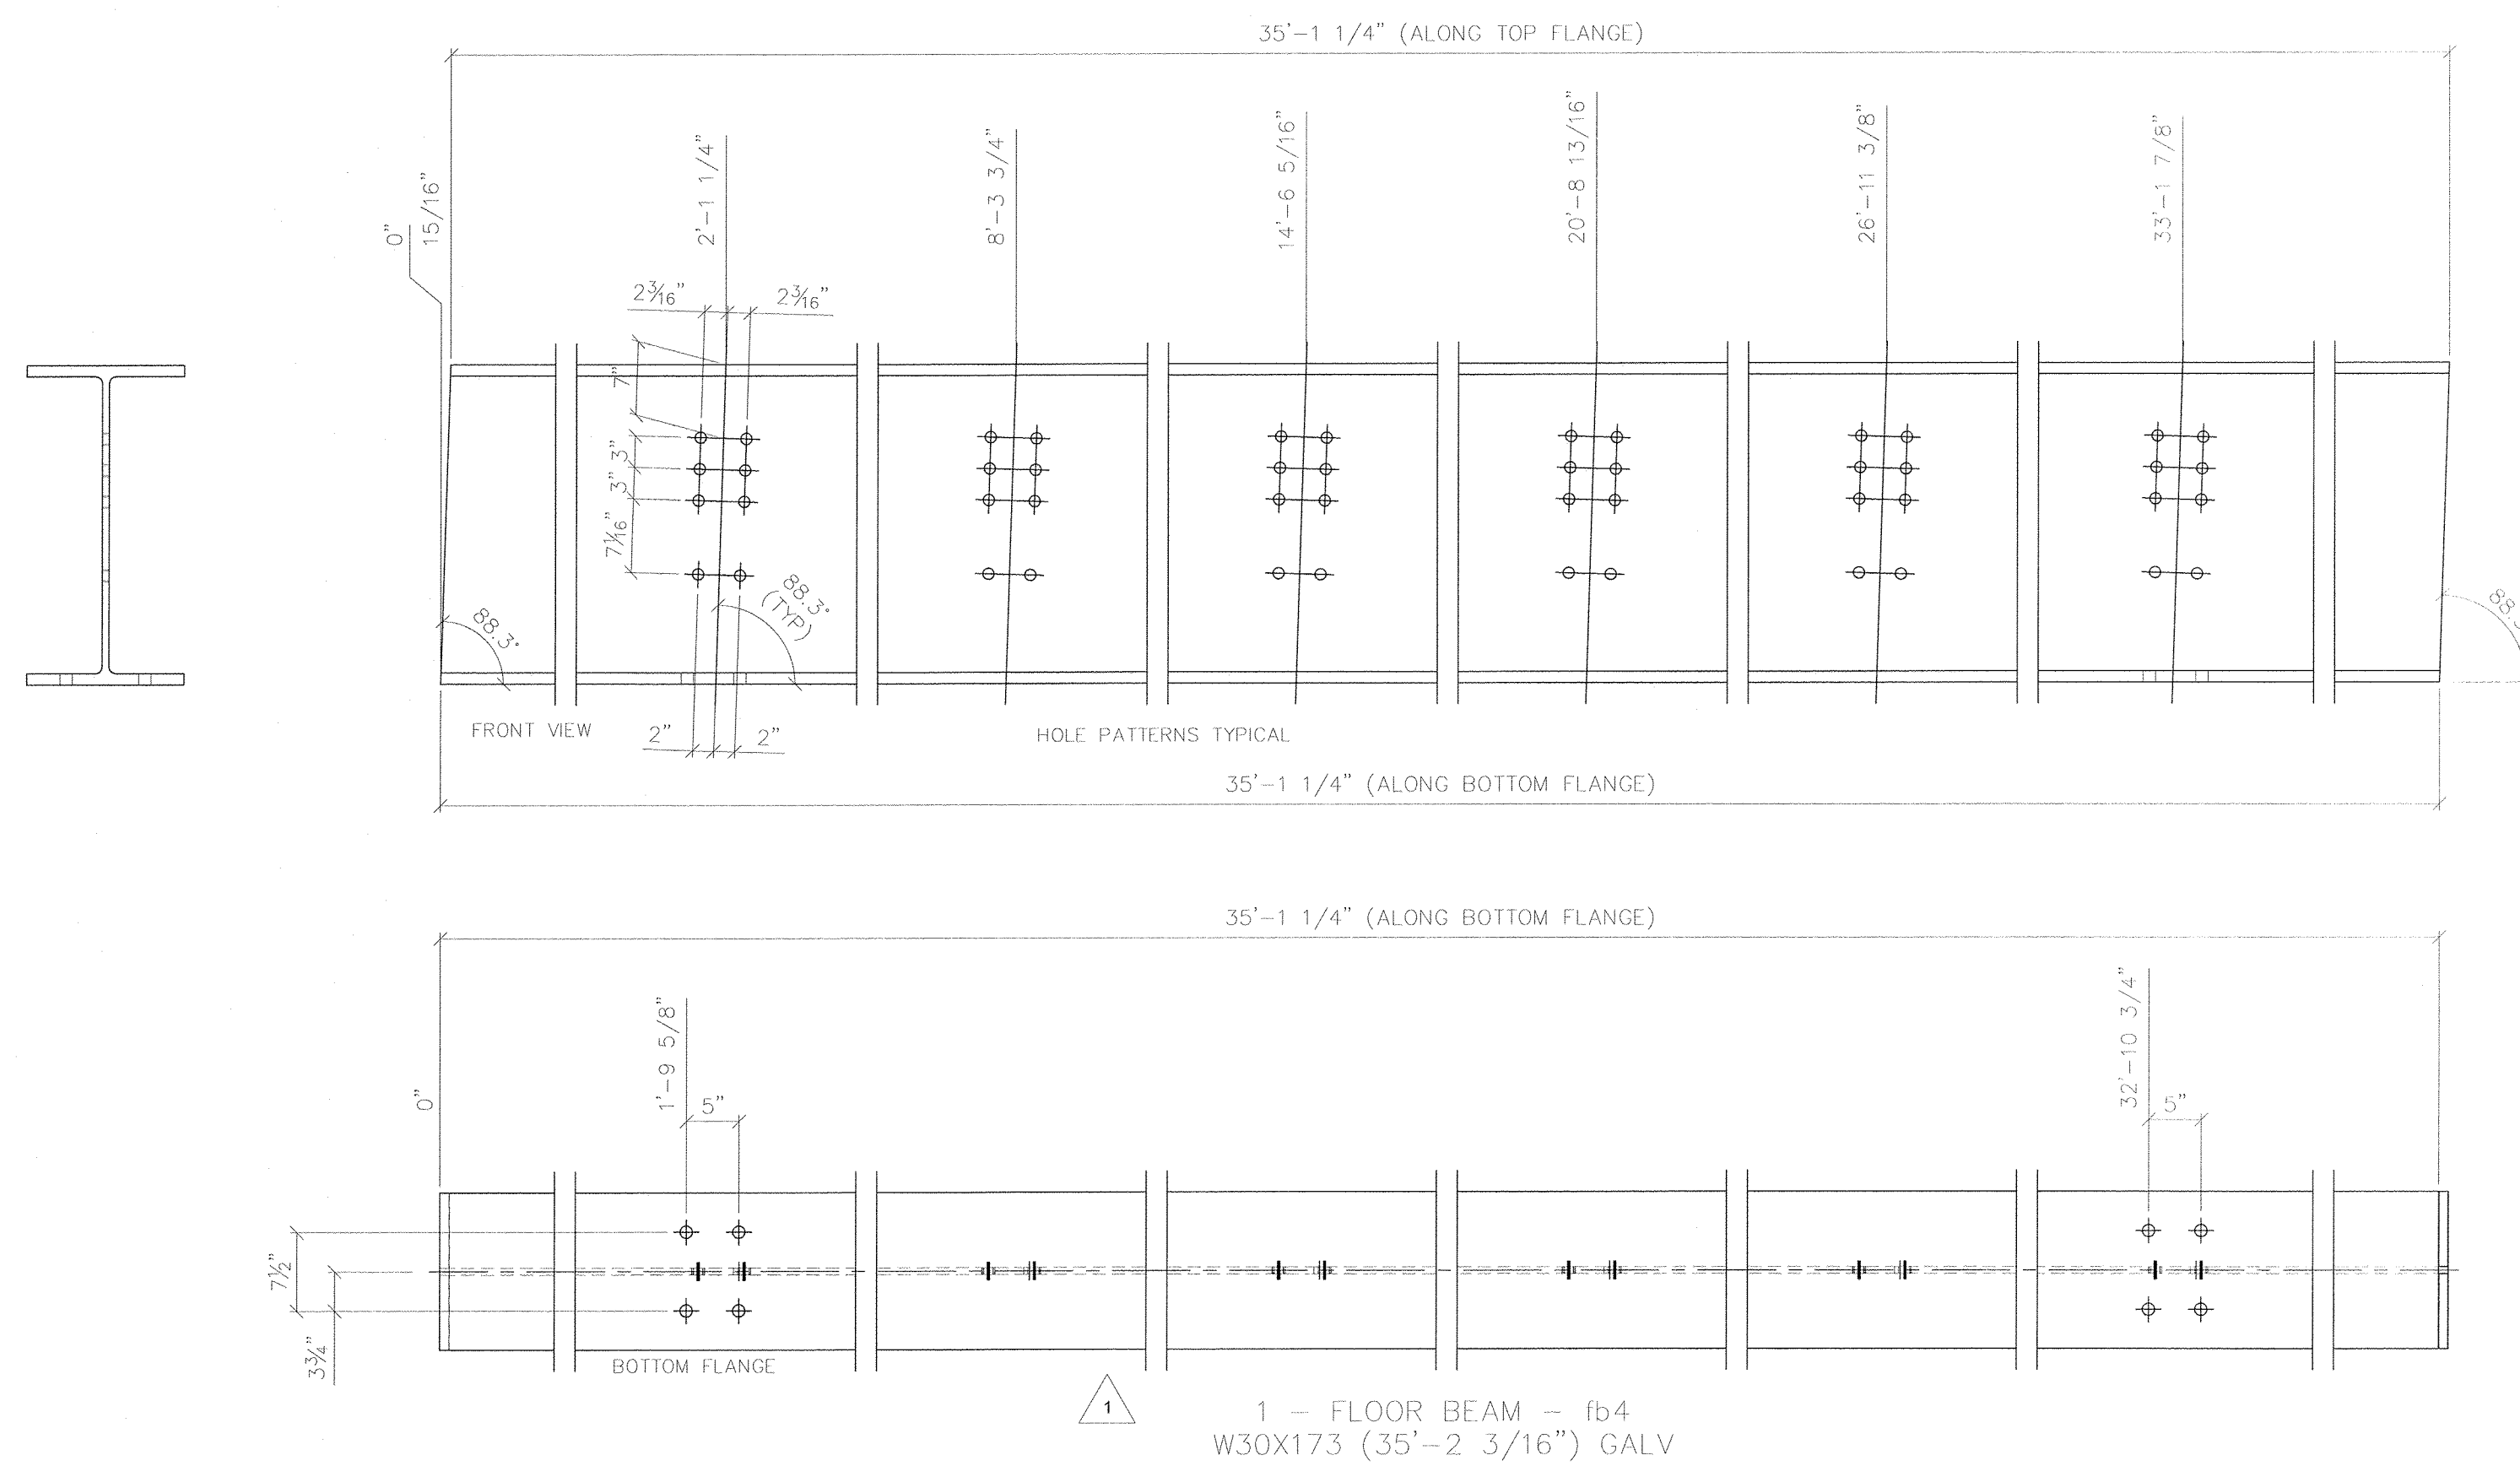

1/8" HOLES UNO

RECORD DWGS
AS FABRICATED
6/24/13

SYMBOLS & ABBREVIATIONS

FS: EACH SIDE	NS: NEAR SIDE
EQ: EQUAL	FS: FAR SIDE
CL: CENTERLINE	WP: WORK POINT
REF: REFERENCE	GA: GAUGE
CHK: CHECK	ID: INSIDE DIAMETER
O/O: OUT TO OUT	OD: OUTSIDE DIAMETER
C/C: CENTER TO CENTER	BRG: BEARING
F/F: FACE TO FACE	TYP: TYPICAL
Ø: DIAMETER	UNO: UNLESS NOTED OTHERWISE
R: RADIUS	ABUT: ABUTMENT
	T&B: TOP & BOTTOM

DIST. BY: **CONTECH** CONSTRUCTION PRODUCTS INC. www.contech-cpi.com

FAB. BY: **U.S. BRIDGE** BRIDGING AMERICA SINCE 1936

SUBMITTAL LOG	DATE	NO.	DATE	REVISIONS	BY:
INITIAL SUBMITTAL	12/18/12	▲	5/15/13	FLOOR BEAM END PLATES WAS 1" THK	TLB
RESUBMITTAL NO. 2	2/5/13	▲	5/15/13	ADDED 2" DIA. RAT HOLES IN fb1 & fb9	TLB
CUSTOMER APPROVAL	2/13/13	▲	5/15/13	CHANGED WELD WAS 3/8" ALL AROUND	TLB
SHOP REVIEW	-	▲	5/15/13	CHANGED BOLT PATTERN	TLB
PRE FAB MTG	-	▲	5/15/13	WAS 2" EDGE DISTANCE	TLB
APPROVED FOR FAB	2/28/13	▲	6/3/13	DIMENSIONAL ERRORS	TLB

00000001.jpg

DESIGN: SAF	DRAW: TLB	REVIEW: SAF/RLL	CHECK: CJG
SHOP DETAILS		PROFILES	

TOWN OF WARREN, VT COUNTY OF WASHINGTON BRIDGE NO.173 REPLACEMENT WARREN, VT	ITEM NO.: PROJECT NO.: BRF 013-4 (14) REFERENCE NO.: BRIDGE NO.: 173 STRUCTURAL FILE NO.:
USB JOB# 51622	9 of 58 TOTAL