




DATE PLOTTED June 24, 2013

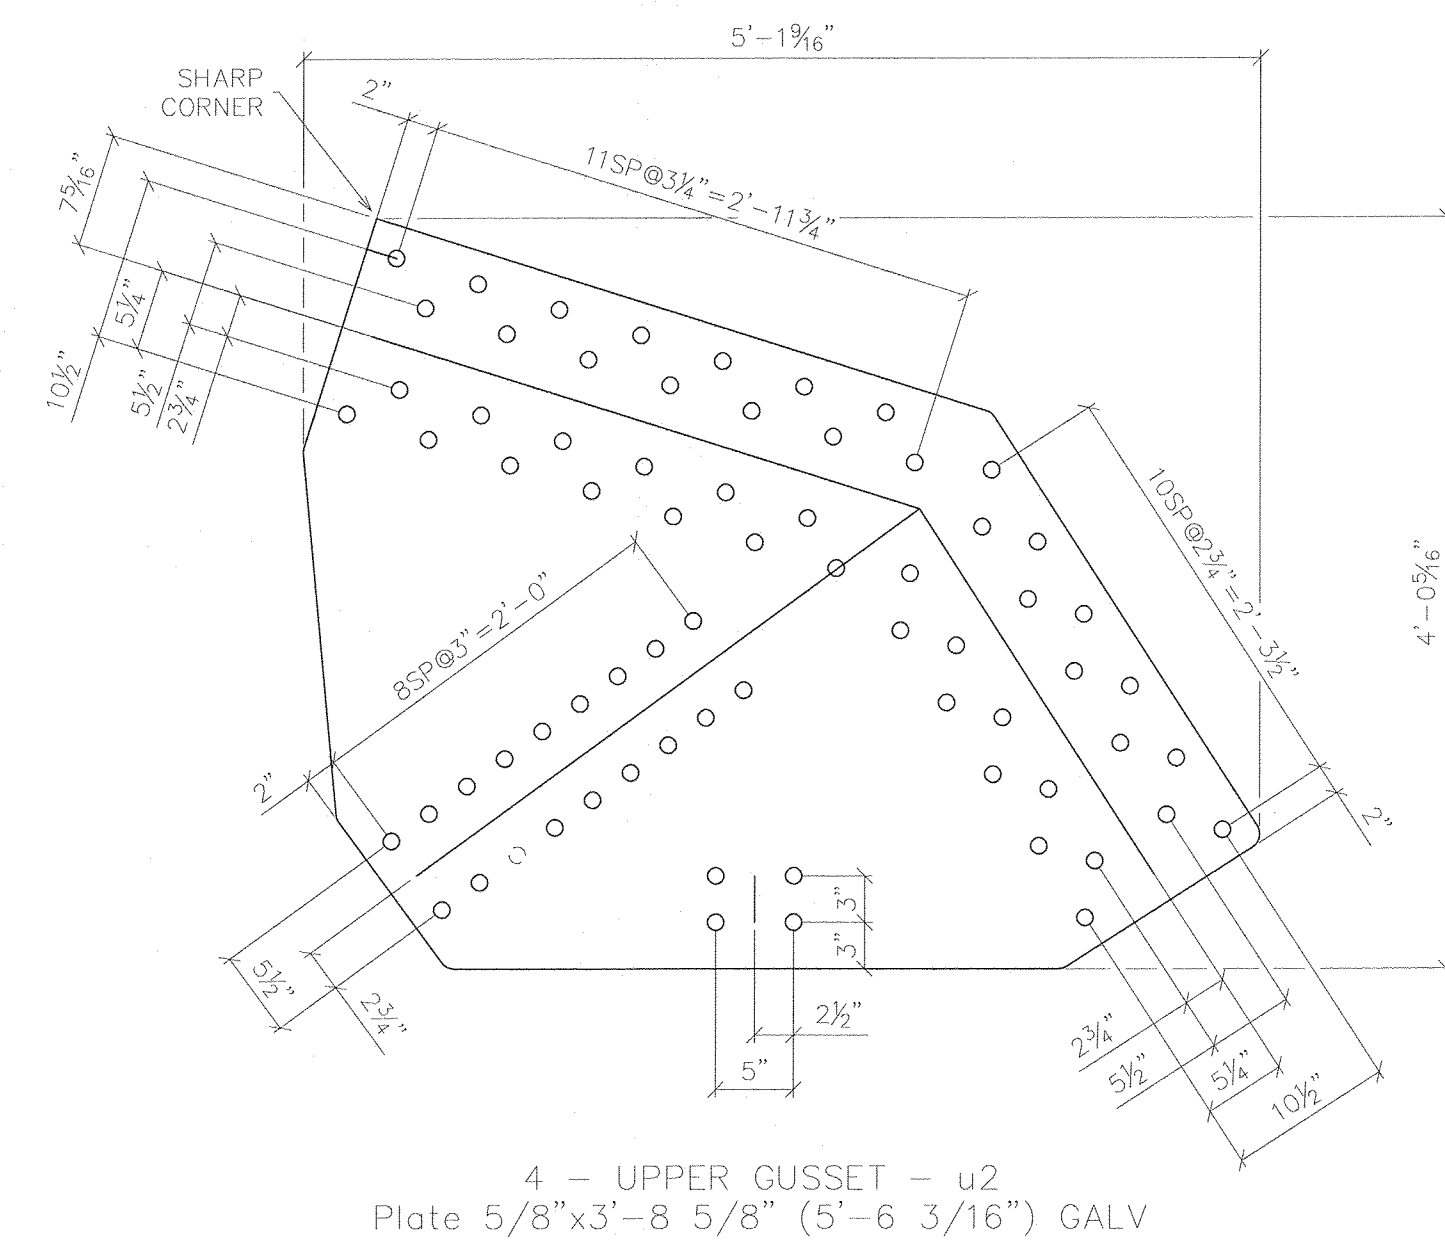


4 - UPPER GUSSET - u2
Plate 5/8"x3'-8 5/8" (5'-6 3/16") GALV

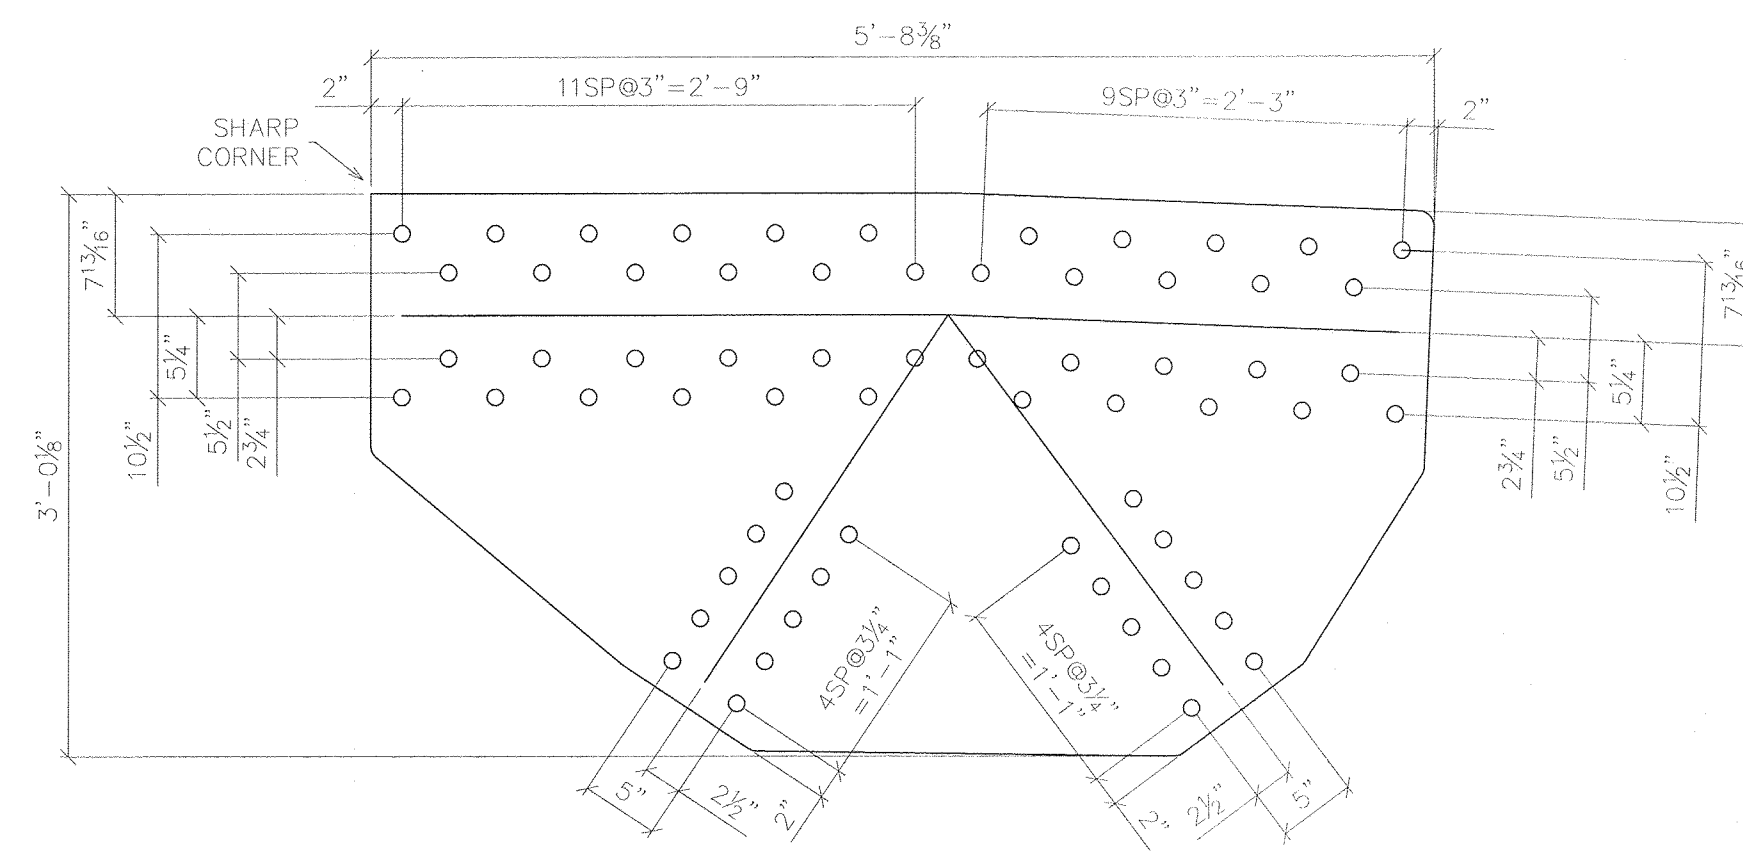

4 - UPPER GUSSET - u6
Plate 5/8"x3'-0 1/8" (5'-8 3/8") GALV

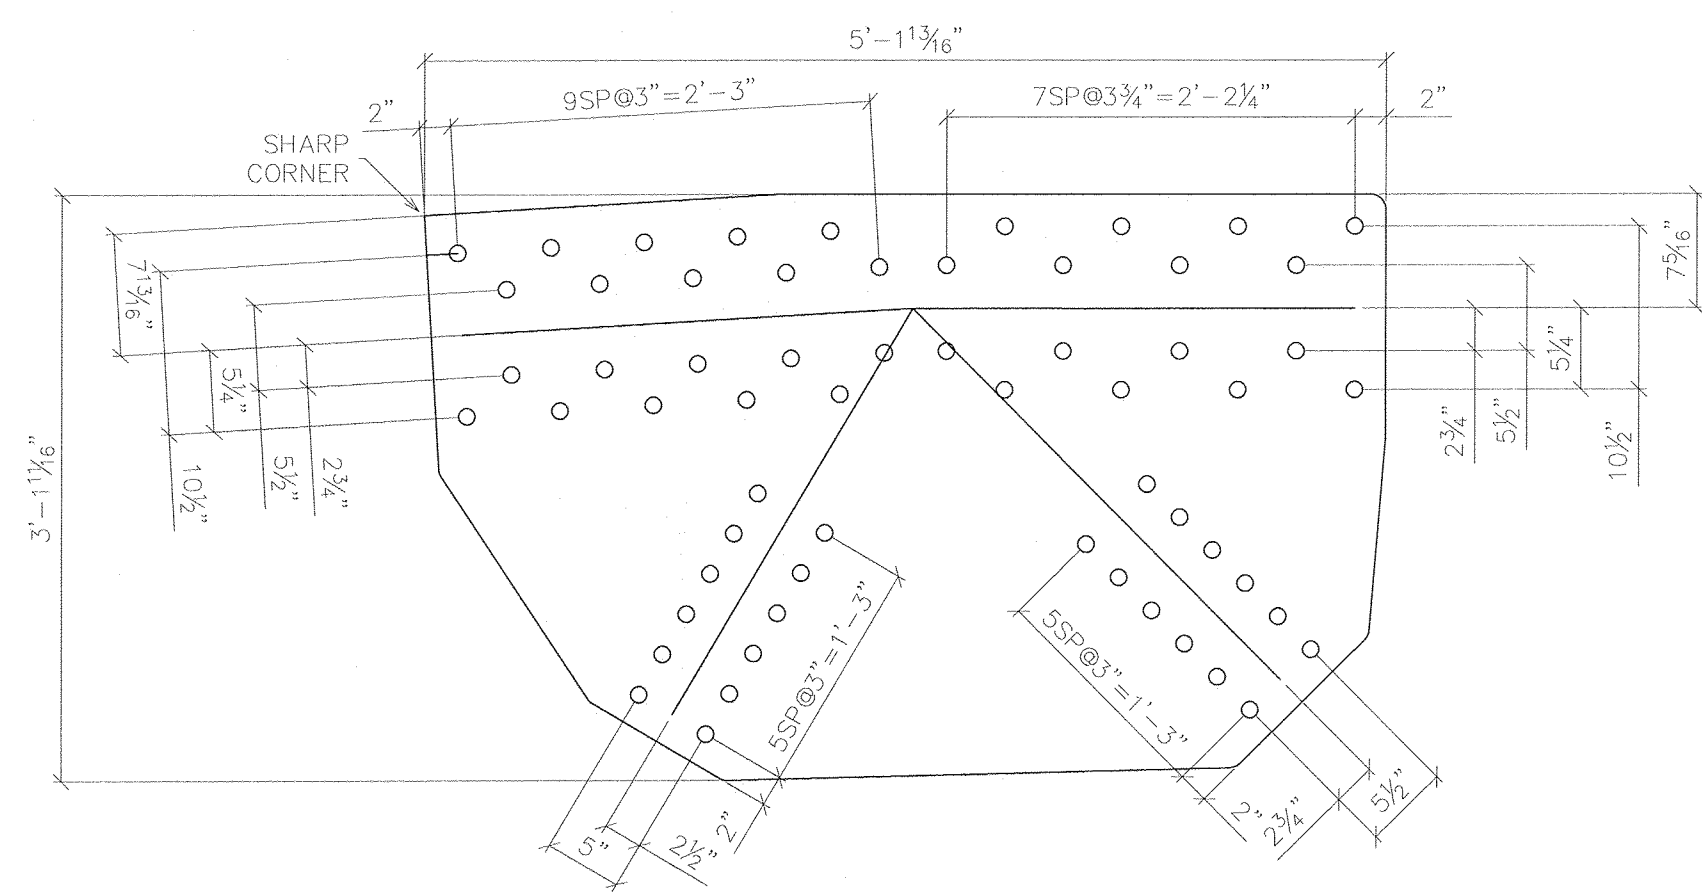

4 - UPPER GUSSET - u4
Plate 5/8"x3'-1 11/16" (5'-1 13/16") GALV

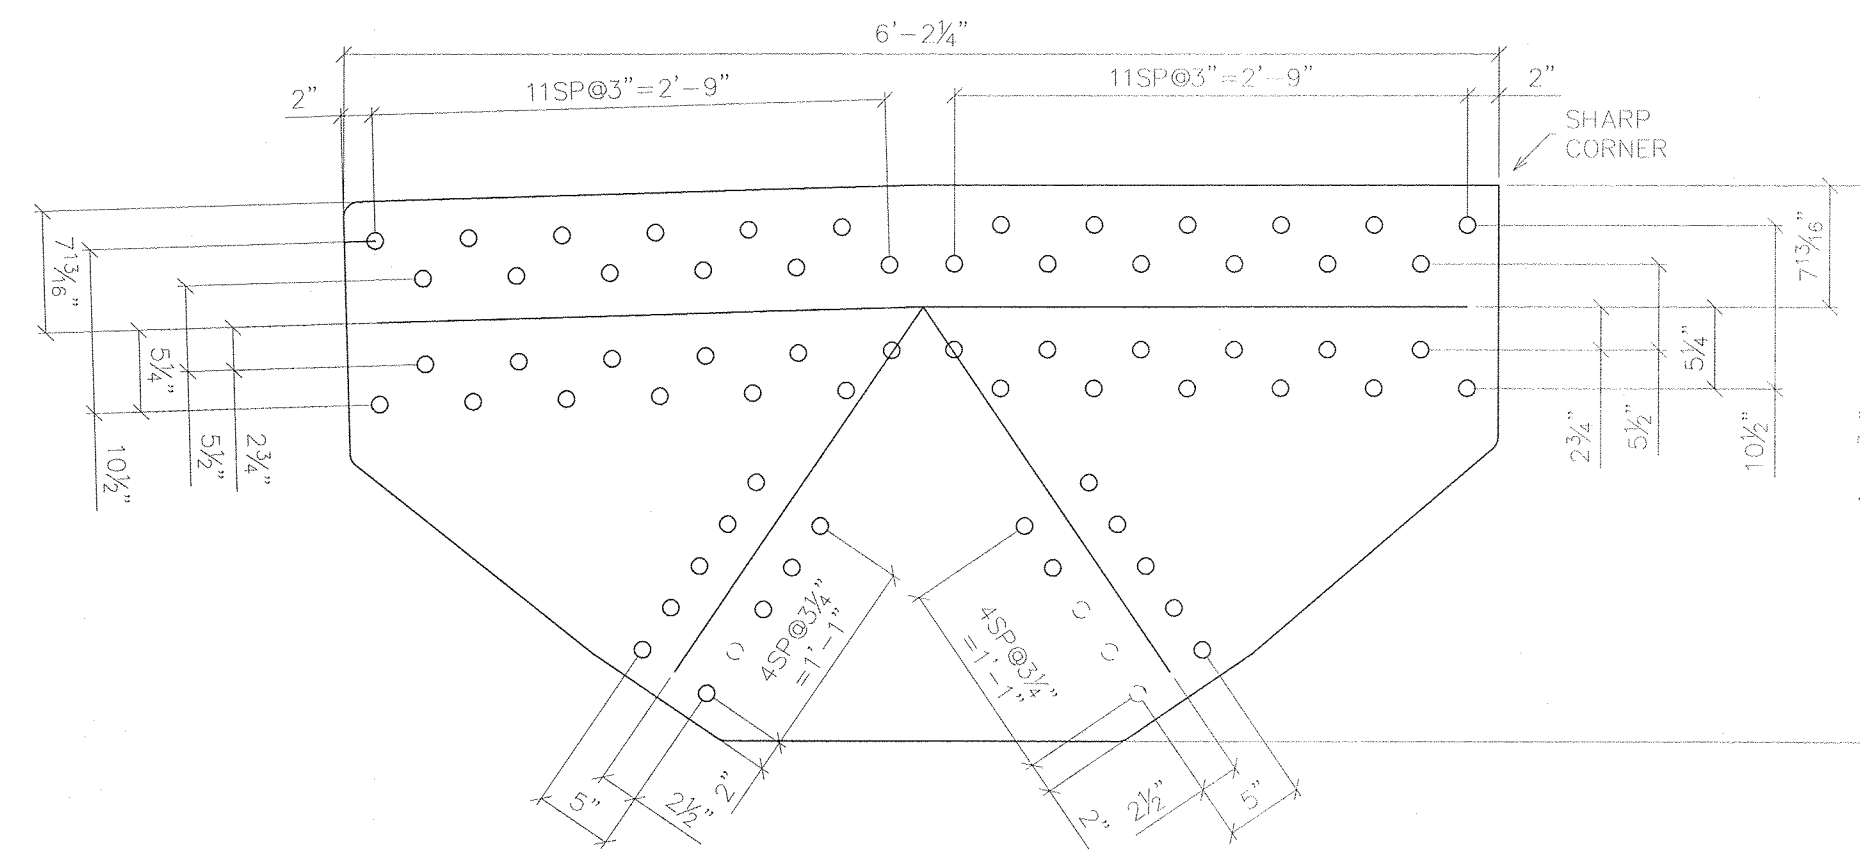

8 - UPPER GUSSET - u8
Plate 5/8"x2'-11 3/4" (6'-2 1/4") GALV


1 1/16" Ø HOLES UNO

RECORD DWGS
AS FABRICATED
6/24/13

S:\03SERVICEMOUNTS\622-Galv-Truss-138" x 35'-Warren.VT over Main River\Drawings\622-Galv-TRUSS\6-24-13.dwg

SYMBOLS & ABBREVIATIONS	
ES: EACH SIDE	NS: NEAR SIDE
EQ: EQUAL	FS: FAR SIDE
CL: CENTERLINE	WP: WORK POINT
REF: REFERENCE	GA: GAUGE
CHK: CHECK	ID: INSIDE DIAMETER
O/O: OUT TO OUT	OD: OUTSIDE DIAMETER
C/C: CENTER TO CENTER	BRG: BEARING
F/F: FACE TO FACE	TYP: TYPICAL
DIA: DIAMETER	UNO: UNLESS NOTED OTHERWISE
R: RADIUS	ABUT: ABUTMENT
	T&B: TOP & BOTTOM

DIST. BY:
FAB. BY:

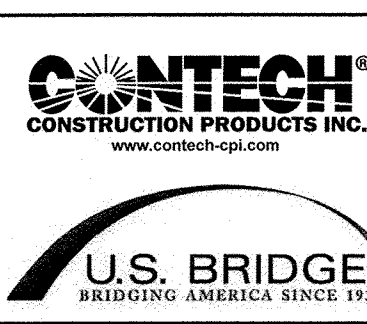

SUBMITTAL LOG		DATE	NO.	DATE	REVISIONS	BY
INITIAL SUBMITTAL		12/18/12	1	5/15/13	FLOOR BEAM END PLATES WAS 1" THK	TLB
RESUBMITTAL NO. 2		2/5/13	2	5/15/13	ADDED 2" DIA. RAT HOLES IN fb1 & fb9	TLB
CUSTOMER APPROVAL		2/13/13	3	5/15/13	CHANGED WELD WAS 3/16" ALL AROUND	TLB
SHOP REVIEW			4	5/15/13	CHANGED BOLT PATTERN	TLB
PRE FAB MTG			5	5/15/13	WAS 2" EDGE DISTANCE	TLB
APPROVED FOR FAB		2/28/13	6	6/3/13	DIMENSIONAL ERRORS	TLB

00000001.jpg

TOWN OF WARREN, VT
COUNTY OF WASHINGTON
BRIDGE NO.173 REPLACEMENT
WARREN, VT

ITEM NO.:
PROJECT NO.: BRF 013-4 (14)
REFERENCE NO.:
BRIDGE NO.: 173
STRUCTURAL FILE NO.:

DESIGN: SAF	DRAW: TLB	REVIEW: SAF/RLI	CHECK: CJG	SHEET 10j	58
SHOP DETAILS		PLATES		USB JOB# 51622	TOTAL