




DATE PLOTTED: June 24, 2013

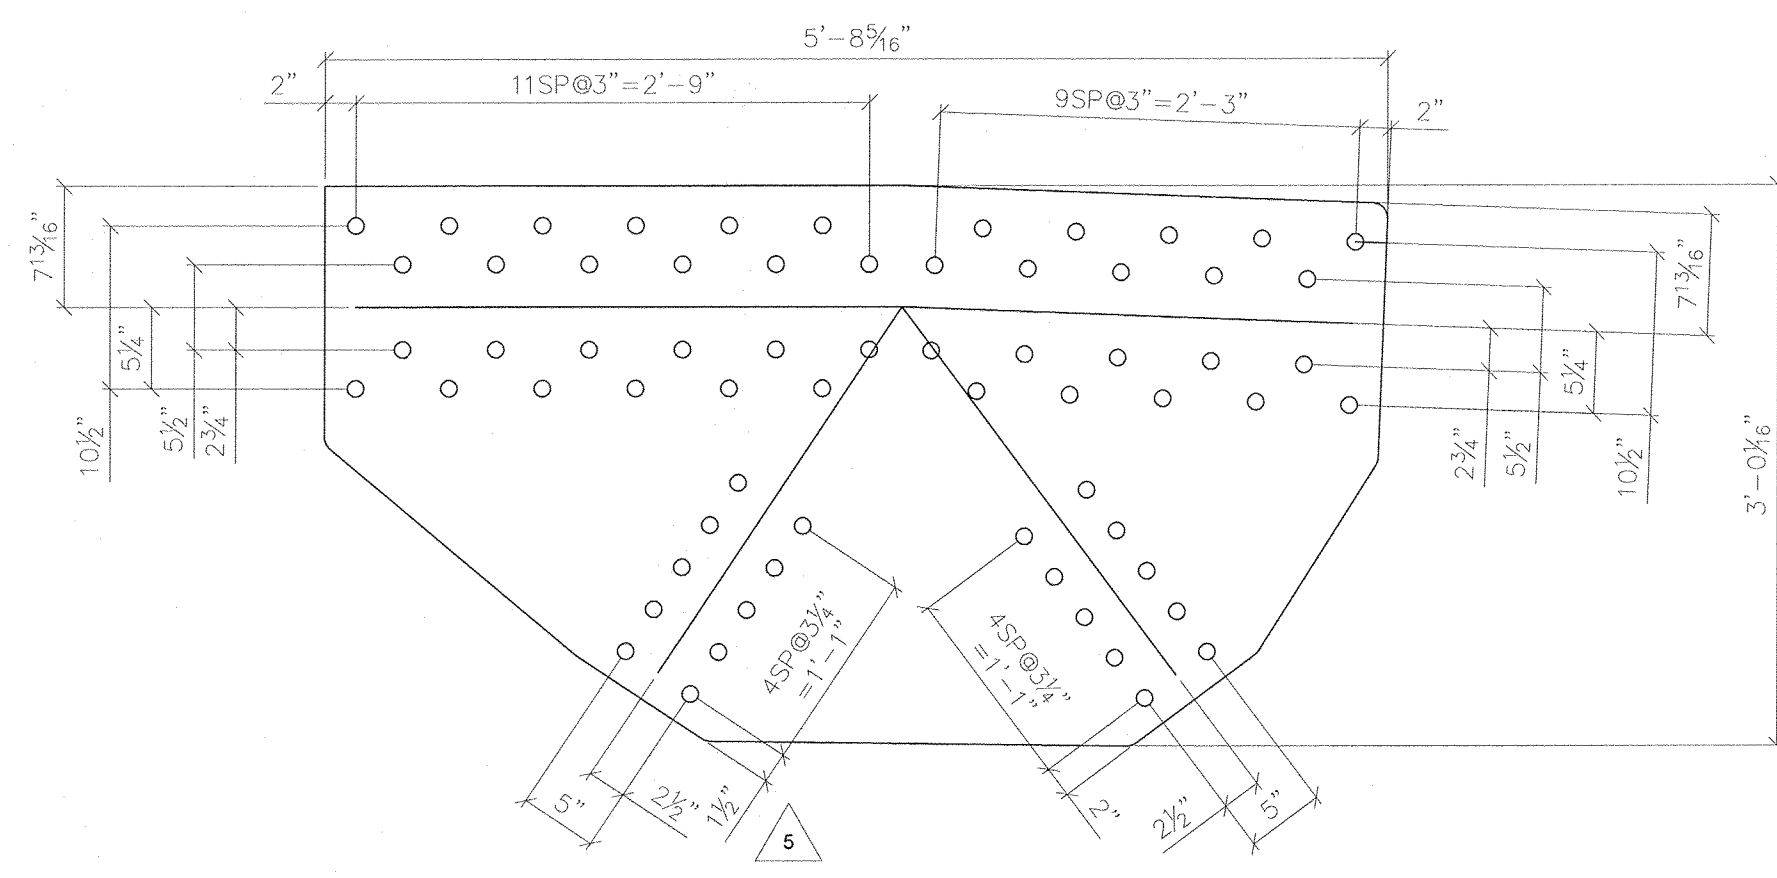


4 - UPPER GUSSET - u12
Plate 5/8"x3'-0 1/16" (5'-8 5/16") GALV

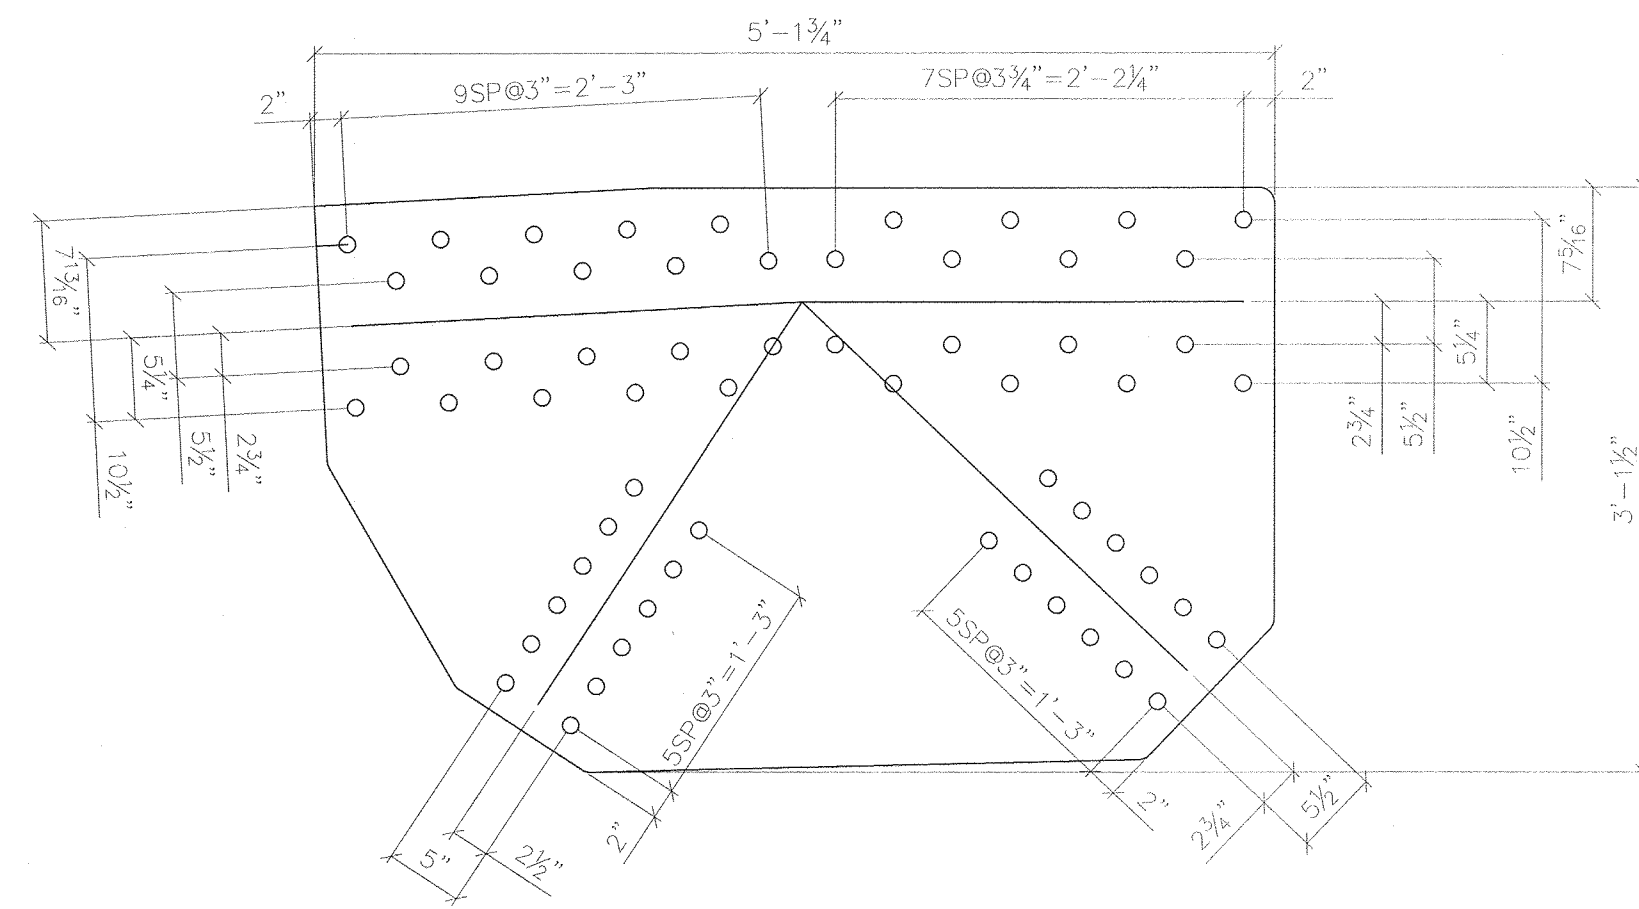


4 - UPPER GUSSET - u14
Plate 5/8"x3'-1 1/2" (5'-1 3/4") GALV

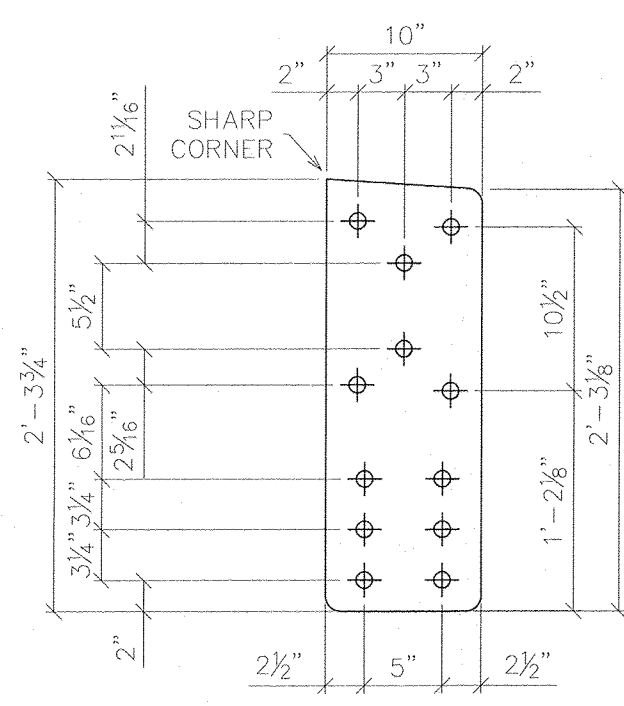

4 - UPPER GUSSET - u13
Plate 5/8"x10" (2'-3 3/4") GALV

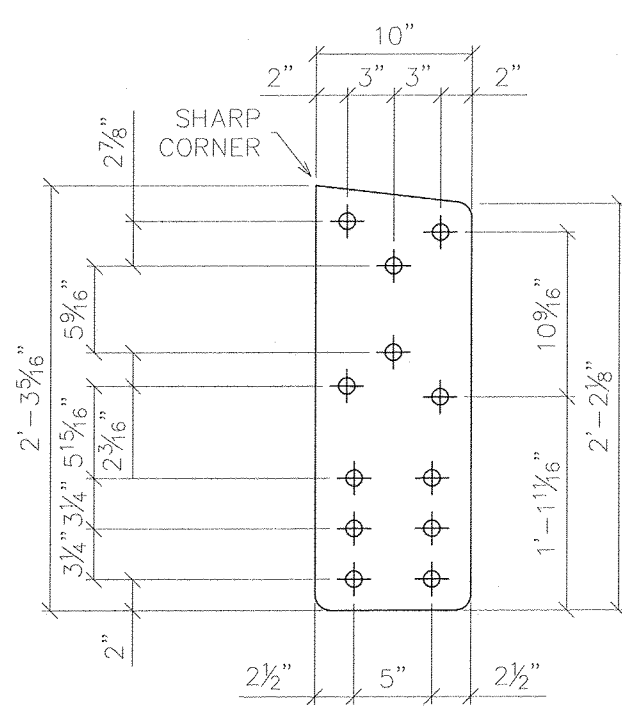

4 - UPPER GUSSET - u15
Plate 5/8"x10" (2'-3 5/16") GALV

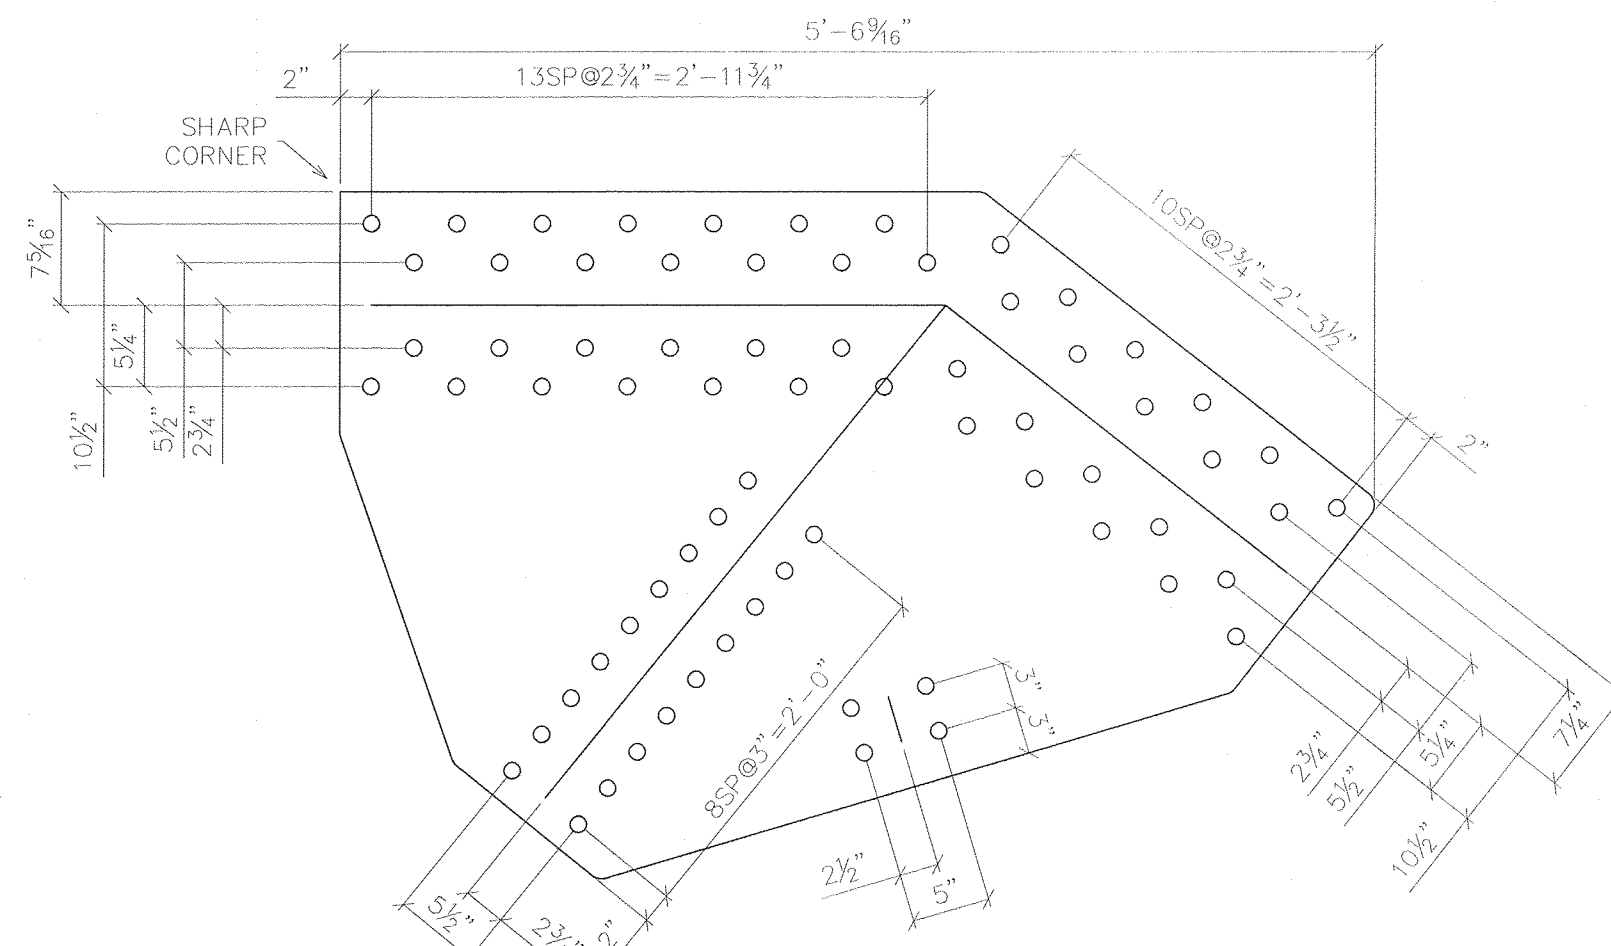

4 - UPPER GUSSET - u16
Plate 5/8"x3'-11 1/4" (5'-2 1/2") GALV

1/8" HOLES UNO

RECORD DWGS
AS FABRICATED

6/24/13

S:\DESIGN\MONT151622.dwg / T:\ms-1385 x 35-Warren,VT over Mad River\Drawings\1622 AS-BUILT 6-24-13.dwg

SYMBOLS & ABBREVIATIONS

ES: EACH SIDE	NS: NEAR SIDE
EQ: EQUAL	FS: FAR SIDE
CL: CENTERLINE	WP: WORK POINT
REF: REFERENCE	GA: GAUGE
CHK: CHECK	ID: INSIDE DIAMETER
OD: OUT TO OUT	OD: OUTSIDE DIAMETER
C/C: CENTER TO CENTER	BRG: BEARING
DIA: DIAMETER	TYP: TYPICAL
R: RADIUS	UNO: UNLESS NOTED OTHERWISE
	ABUT: ABUTMENT
	T&B: TOP & BOTTOM

DIST. BY:



SUBMITTAL LOG	DATE	NO.	DATE	REVISIONS	BY
INITIAL SUBMITTAL	12/18/12	1	5/15/13	FLOOR BEAM END PLATES WAS 1" THK	TLB
RESUBMITTAL NO. 2	2/5/13	2	5/15/13	ADDED 2" DIA. RAT HOLES IN 1b1 & 1b9	TLB
CUSTOMER APPROVAL	2/13/13	3	5/15/13	CHANGED WELD WAS 5/16" ALL AROUND	TLB
SHOP REVIEW	-	4	5/15/13	CHANGED BOLT PATTERN	TLB
PRE FAB MTG	-	5	5/15/13	WAS 2" EDGE DISTANCE	TLB
APPROVED FOR FAB	2/28/13	6	6/3/13	DIMENSIONAL ERRORS	TLB

00000001.jpg

TOWN OF WARREN, VT
COUNTY OF WASHINGTON
BRIDGE NO.173 REPLACEMENT
WARREN, VT

DESIGN: SAF	DRAW: TLB	REVIEW: SAF/RLI	CHECK: CJG
PROJECT NO.: BRF 013-4 (14)	REFERENCE NO.: BRIDGE NO.: 173	STRUCTURAL FILE NO.:	
USB JOB# 51622	SHEET 10k	TOTAL 58	