
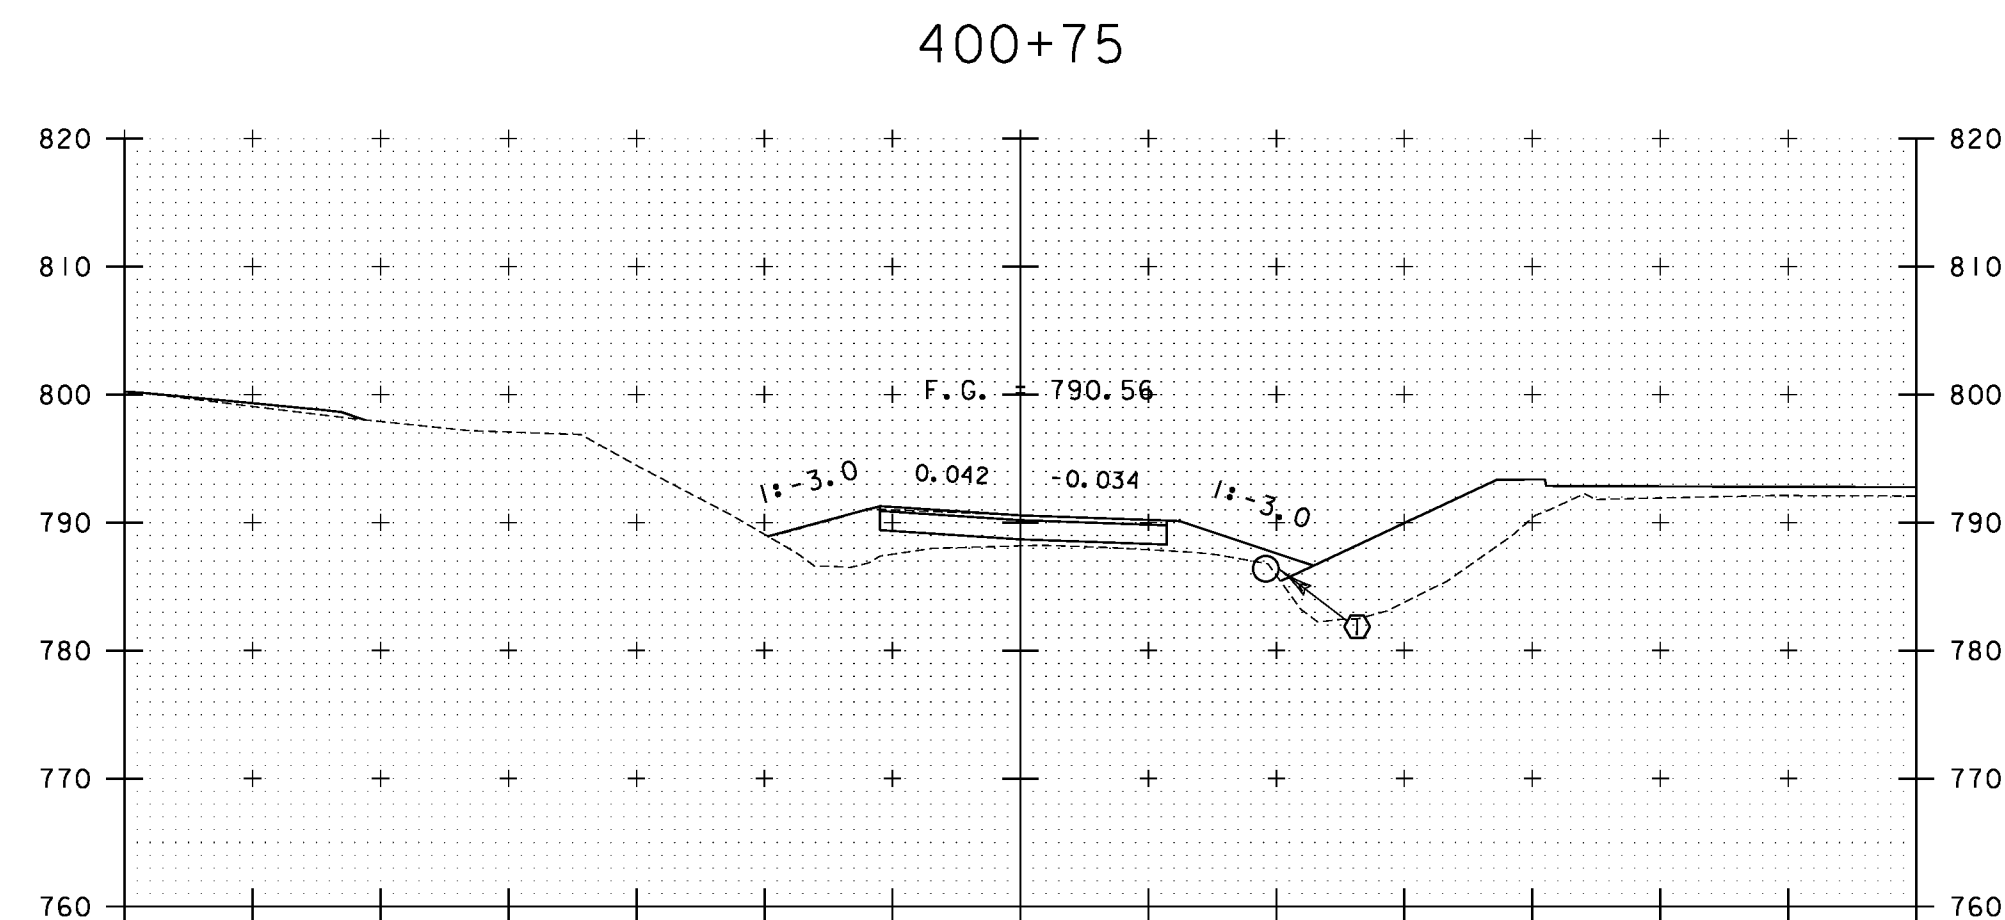
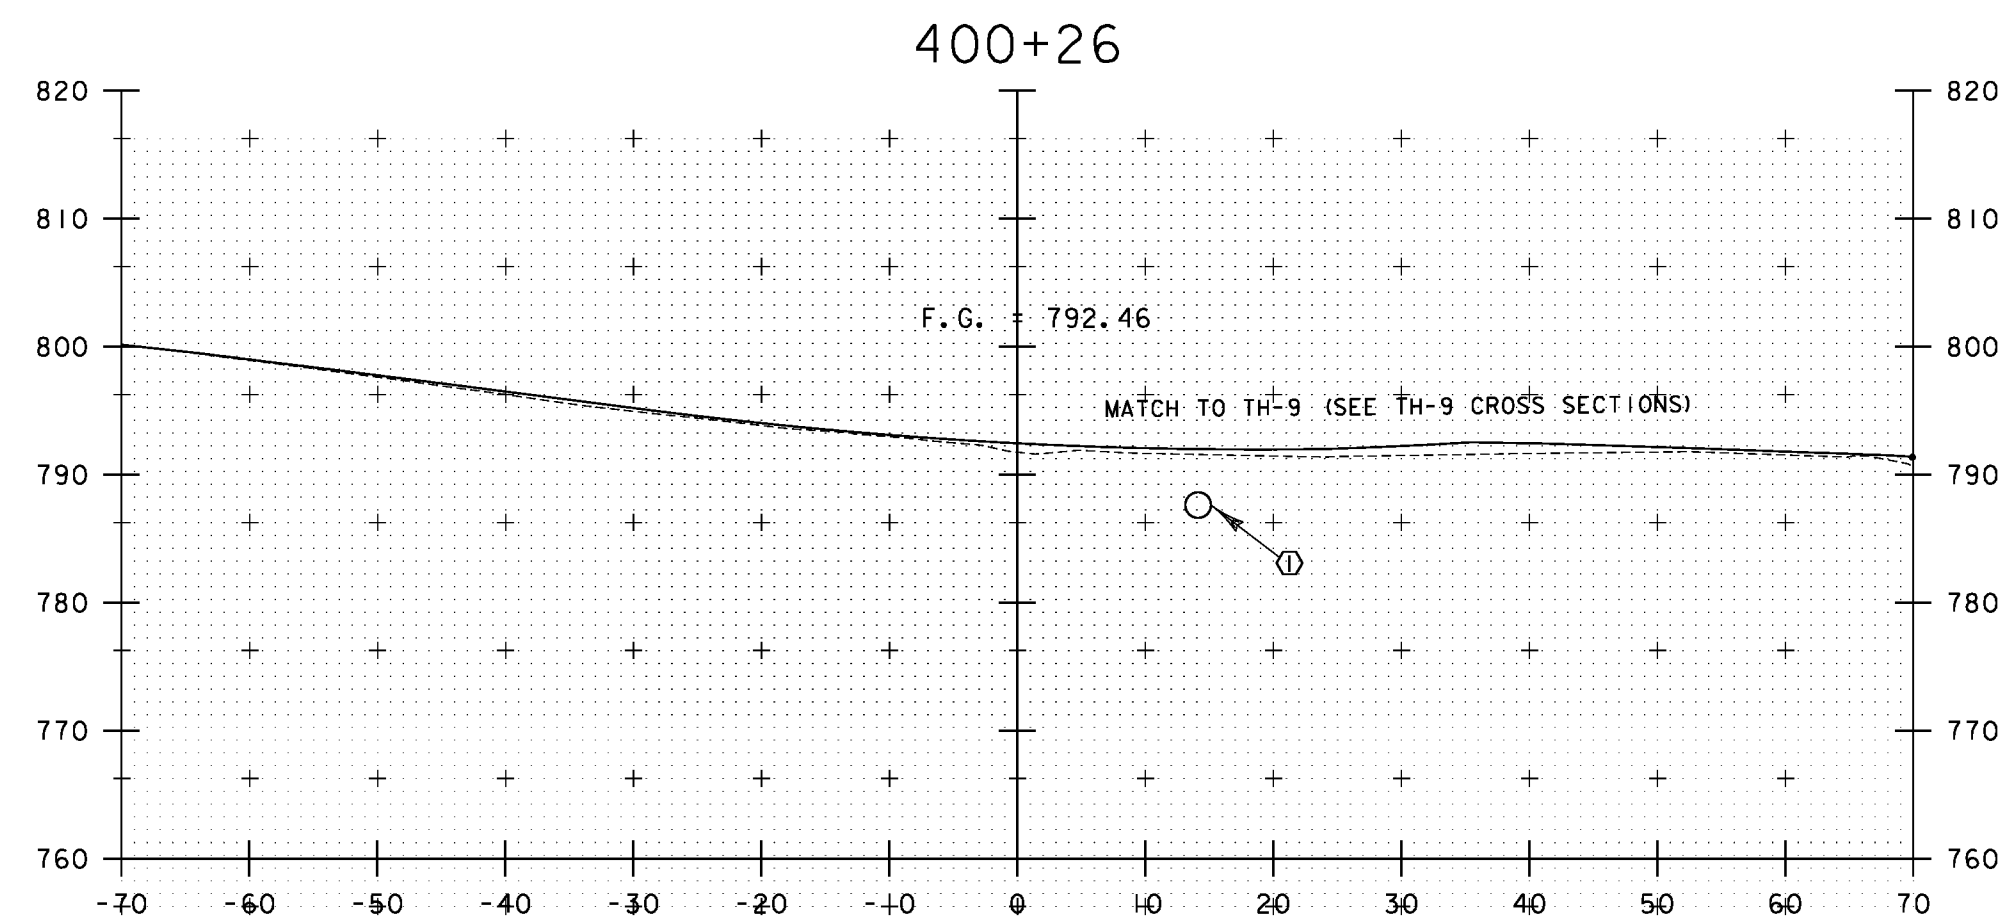
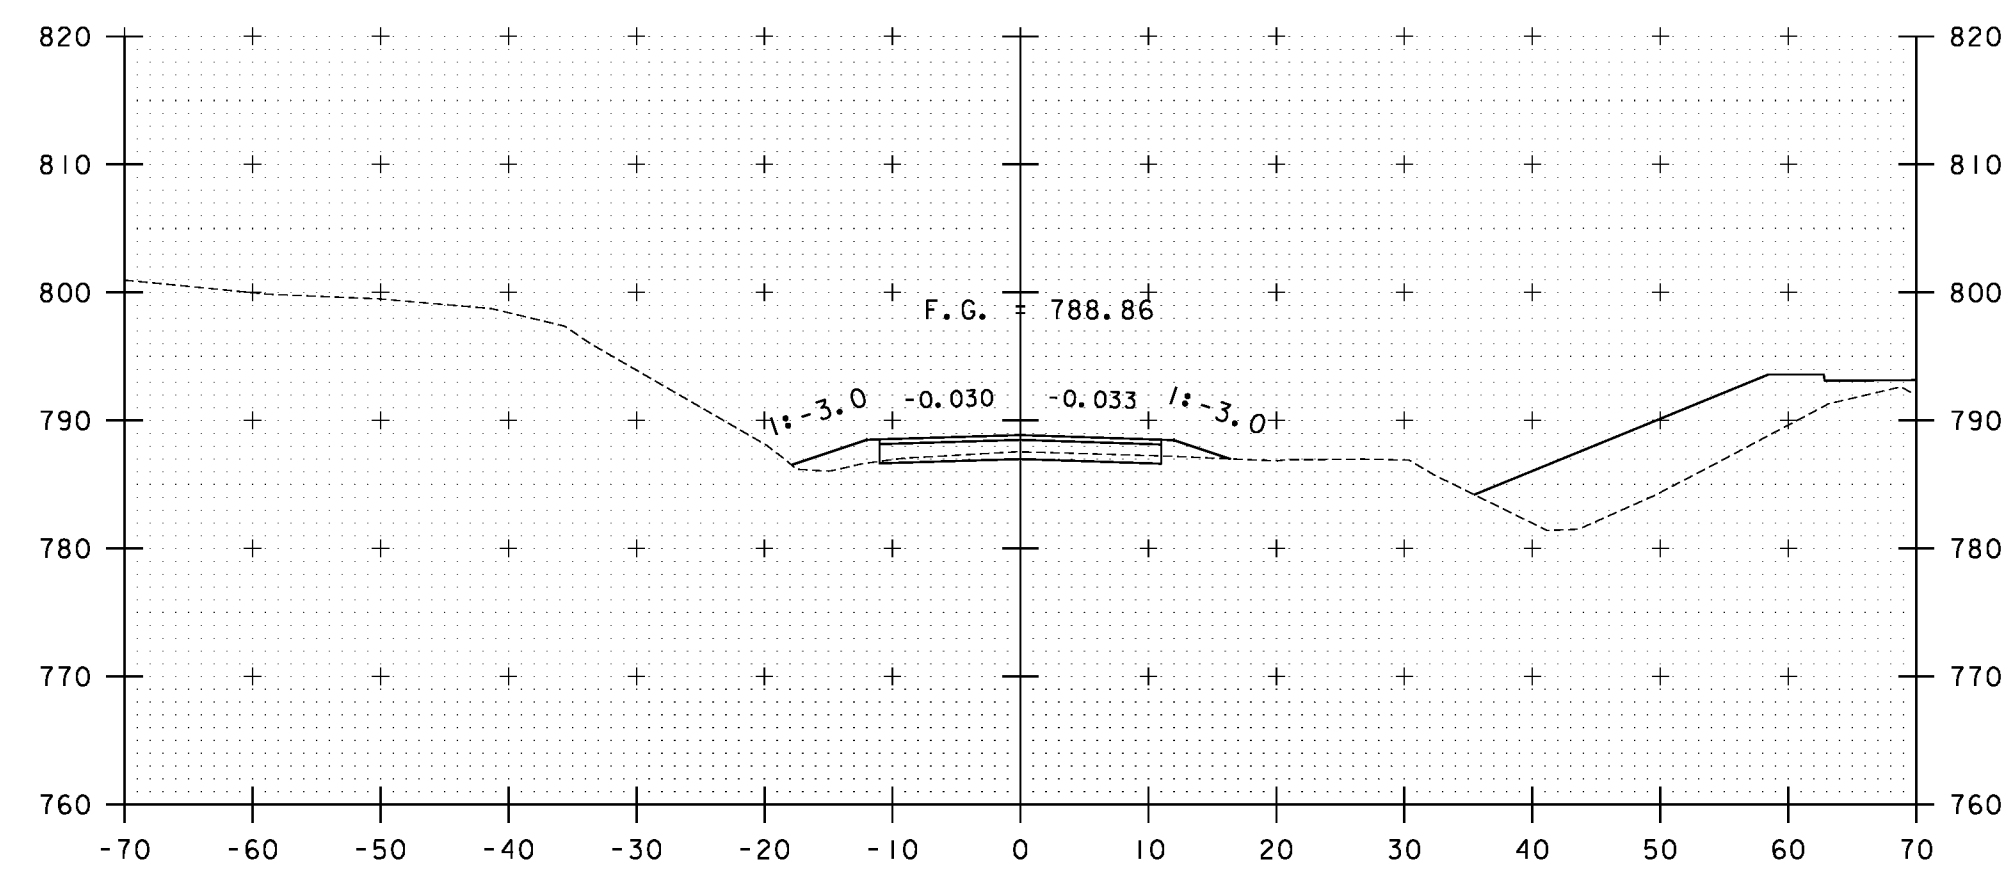


REVISED TH-41 WITH RAISED GRADE

USE THESE CROSS SECTION WITH THE CONTRACT PLAN CROSS SECTIONS FOR SIDE SLOPE AND DRAINAGE REQUIREMENTS

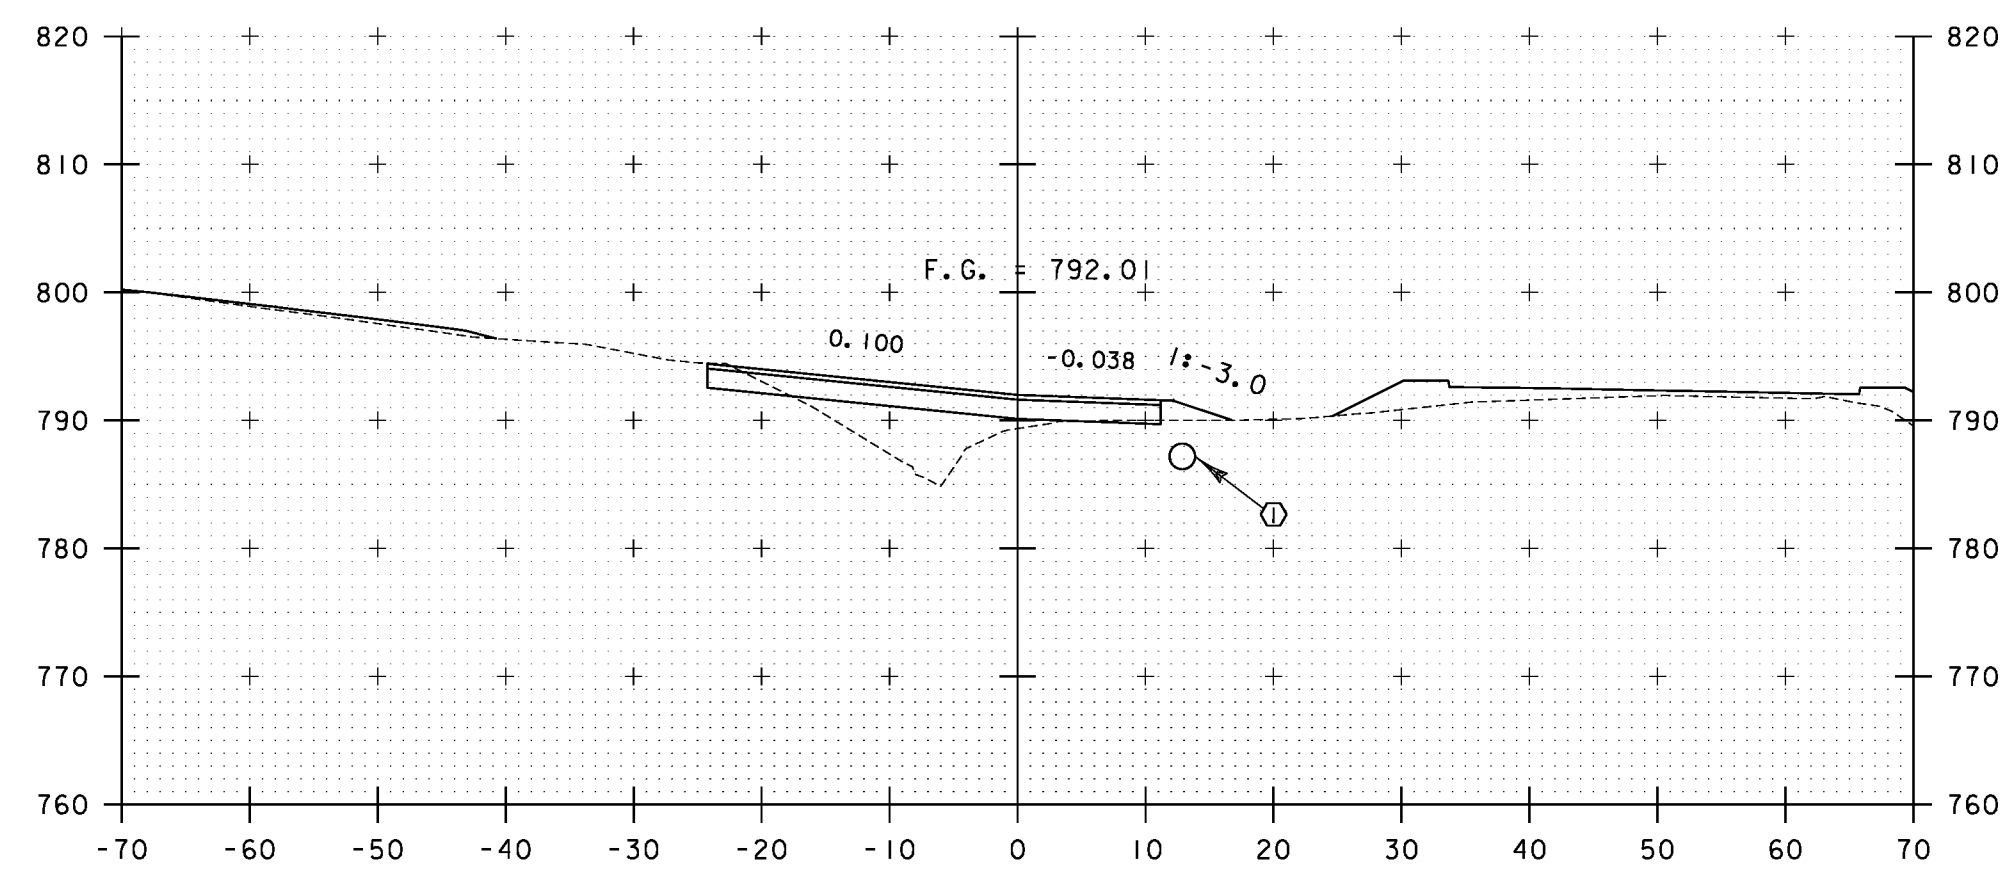

400+11
NOT CHANGED

400+50

STA. 400+00 TO STA. 400+75

PROJECT NAME:	VAOT PROJECT NAME
PROJECT NUMBER:	PROJECT NUMBER
FILE NAME:	pjms*/Section/-----dgn
PROJECT LEADER:	-----
DESIGNED BY:	-----
PLOT DATE:	####DATE###
DRAWN BY:	-----
CHECKED BY:	-----
SHEET	SS*# OF ST*#