


Cofferdam Rock
 Cofferdam Earth
 UNCLASSIFIED

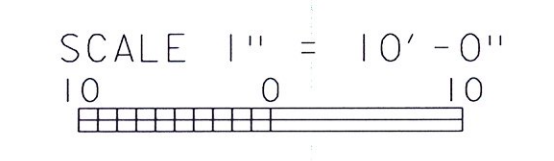

STA. ---+--- TO STA. ---+---

PROJECT NAME: WARREN	PLOT DATE: ****DATE***
PROJECT NUMBER: BRF 013-4(14)	DRAWN BY:
FILE NAME: s78f242xs.dgn	CHECKED BY: U. STANLEY
PROJECT LEADER: J. LACROIX	SHEET
DESIGNED BY: U. STANLEY	OF