
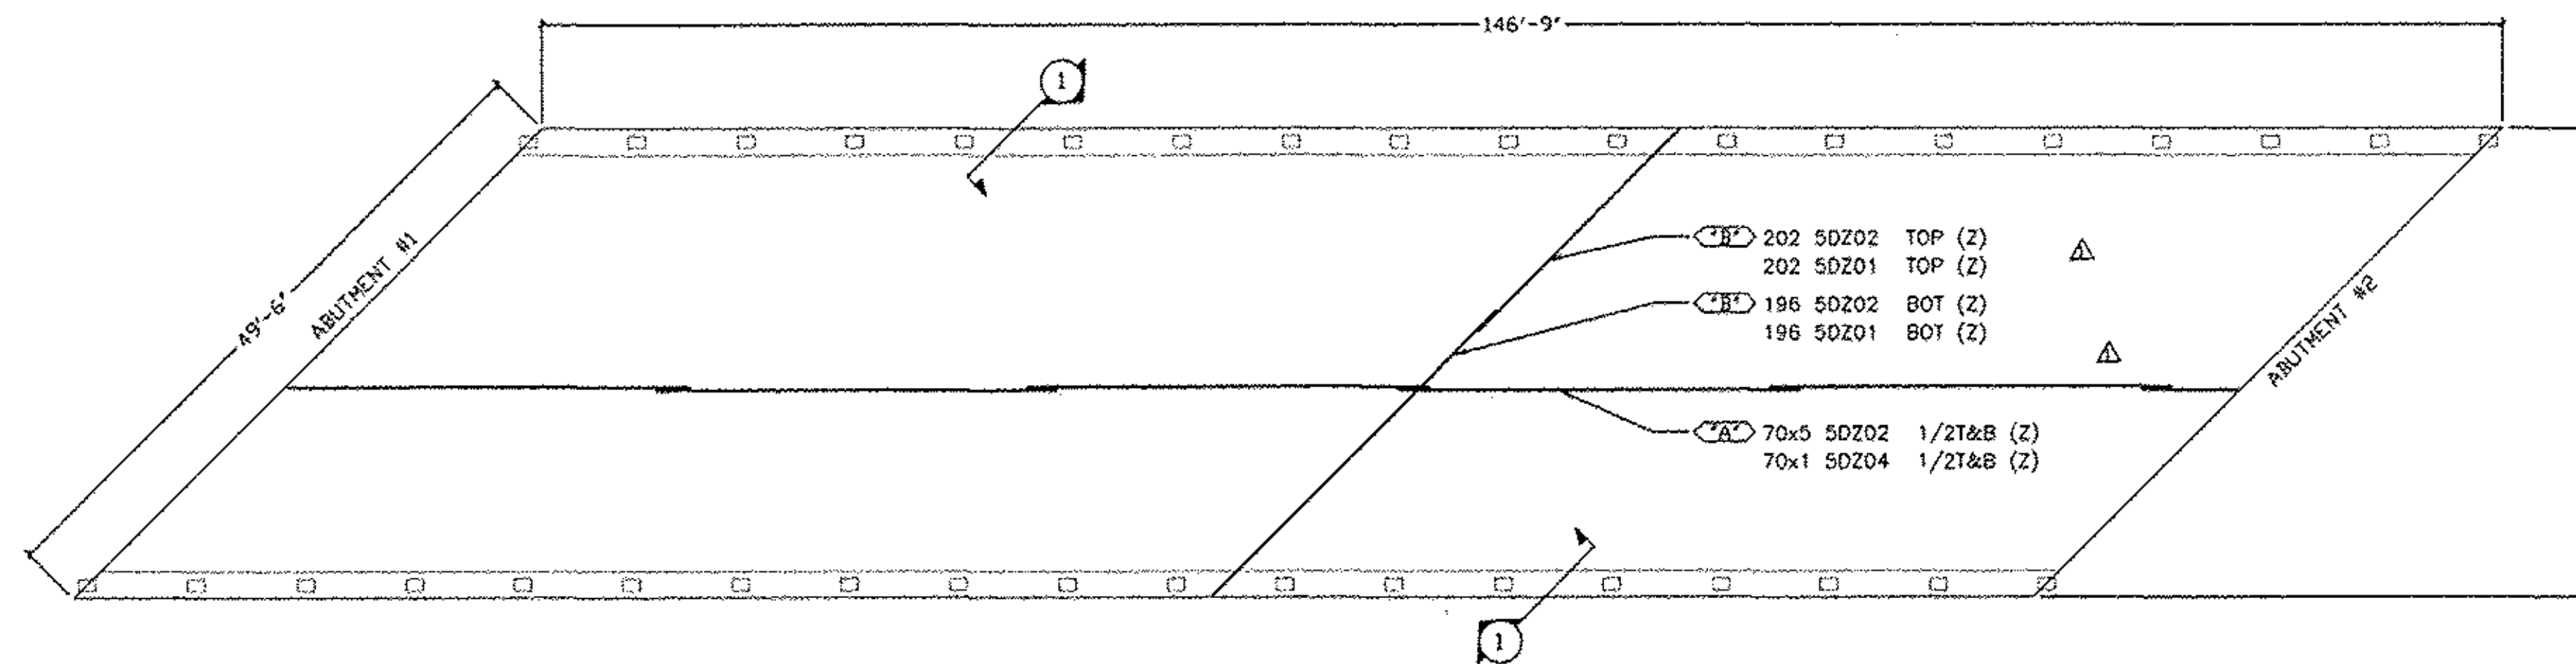


Release Number: 400				BEND SCHEDULE												
Bar Mark	Qty	Size	Total Length	Type	'A'	'B'	'C'	'D'	'E'	'F'	'G'	'H'	'I'	'K'	'O'	'R'
50Z02	778	#5	30'-0"			30'-0"										
50Z03	446	#5	4'-8"	SS	0'-6"	1'-0"	1'-8"	1'-0"			0'-6"					
50Z04	76	#5	7'-3"			7'-3"										
50Z01	398	#5	21'-4"			21'-4"										

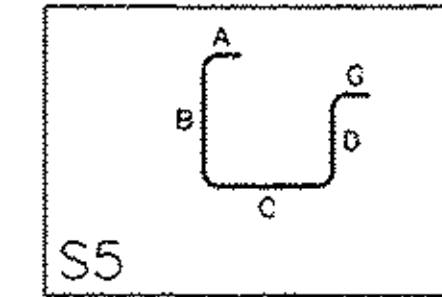

DECK SLAB AND CURB PLAN
CONTR. REF. PLAN/SHEET 49 OF 83

LEGENDS:
CONT-CONTINUOUS
TRANS-TRANSVERSE
DWLS-DOWELS
VERTS-VERTICAL
HORZ-HORIZONTAL
T&B -TOP & BOTTOM
IF-INNER FACE
OF-OUTER FACE
EF-EACH FACE
EW-EACH WAY
O.C.-ON CENTER
LW-LONG WAY
SW-SHORT WAY


NOTE: ALL REINFORCING ON THIS DRAWING IS DUAL COATED.

DUAL COATED BARS-ASTM A1055 (Z) BAR
DUAL COATED BAR DENTED (Z)


ELEVATIONS & DIMENSIONS SHOWN ON THIS DWG. ARE FOR REINF. DETAILING PURPOSES ONLY AND ARE NOT INTENDED FOR CONSTRUCTION.

DECK REINFORCING LAP
#5=2'-2"


FOR FIELD USE

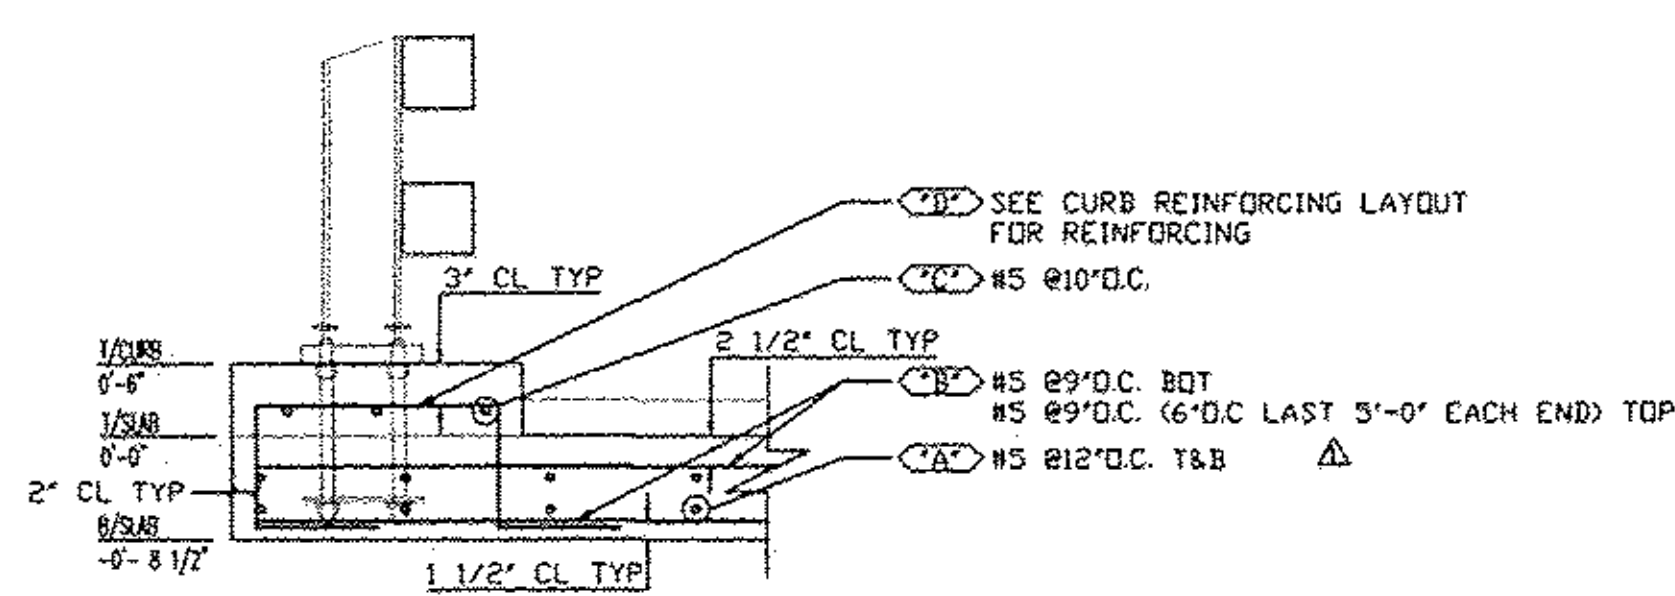

SECTION 1
REF. DECK CURB REINFORCING SECTION/ 57 OF 83
REF. ENLARGED VIEW OF DECK CROSS SECTION/ 64 OF 59

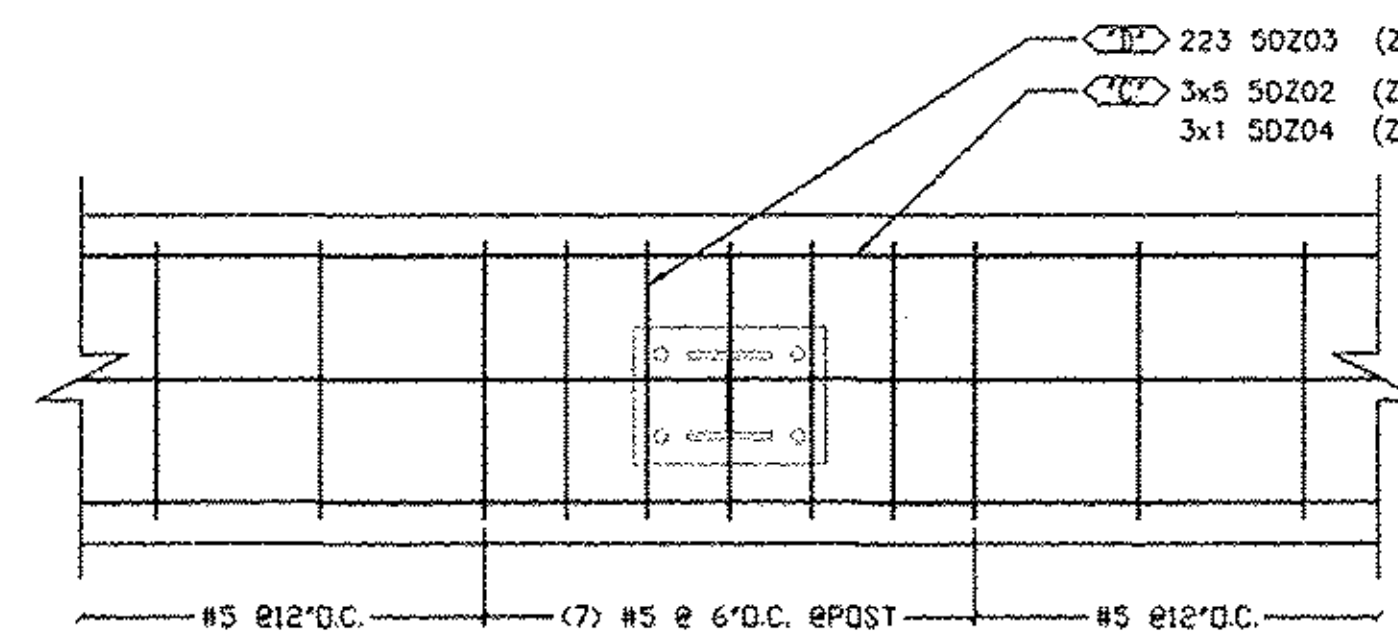

DECK CURB LAYOUT SIDE A
REF. DECK CURB REINFORCING LAYOUT PLAN DETAIL/ 57 OF 83

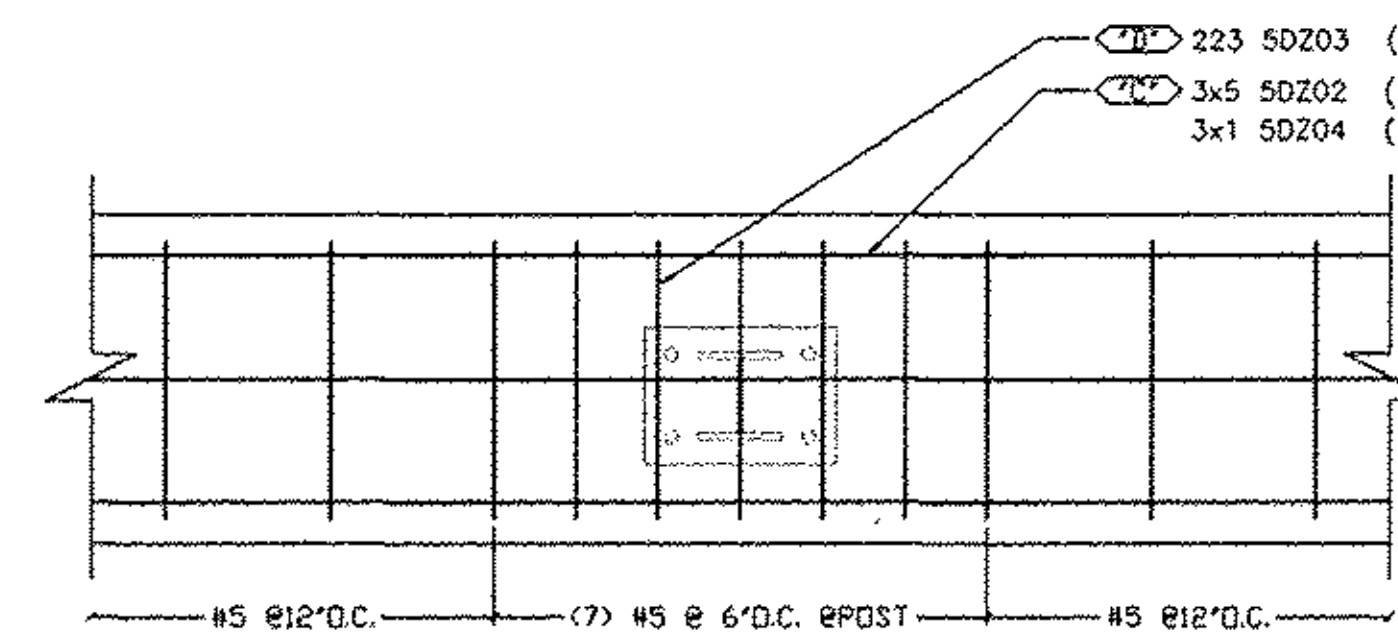

DECK CURB LAYOUT SIDE B
REF. DECK CURB REINFORCING LAYOUT PLAN DETAIL/ 57 OF 83

6			
5			
4			
3	6/19/13	DETAILER REVIEW FOR RECORD	
2	6/18/13	APPROVED AS NOTED FOR RECORD	
1	6/11/13	APPROVAL	
DATE	REV.#	SENT FOR	
DIMENSION			
DIMENSION FABRICATORS INC.			
VT/QT WARREN BR# 013-14(4)			
LOCATION	WARREN, VERMONT		
ARCHITECT	VERMONT AGENCY OF TRANSPORTATION		
ENGINEER	S.D. IRELAND CONCRETE CONSTR. GROUP		
DRAWN BY	DATE	QTY #	
ASHLEE G.	6/11/13	8387	
DECK SLAB AND DECK CURB REINFORCING	DRAWING #		D