

REMOVING & RESETTING CURB
 VT 30 433+64.4 ~ SA 2 16+55.4 (300 LF)
 VT 30 436+43.4 ~ VT 315 11+17.4 (148 LF)
 VT 315 11+65.4 ~ SA 2 16+40.4 (182 LF)

EXCAVATION & REMOVAL OF ROAD SURFACES & PAVEMENTS
 VT 30 433+6.5 LT ~ 435+15.4
 VT 30 433+55.4 ~ 436+40.4

CONSTRUCT SPECIAL DITCH
 VT 30 435+70.4 ~ 436+00.4

EROSTION MATINGS
 VT 30 435+70.4 ~ 436+00.4
 Paved Ditch



INDEX OF SHEETS

Sheet	Plan Quantity	Barriades	Approach	Signs, Major Maintenance	Signs, Minor Maintenance	Date
1	E-7					9-19-73 R
2	E-8					9-12-77 R
3	E-10					8-10-77 R
4-9	Grass Sections					

RECORD PLANS-MATERIAL SUPPLIERS

CONTRACTOR-STATE OF VERMONT, DISTRICT 1 RESIDENT ENGINEER-ALDEN GROUT RECORD PLANS-GEORGE J. ABRAHAM
 CONSTRUCTION BEGAN-14 JUNE 1978 COMPLETED-13 NOVEMBER 1978 ACCEPTED-6 DECEMBER 1978
 SUB-BASE OF CRUSHED GRAVEL-HAYES PIT, MANCHESTER, VT. SEED, FERTILIZER-LAFAYETTE-SHELDON INC., ESSEX JCT., VT.
 BITUMINOUS CONCRETE PAVEMENT-W. DAILEY, MANCHESTER, VT.

NOTE: ANY FURTHER INFORMATION CONCERNING FINAL QUANTITIES, AMOUNTS OR OTHER DETAILS RELATIVE TO THIS PROJECT MAY BE FOUND IN EITHER THE MEASUREMENT BOOKS OR THE ESTIMATE FILE.

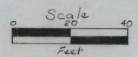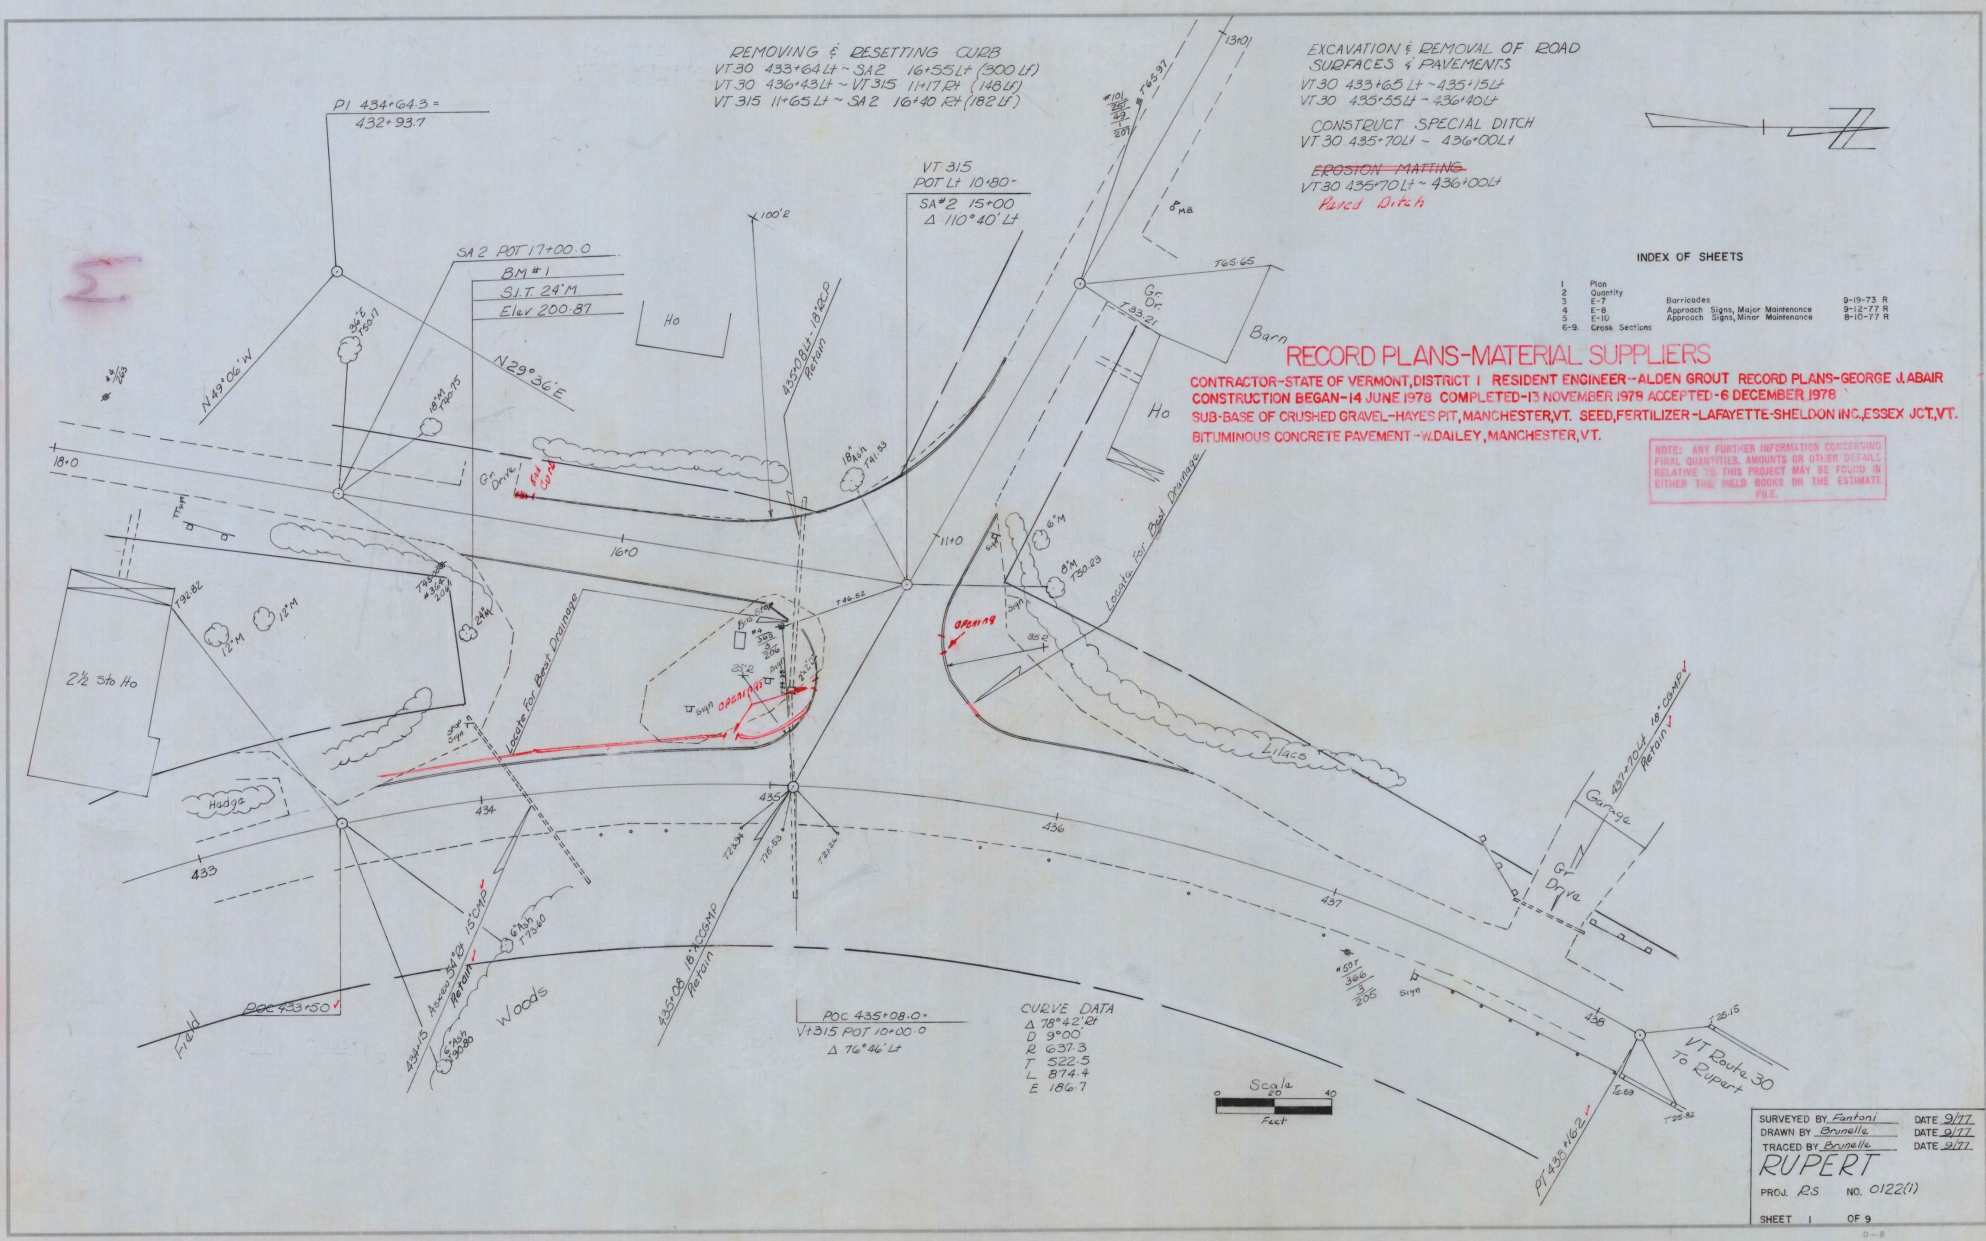


SURVEYED BY Fantoni DATE 9/77
 DRAWN BY Brunelle DATE 9/77
 TRACED BY Brunelle DATE 9/77
RUPERT
 PROJ. RS NO. 0122(1)
 SHEET 1 OF 9

DRAINAGE AND ITEM QUANTITY SHEET

STATE OF VERMONT DEPARTMENT OF HIGHWAYS
PROJECT RUPERT NO. RS 0122(1)


APPROXIMATE SUMMARY OF QUANTITIES					DETAILED SUMMARY OF QUANTITIES					DRAINAGE STRUCTURES																
BRIDGE	ROADWAY	GRAND TOTAL	UNIT	ITEM	ITEM NO.	QUANTITY	UNIT	ITEM	STA	POS	OLD	CULVERT	TYPE	ACCOMP	RCP	CRN	CONCRETE	DI	DEPTH	TRENCH	EXCAV	RELAY	ASKEW	DITCHES	REMARKS	
		19	CY	Excavation & Removal of Road Surfaces & Pavements	20215																					
		11	CY	Common Excavation	20315																					
		13	CY	Trench Excavation of Earth	20420																					
		60	CY	Subbase of Gravel	30115																					
		2.2	Ton	Bituminous Concrete Pavement	40625																					
		930	LF	Removing & Resetting Curb	61640																					
		12	Lb	Seed	65110																					
		100	Lb	Fertilizer	65115																					
		0.4	Ton	Agricultural Limestone	65120																					
		0.4	Ton	Hay Mulch	65125																					
		51	CY	Topsoil	65310																					
		13	SY	Erosion Matting	65420																					

PLANIMETERED SUB-BASE OF GRAVEL					GUIDE POSTS			TYPE OF CONSTRUCTION				LENGTH OF PROJECT							
STA	STA	DEPTH	EQUATIONS		STA	LT	RT	STA	LT	RT	STATIONS FROM TO	PAVEMENT WIDTHS	EQUATIONS + -	REMARKS	STA	STA	FEET	MILES	REMARKS
															10+00	17+00			

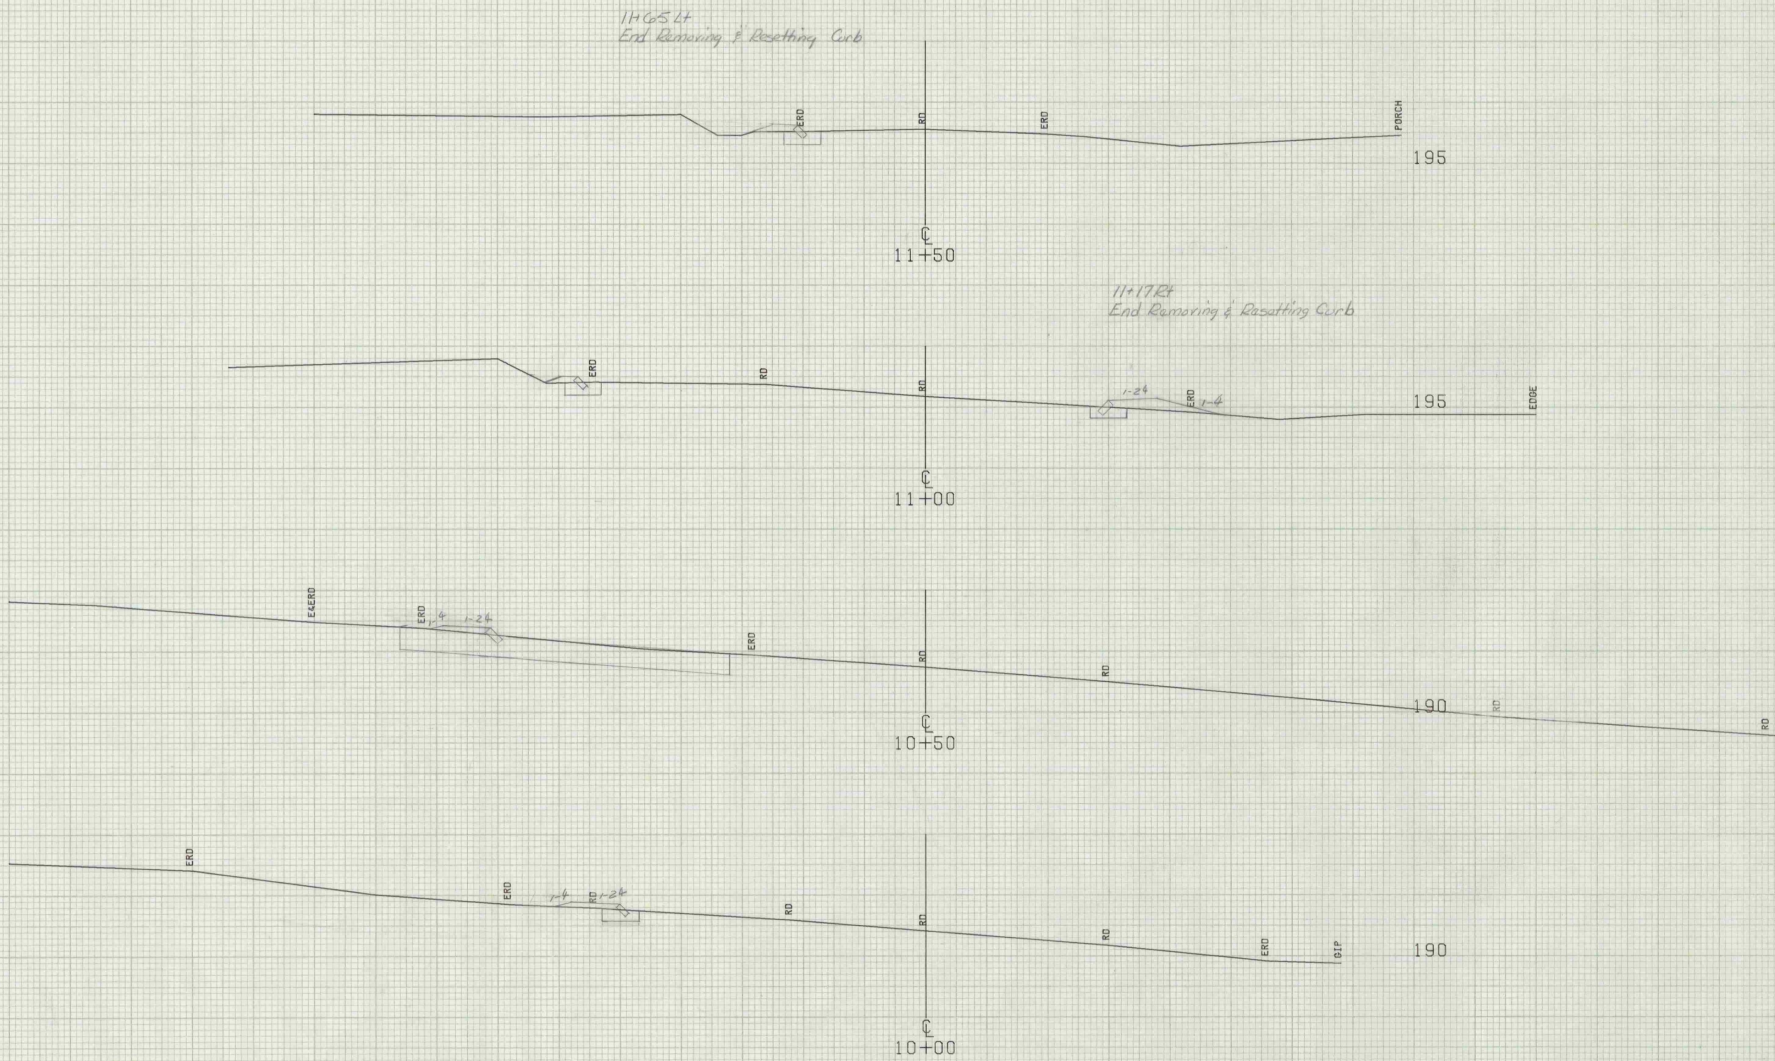


SCALE 1" = 6 FEET

FROM STA. 10+00	TO STA. 11+50
PROJECT NAME	RUPERT VT. RTE. 315
NO. R80122(1)	PLOTTED 09/12/77
SURVEYED BY FANTONI	SEPT. 1977
SHEET 6 OF 9 SHEETS	

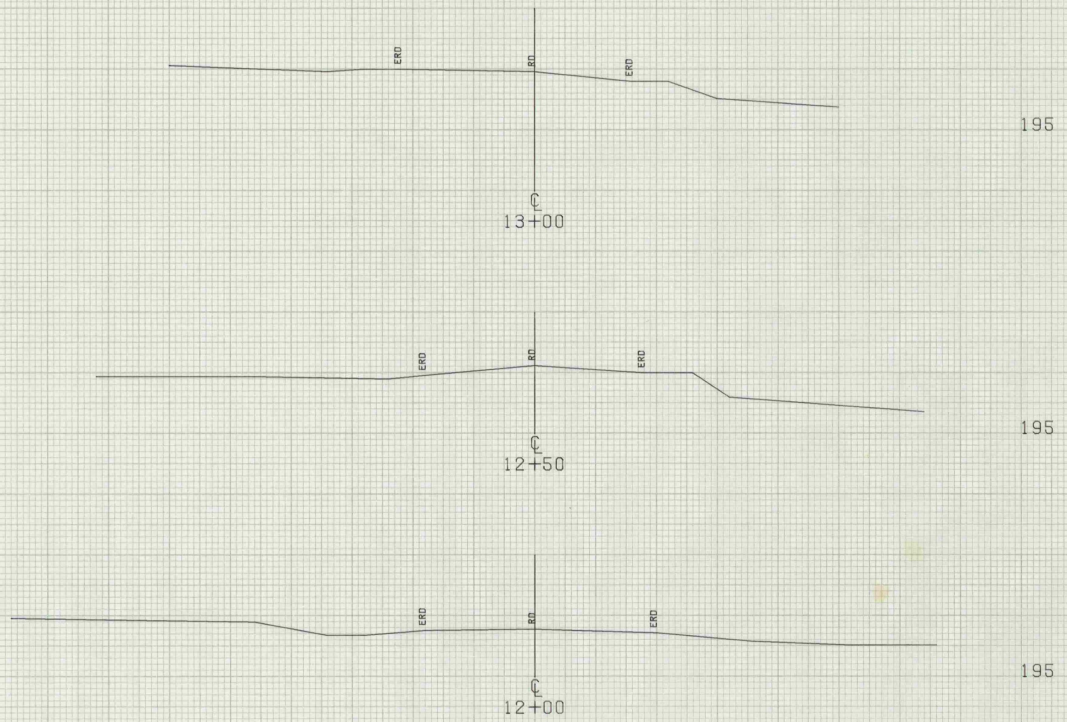

SCALE 1" = 4 FEET

FROM STA. 12+00	TO STA. 13+00
PROJECT NAME RUPERT VT. RTE. 316	
NO. R80122(1)	PLOTTED 09/12/77
SURVEYED BY FANTONI	SEPT. 1977
SHEET 7 OF 9	SHEETS

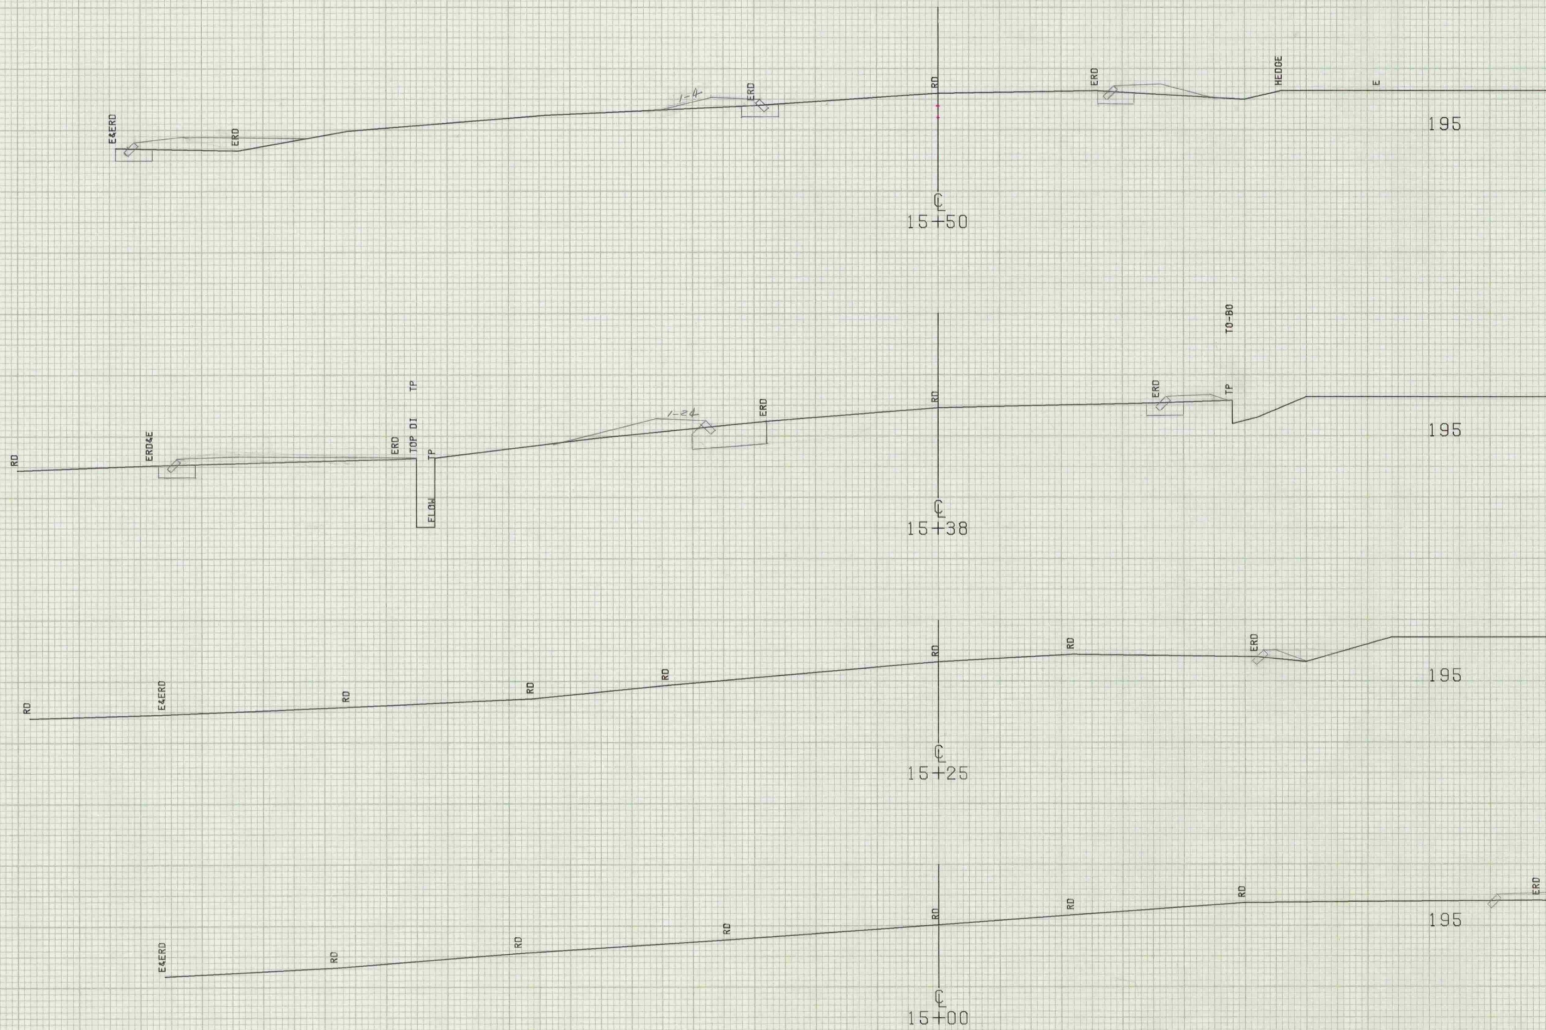

SCALE 1" = 4 FEET

FROM STA. 15+00	TO STA. 16+50
PROJECT NAME RUPERT TH#2	PLOTTED 09/12/77
NO. R80122(1)	SEPT. 1977
SURVEYED BY FANTONI	
SHEET 2 OF 9	SHEETS



SCALE 1" = 4 FEET

FROM STA. 16+00	RUPERT	TO STA. 17+00
PROJECT NAME	RSD122(1)	TH#2
NO.	FANTONI	PLOTTED 09/12/77
SURVEYED BY	FANTONI	SEPT. 1977
SHEET 9	OF 9	SHEETS

1978

Rupert
RS 0122(1)

8791

Vermont Agency of
Transportation
PHASE 3-INTERSTATE
INITIALS
BOX 3468
DONE