


# PROJECT DESCRIPTION AND LOCATION

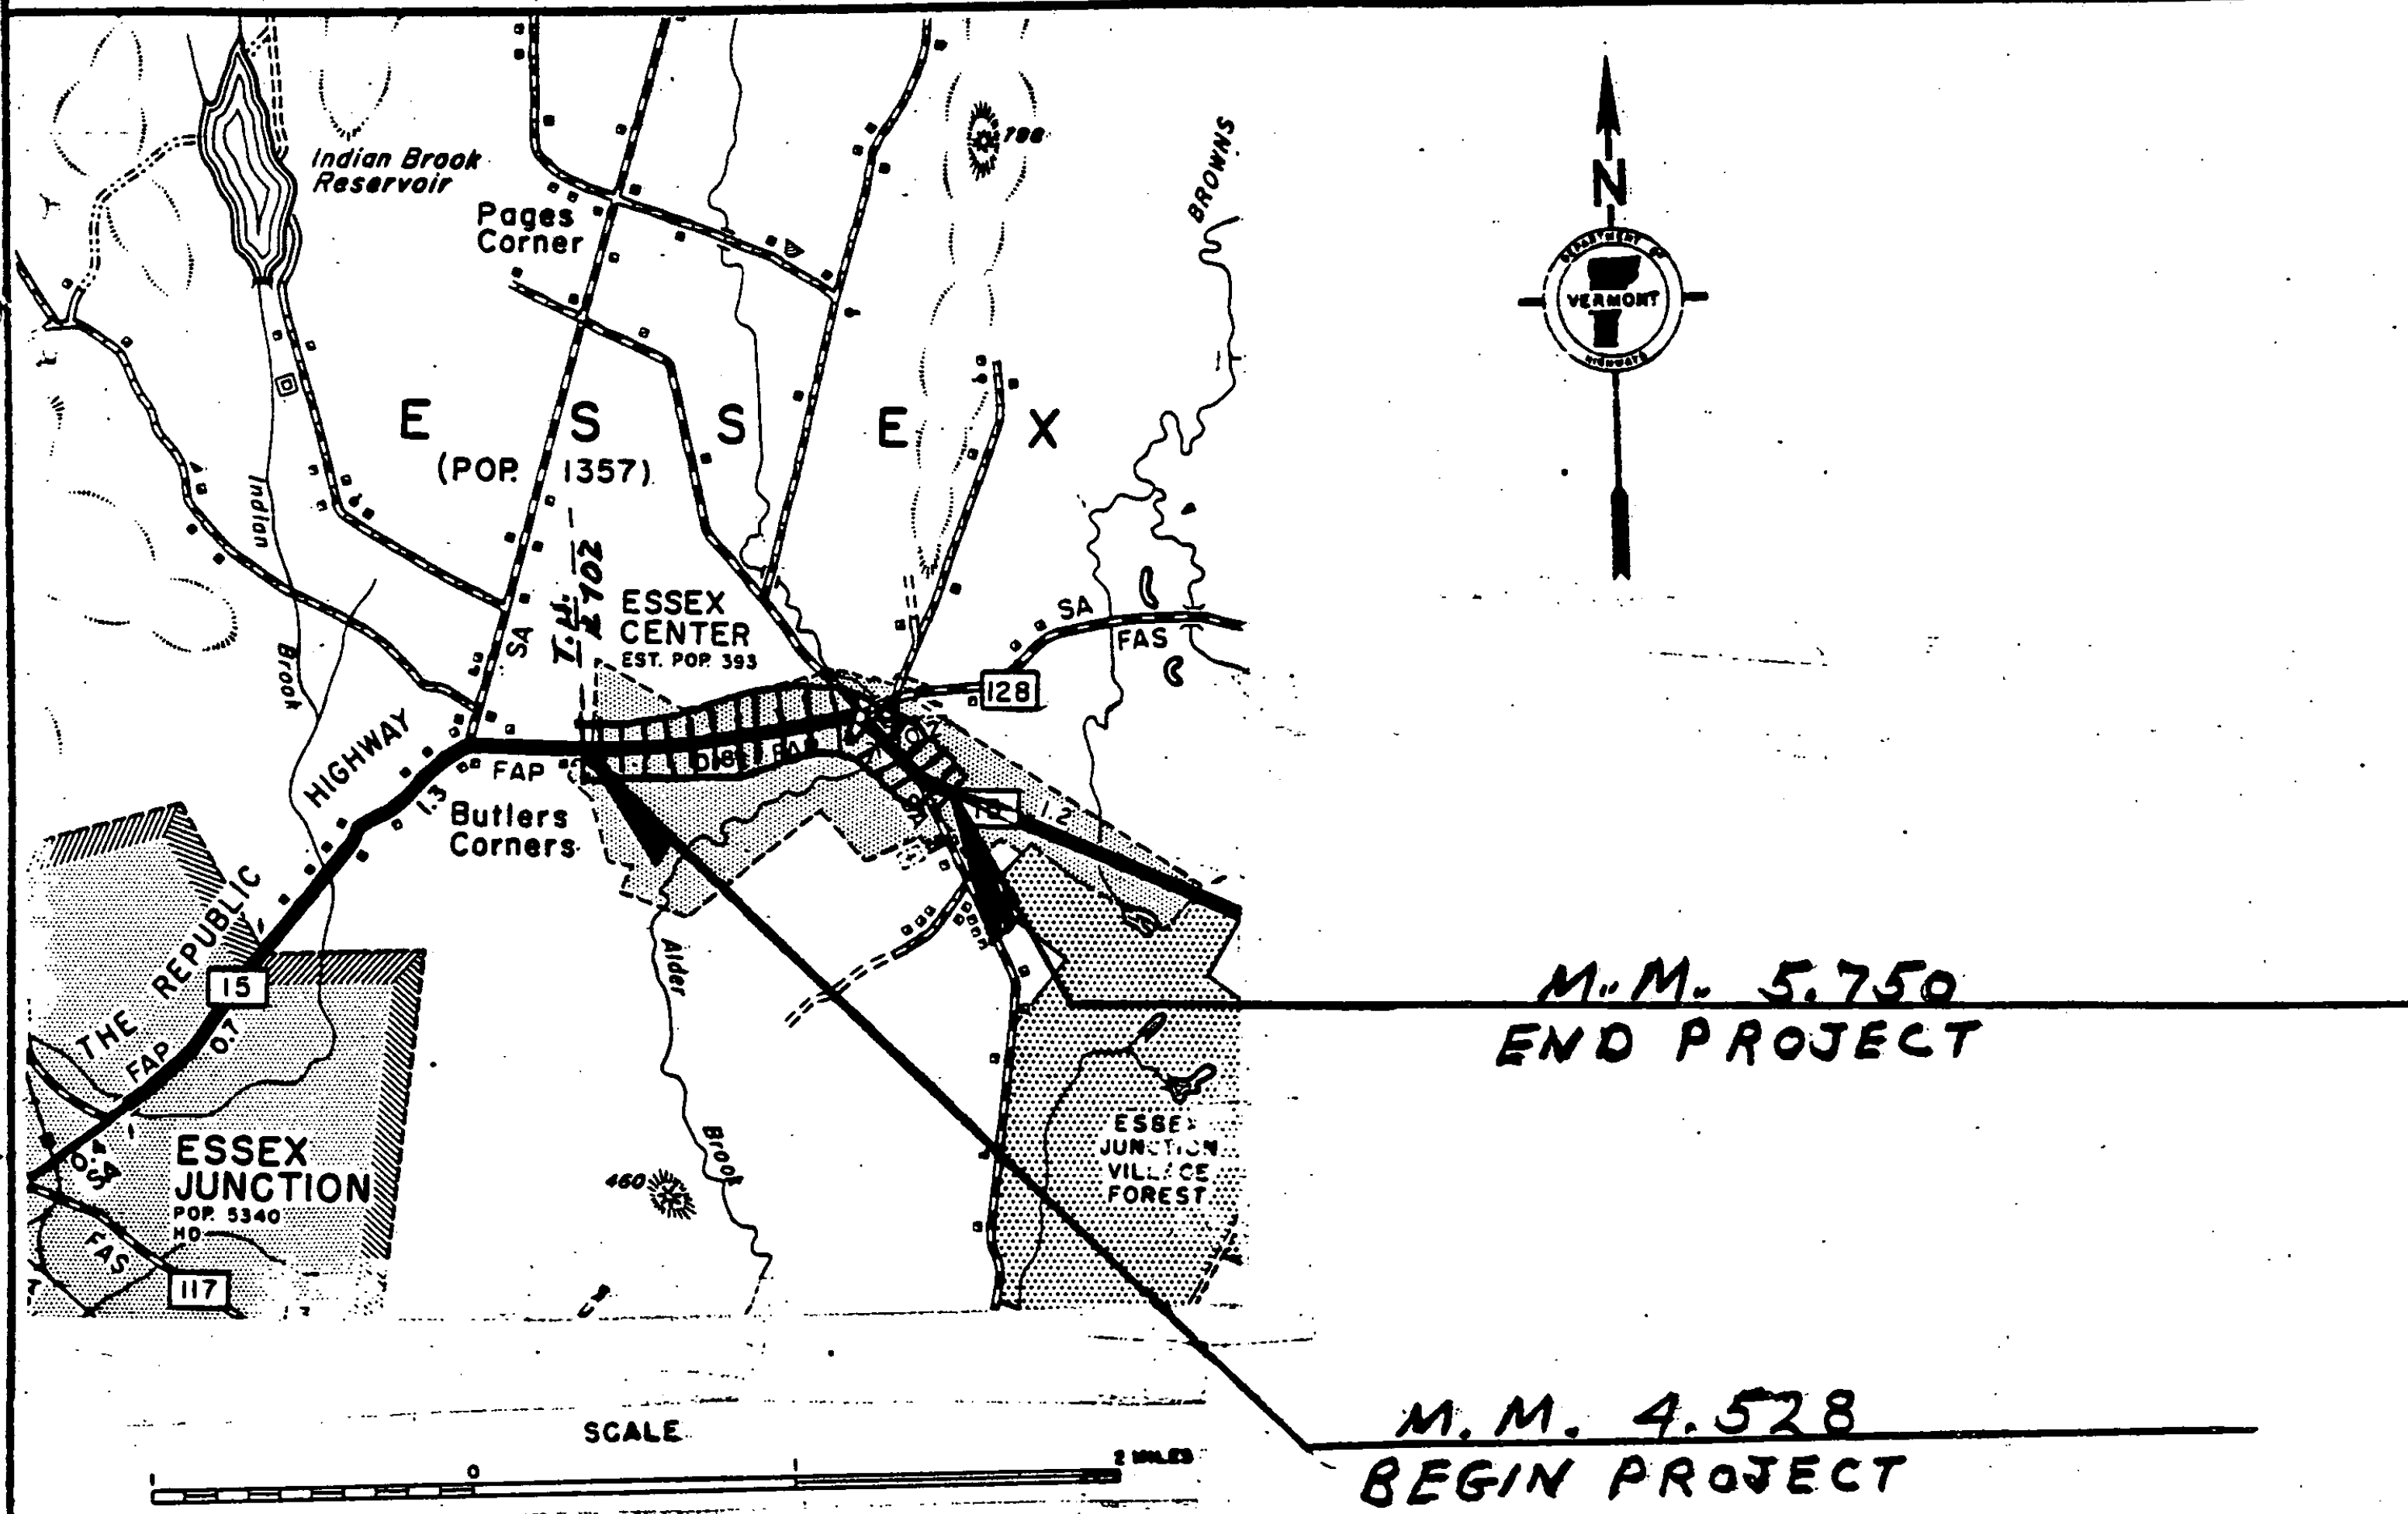

BEGINNING IN THE TOWN OF ESSEX ON VT. RT. 15 AT M.M. 4.528 - THE  
 INTERSECTION OF TH#702 - AND EXTENDING EASTERLY 1.222 MILES TO  
 M.M. 5.750 - 0.148 MILES EAST OF TH #4

LENGTH OF PROJECT 1.222 MI. = 6451 FEET

PROJECT ESSEX

NO. F-EGC-F 030-102)S

SHEET 2 OF 4 SHEETS