



TYPICAL SECTIONS & DESIGN DATA

WEARING COURSE 1½" BITUMINOUS CONCRETE PAVEMENT TYPE III, ITEM 406.25
 LEVELING COURSE BITUMINOUS CONCRETE PAVEMENT TYPE III OR IV AT 300 TON/MI.*

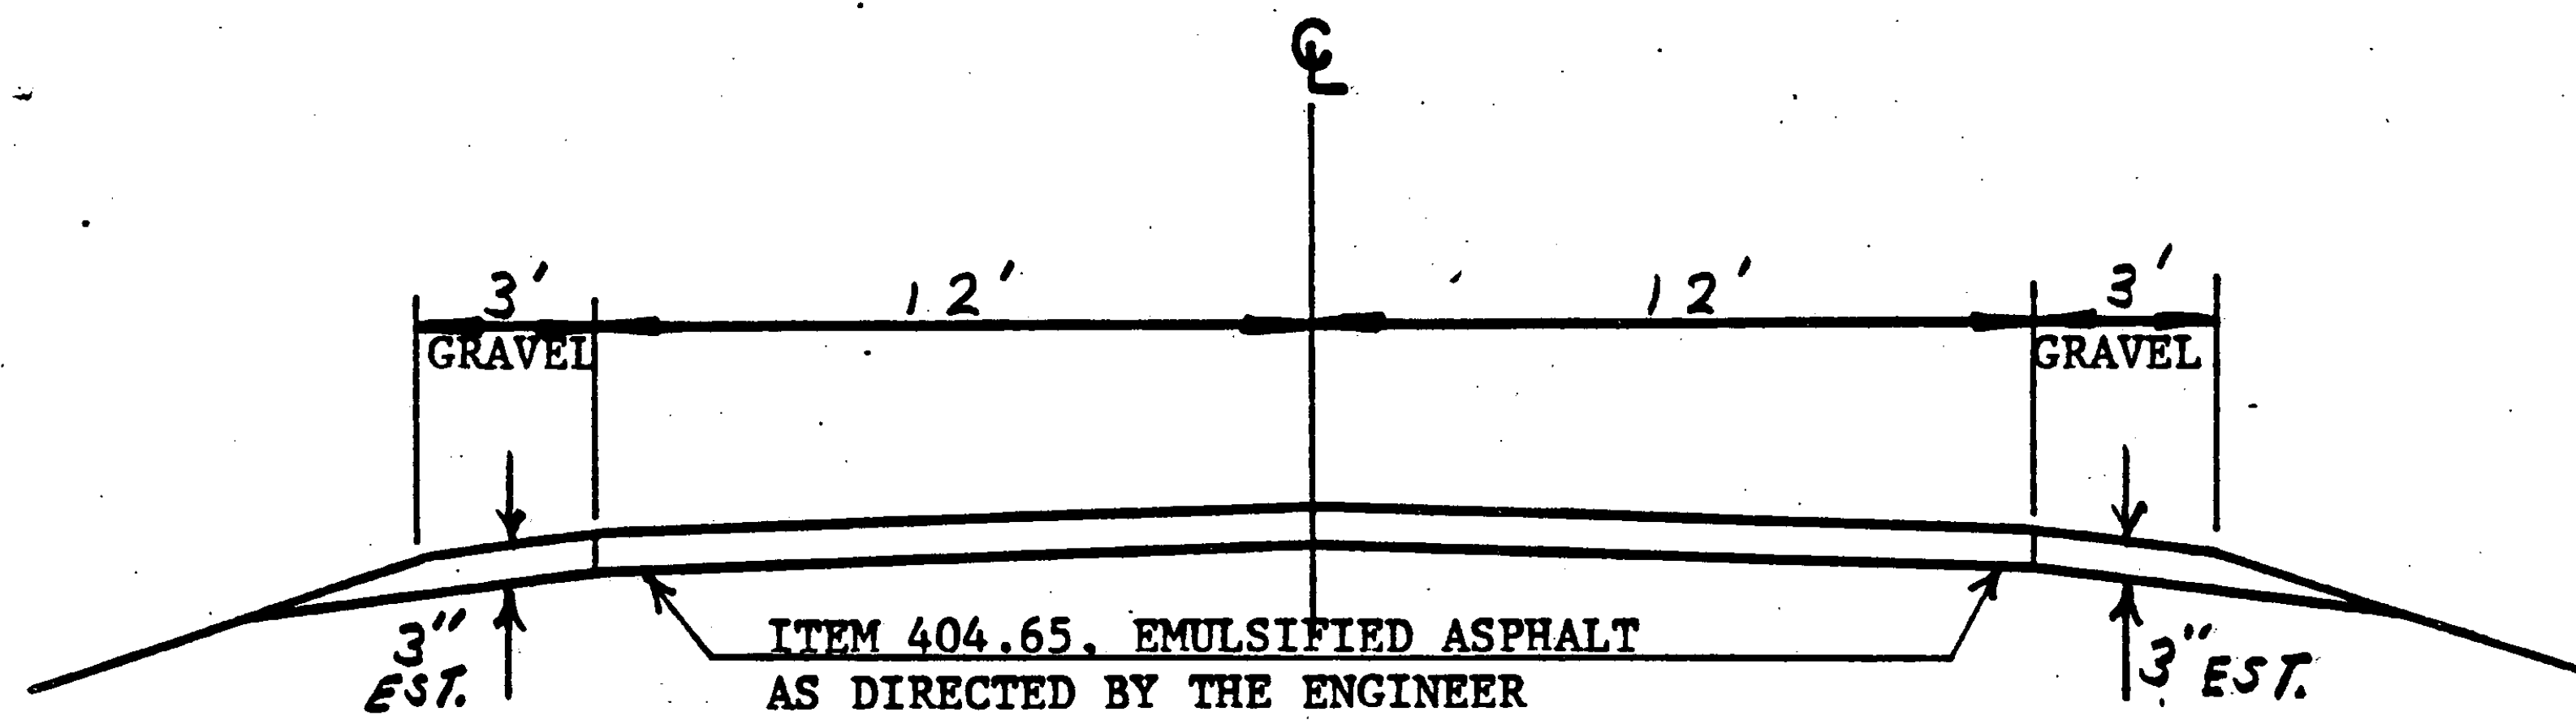

TYPICAL SECTION FOR M.M. 4.528 TO M.M. 5.268
 M.M. 5.340 TO M.M. 5.416
 M.M. 5.506 TO M.M. 5.750

WEARING COURSE 1½" BITUMINOUS CONCRETE PAVEMENT TYPE III, ITEM 406.25
 LEVELING COURSE BITUMINOUS CONCRETE PAVEMENT TYPE III OR IV AT 300 TON/ MI.*

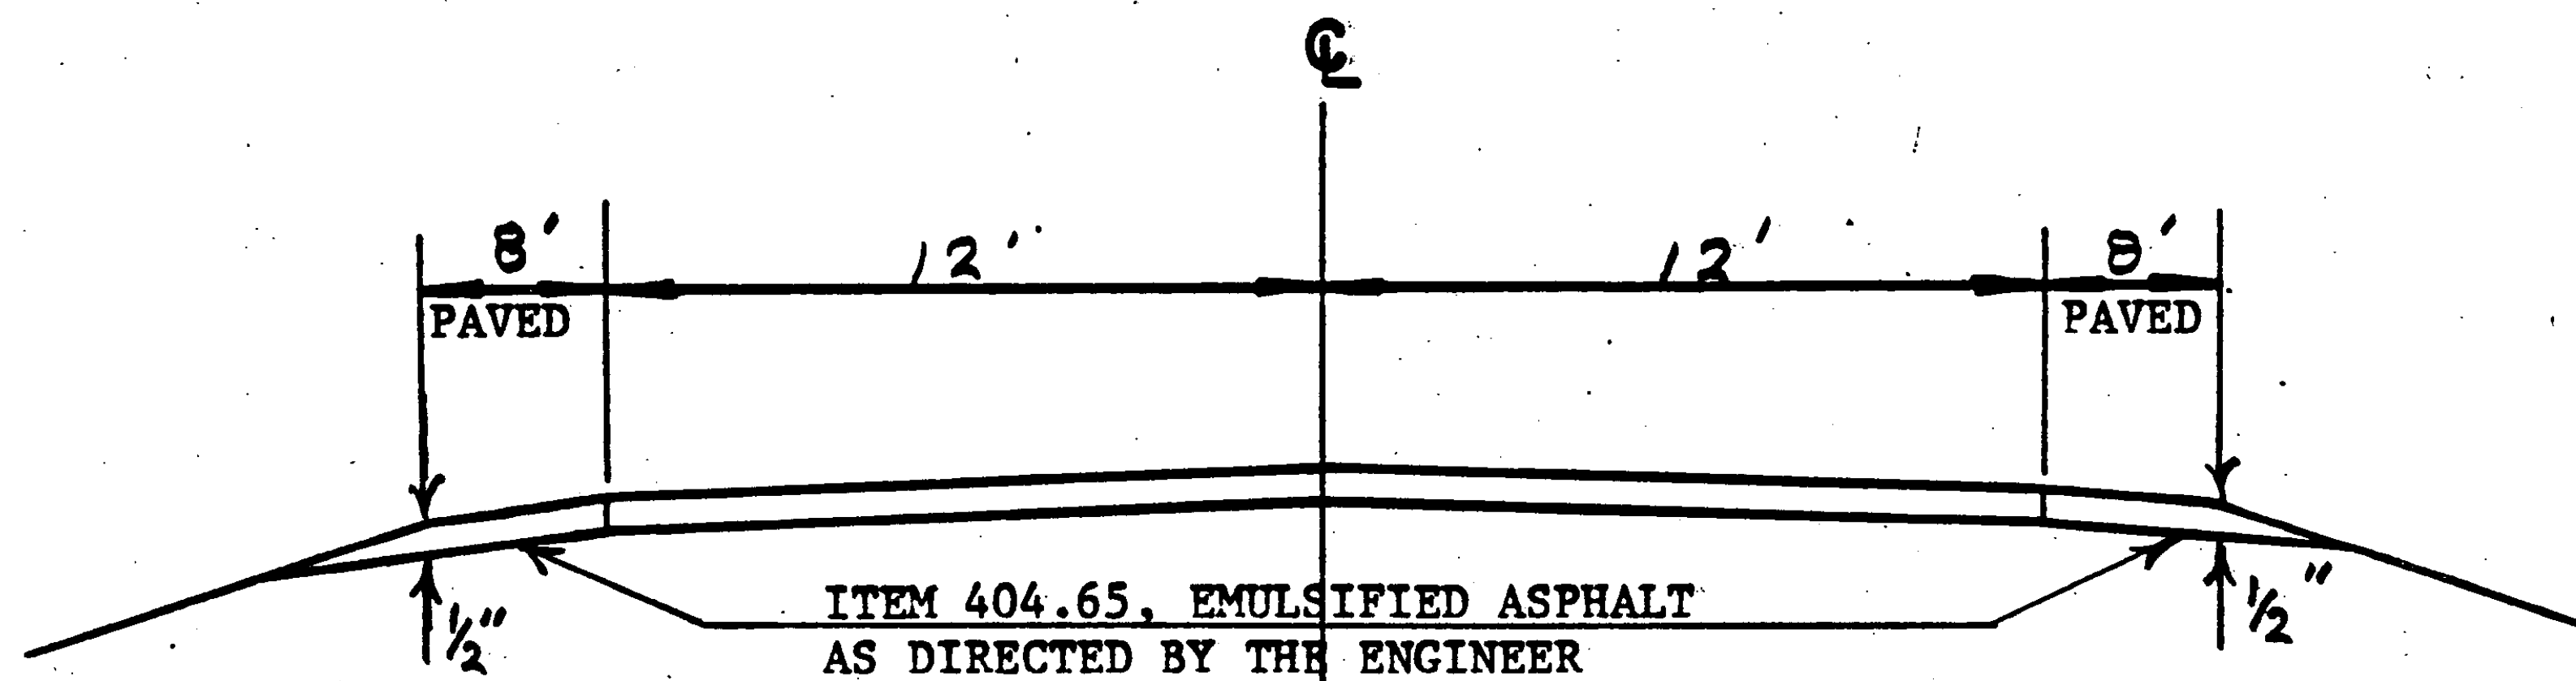

TYPICAL SECTION FOR M.M. 5.416 TO M.M. 5.506

* LEVELING COURSE BASED ON 22' WIDTH - FACTORED FOR ACTUAL WIDTH

EST. 1982 ADT = 8600
 V = 40 MPH

PROJECT ESSEX

NO. F-EGC-F 030-102)S
 SHEET 3 OF 14