


TYPICAL SECTIONS & DESIGN DATA

WEARING COURSE 1" BITUMINOUS CONCRETE PAVEMENT TYPE III, ITEM 406.25
NO LEVELING COURSE

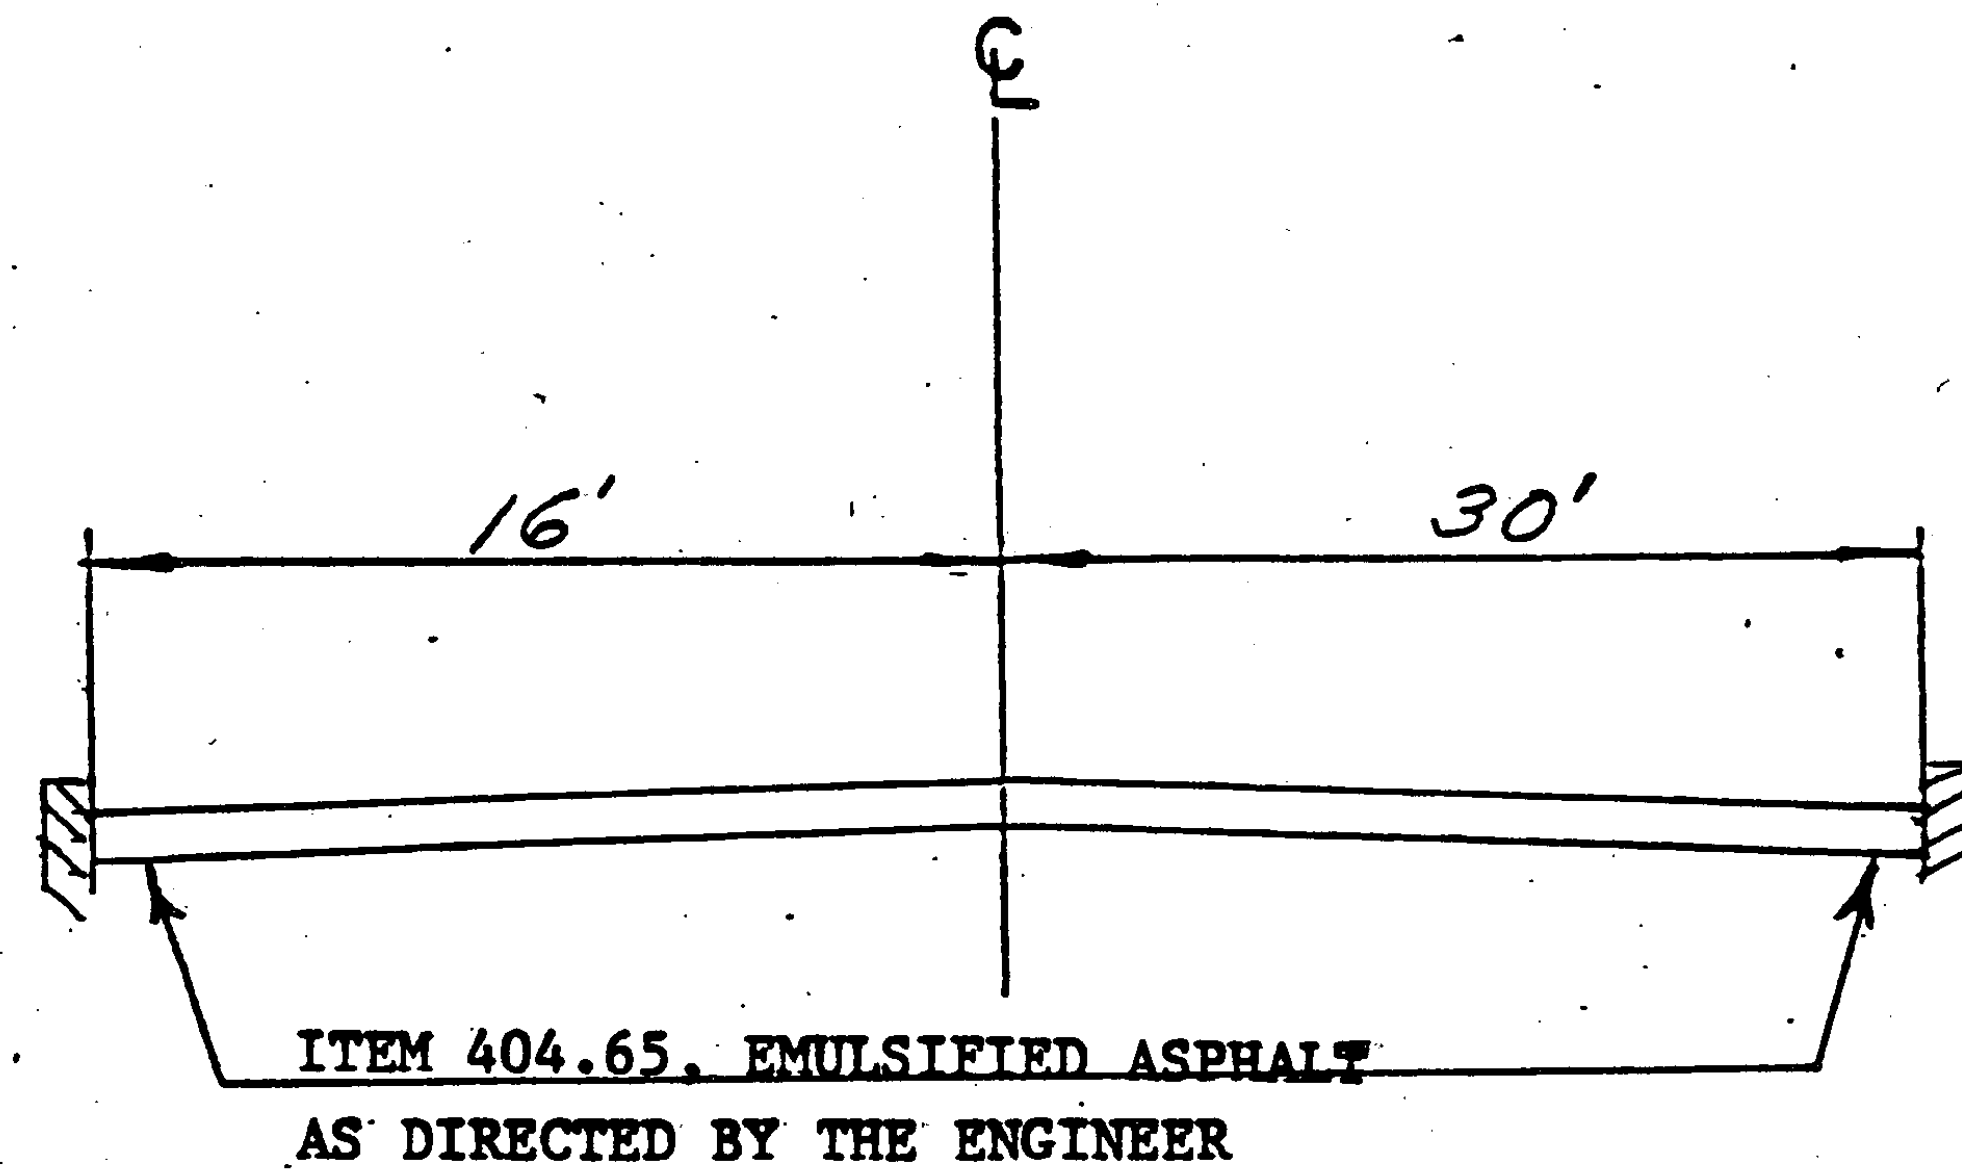

TYPICAL SECTION FOR M.M. 5.268 TO M.M. 5.340

PROJECT ESSEX

NO. F-EGC-F 030-H12S

SHEET 3-A OF 11 SHEETS