


PROJECT DESCRIPTION AND LOCATION

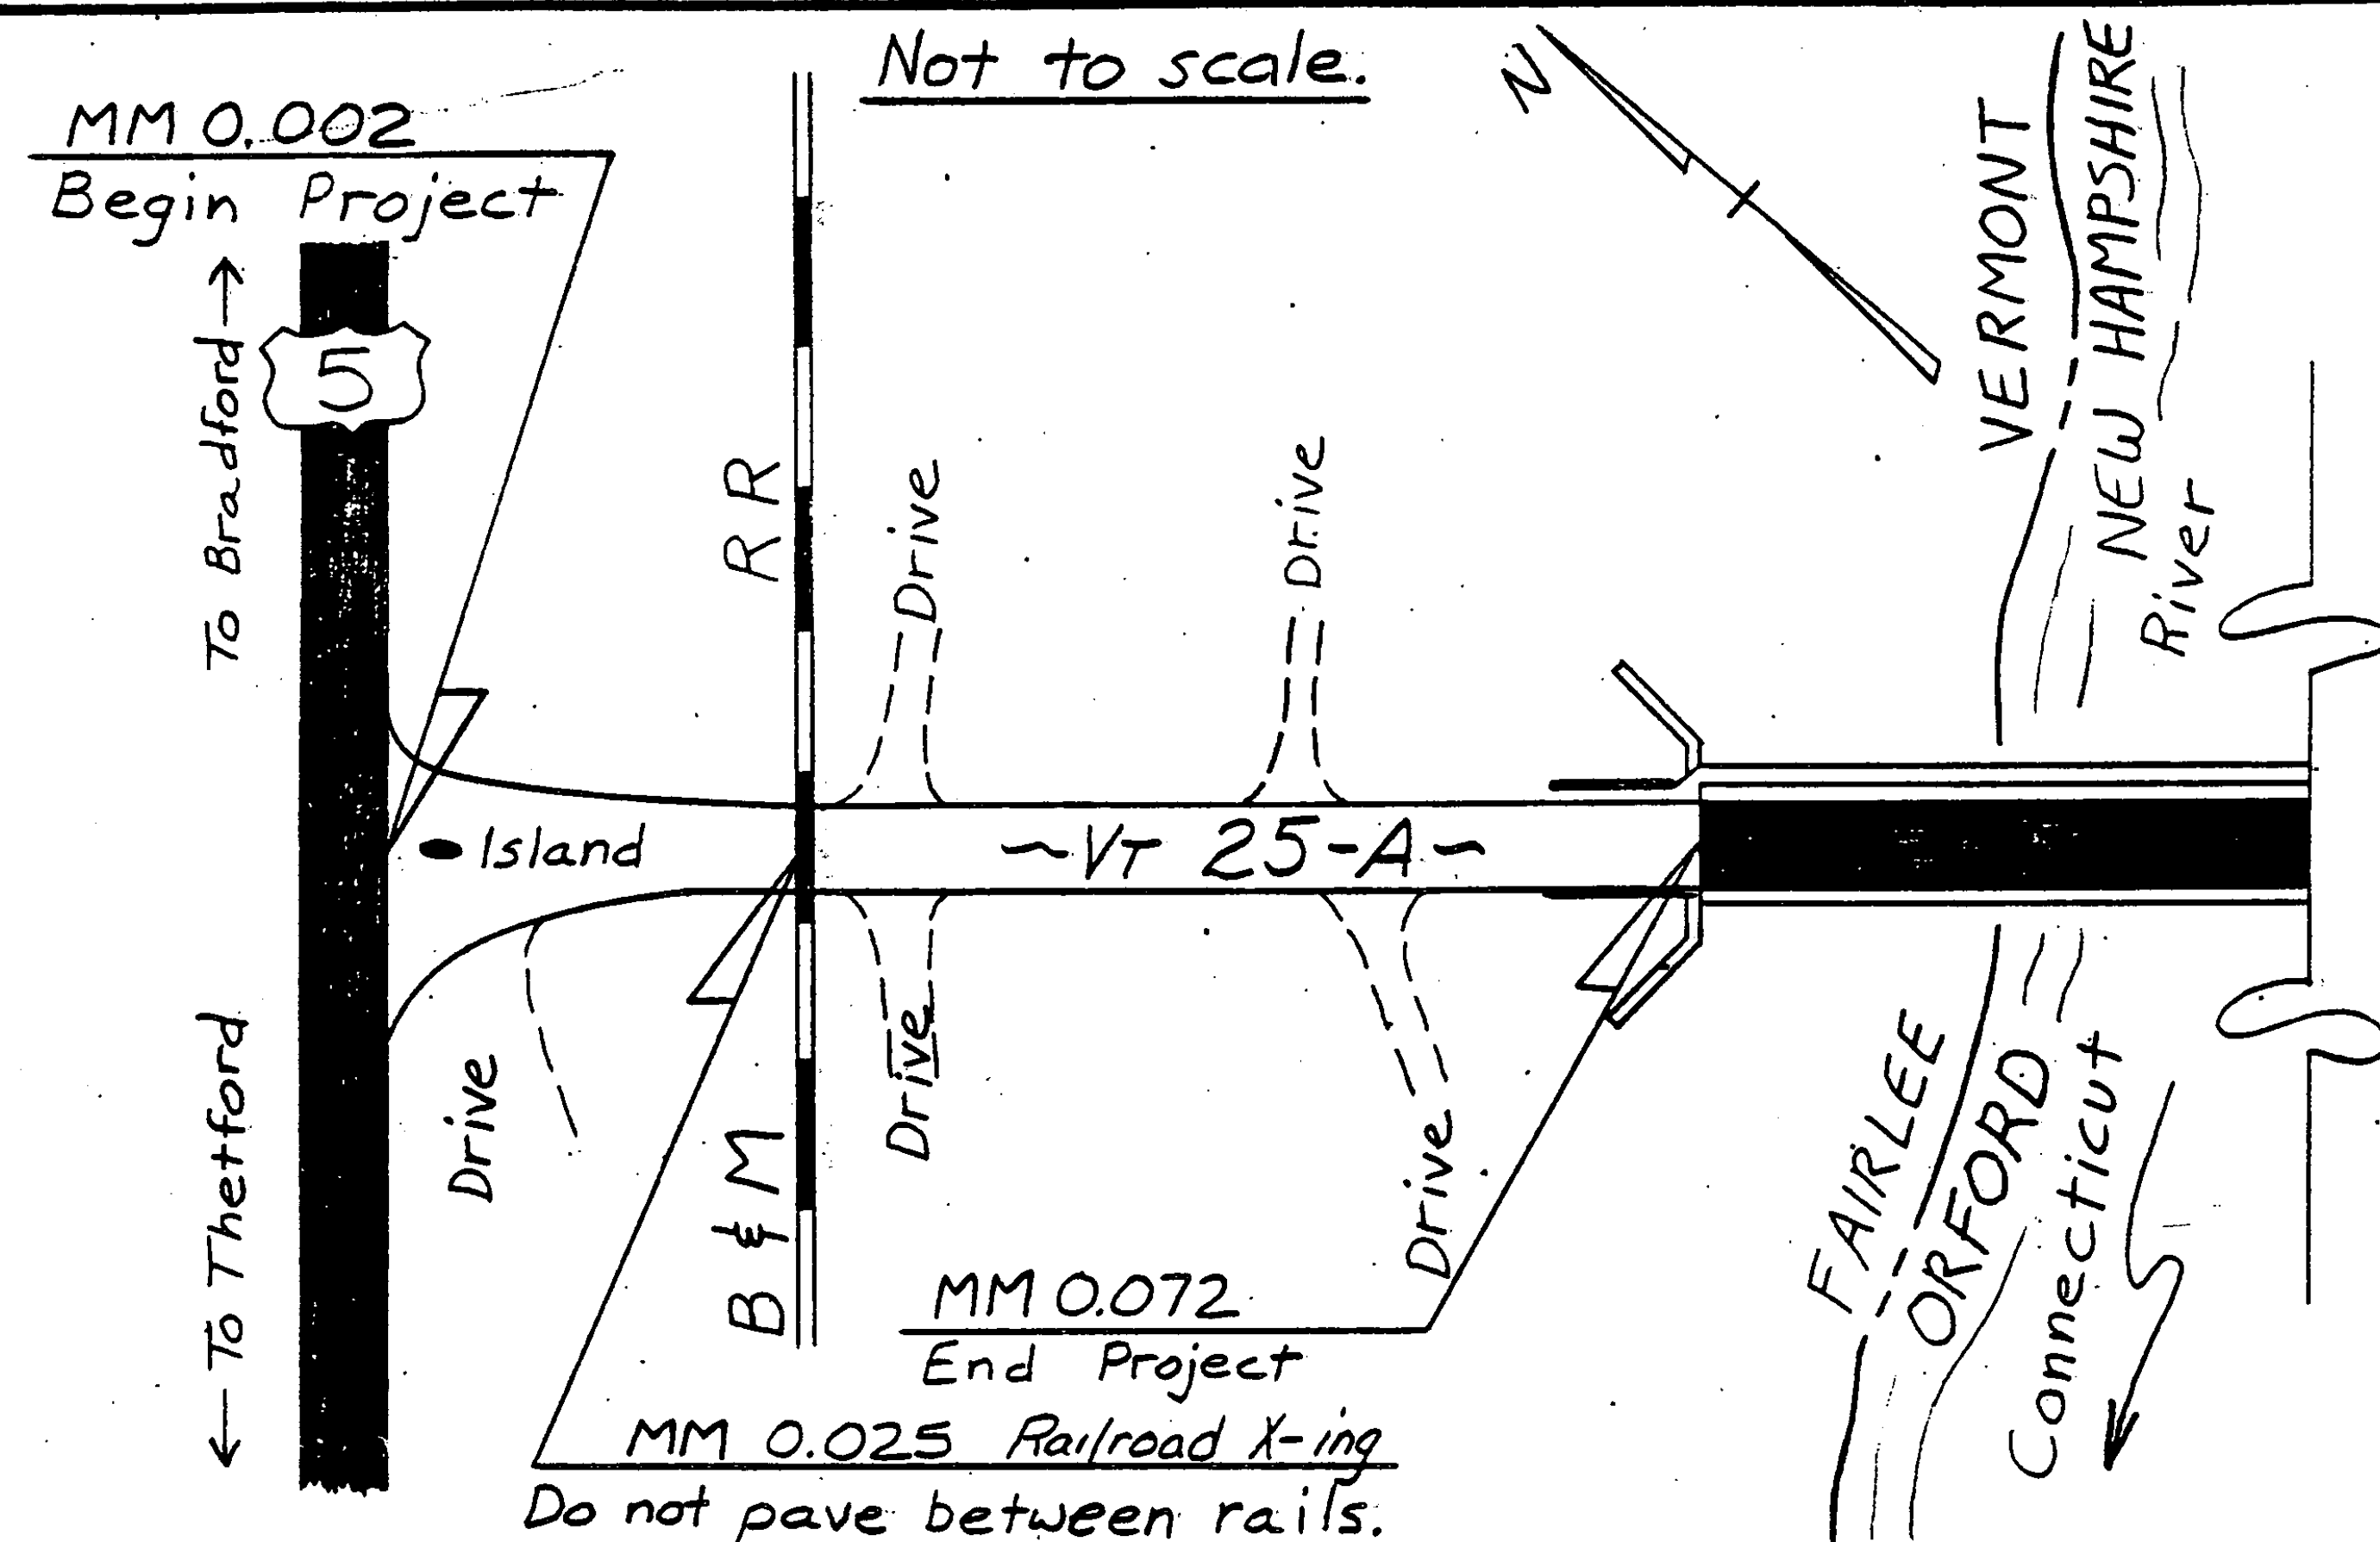

PROJECT LOCATION: Beginning in the Town of Fairlee at MM 0.002, the intersection of U.S. Rte 5 with Vt 25-A, and extending easterly 0.070 miles to MM 0.072 at the western end of the bridge over the Connecticut River.

PROJECT LENGTH: 0.070 miles (368 ft.)

PROJECT DESCRIPTION: Resurface with a leveling course and $\frac{3}{4}$ " bituminous concrete overlay.

TRAFFIC DATA: 1984 AADT = 2910
V = 35 MPH

PROJECT FAIRLEE

NO. F 040-1(1)S

SHEET 4 OF 23 SHEETS