


PROJECT DESCRIPTION AND LOCATION

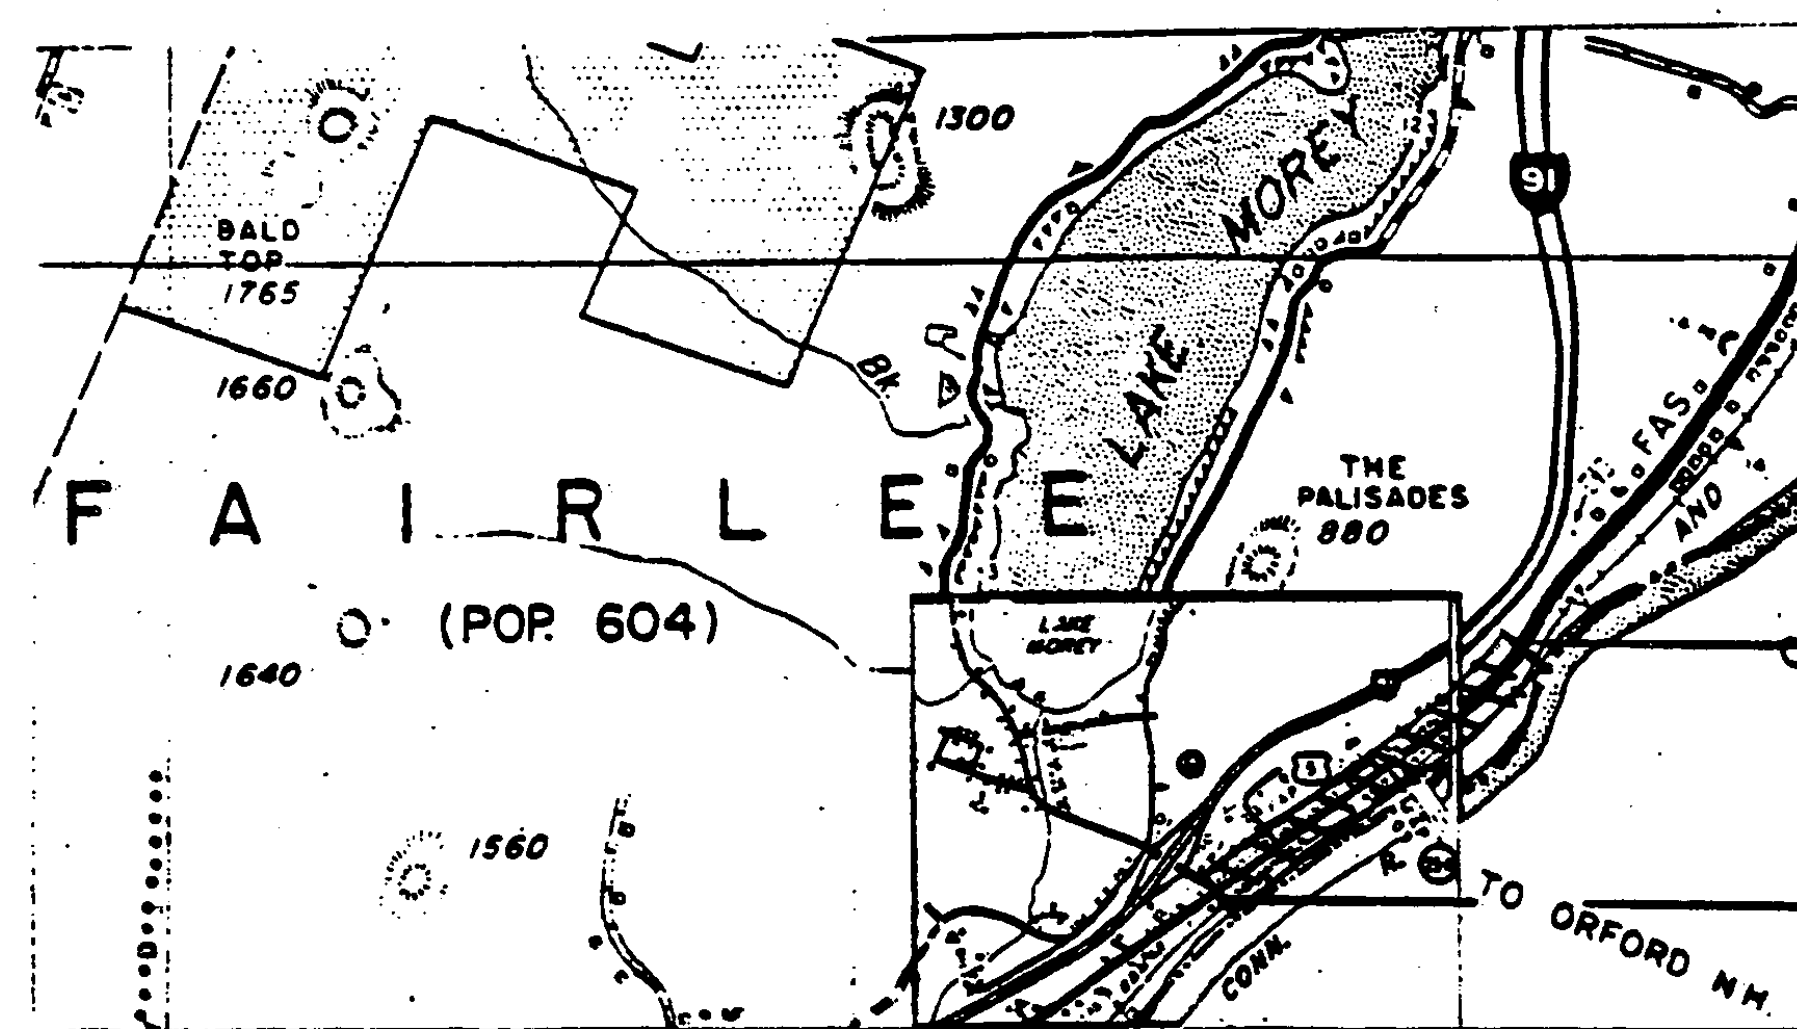

END PROJECT
MM 3.860

BEGIN PROJECT
MM 2.709

1977

BEGINNING ON U.S. RTE. 5 IN THE TOWN OF FAIRLEE,
2.709 MILES NORTH OF THE THETFORD-FAIRLEE TOWN
LINE, THENCE CONTINUING NORTH ON U.S. RTE. 5,
1.151 MILES, TO MM 3.860.

LENGTH OF PROJECT: 6076 FT.
1.151 mi.

TRAFFIC DATA

1982 ADT = 2530

V = 35 MPH

PROJECT FAIRLEE

NO. HMA 2524

SHEET 2 OF 23 SHEETS