



TYPICAL SECTIONS & DESIGN DATA

ITEM 406.25 BITUMINOUS CONCRETE PAVEMENT
 LEVELING COURSE, TYPE III OR IV (24' WIDE @ 164 TON/Mi.)
 AS DIRECTED BY THE ENGINEER
 1" WEARING COURSE ($\pm \frac{1}{4}$ ") TYPE III

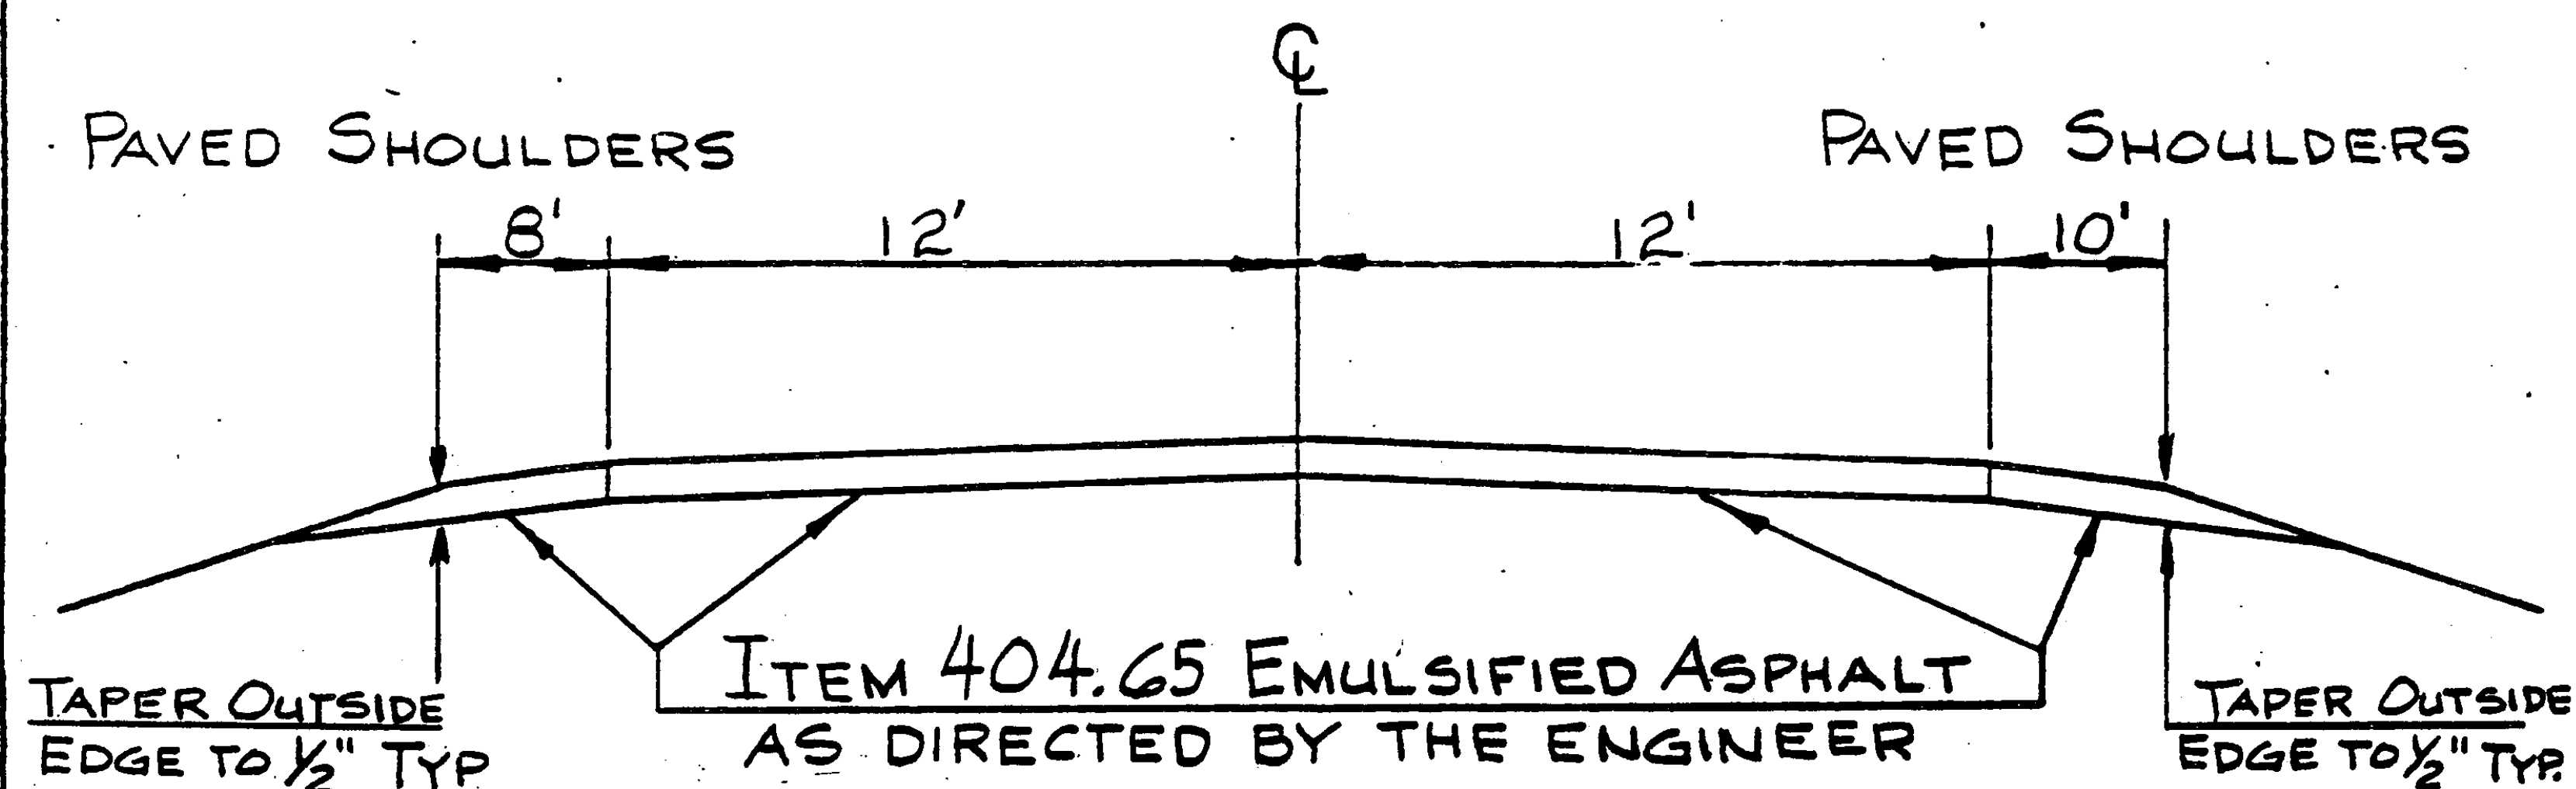

FAIRLEE MM 2.709 ~ MM 3.35

ITEM 406.25 BITUMINOUS CONCRETE PAVEMENT
 LEVELING COURSE, TYPE III OR IV (24' WIDE @ 164 TON/Mi.)
 AS DIRECTED BY THE ENGINEER
 1" WEARING COURSE ($\pm \frac{1}{4}$ ") TYPE III

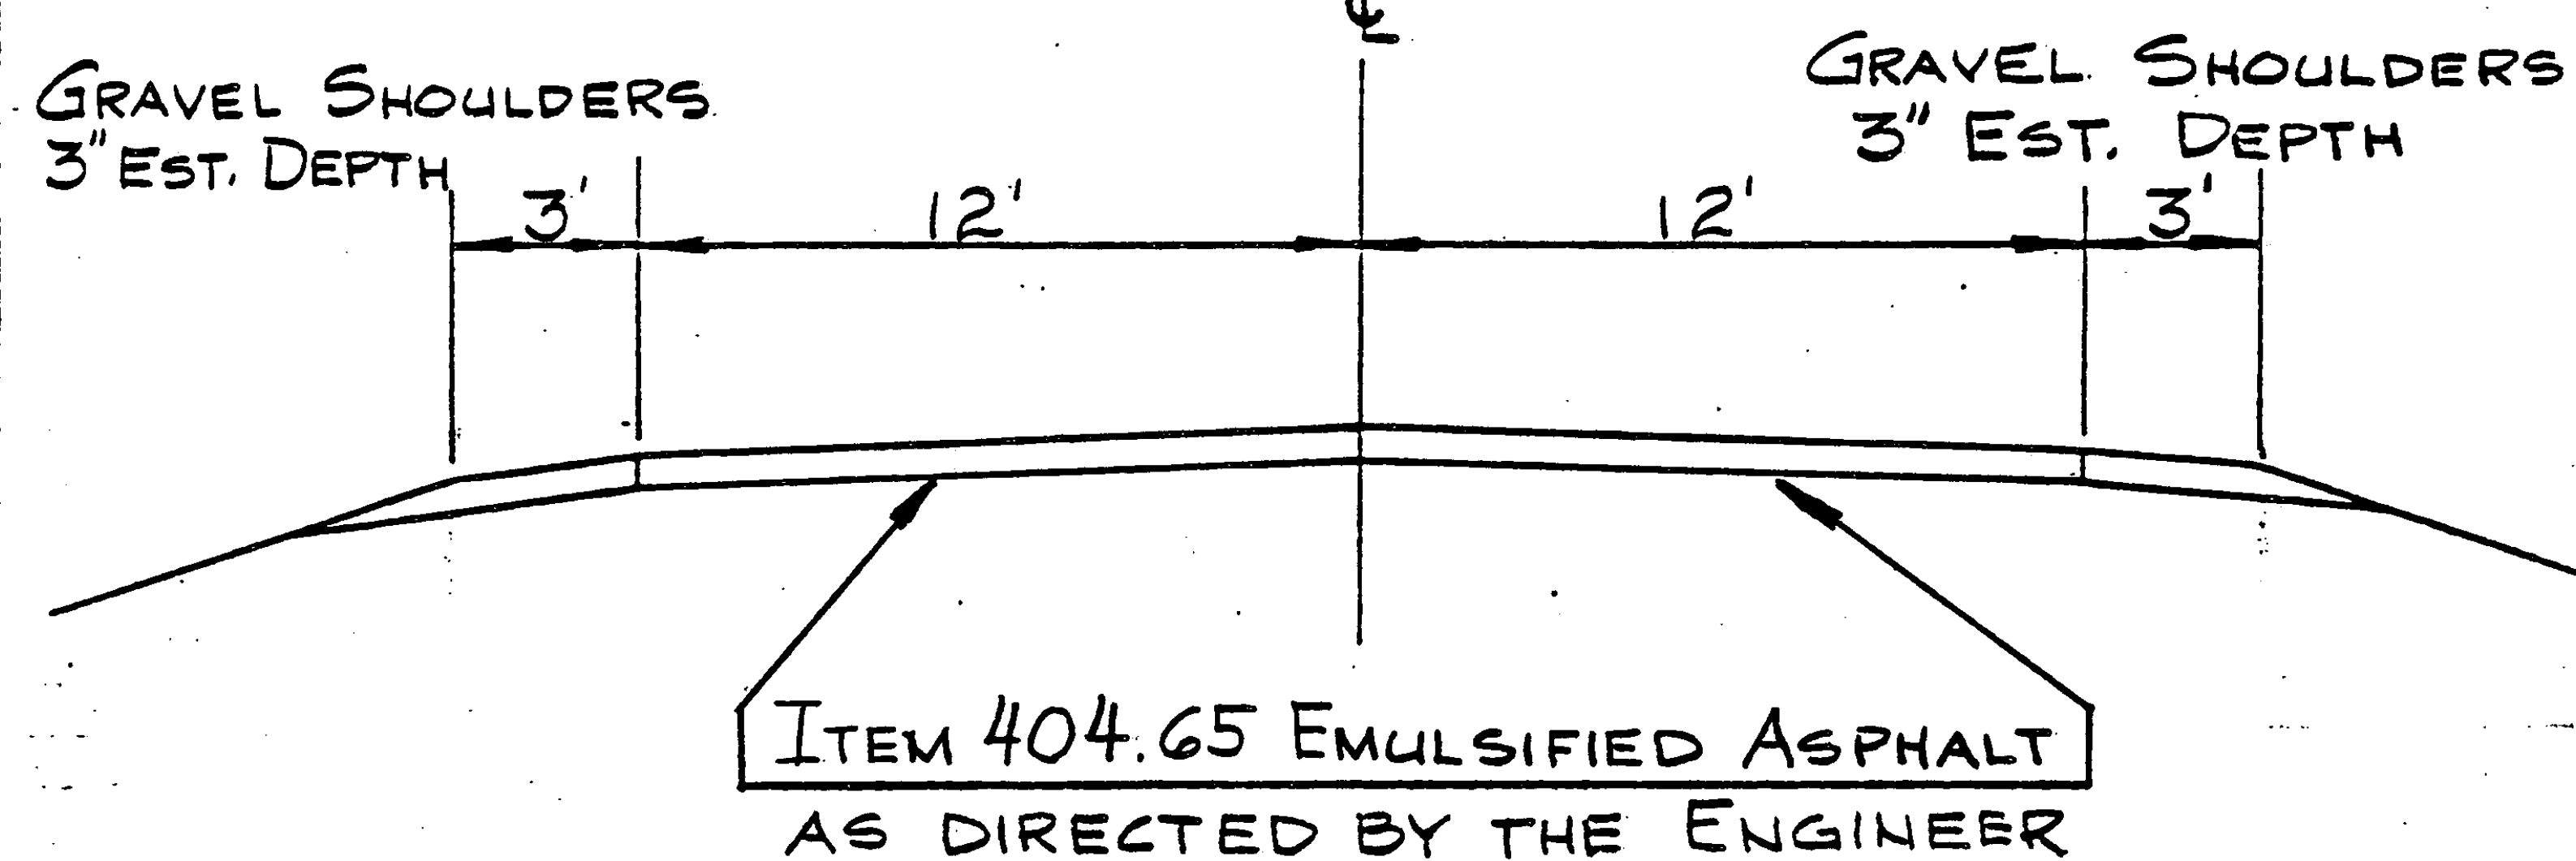

FAIRLEE MM 3.35 ~ 3.860